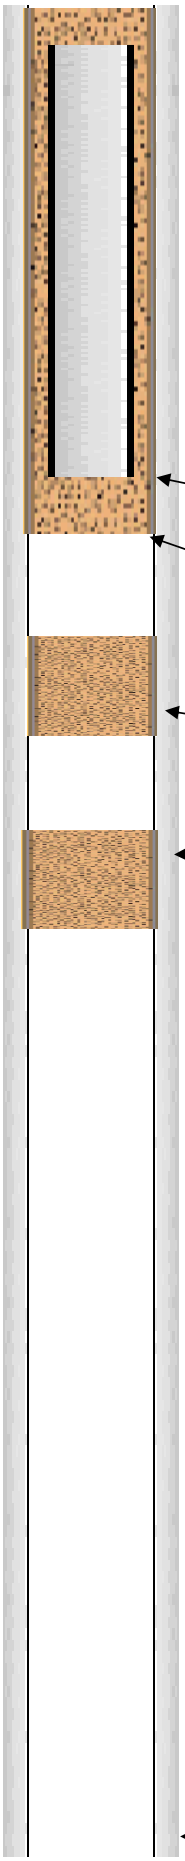

| COMPANY | | | | | DATE | |
|---|---|---|---|---|---|---|
| Schneider Energy Services | | | | | 10/18/18 | |
| LEASE | | | | | | |
| Montague JH #5 | | | | | | |
| CASING | Size | Weight | Grade | Thread | Depth | |
| Surface | 8-5/8" | 22.7# | J-55 | LT&C | 132' | |
| LINER | Size | Weight | Grade | Thread | Depth | |
| | | | | | | |
| drill pipe | First String | Size | Weight | Grade | Thread | Depth |
| | Second String | Size | Weight | Grade | Thread | Depth |
| Prepared for: | | | Perforations: | | | |

| ITEM No# | Length | Description | ID | OD | Depth |
|---|---|---|---|---|---|
| 1 | | 8-5/8", 22.7# Surface casing cement with 100 sacks of cement. | | | |
| 2 | | 50 sack cement plug 185' - 0' | | | |
| 3 | | 40 sack cement plug at 1000' - 865' | | | |
| 4 | | 40 sack cement plug at 1791' - 1654' | | | |
| | | TD 5,143' | | | |

| PREPARED BY | PHONE: | |
|---|---|---|
| Jeff Schneider | 970-867-9437 | |
| **OFFICE** | **PHONE** | **INVOICE #** |
| Fort Morgan, CO | | |