




00064857

CERTIFICATE OF SURVEY
for
Patrick A. Doheny
Washington County, Colorado

RECEIVED

MAR 20 1974

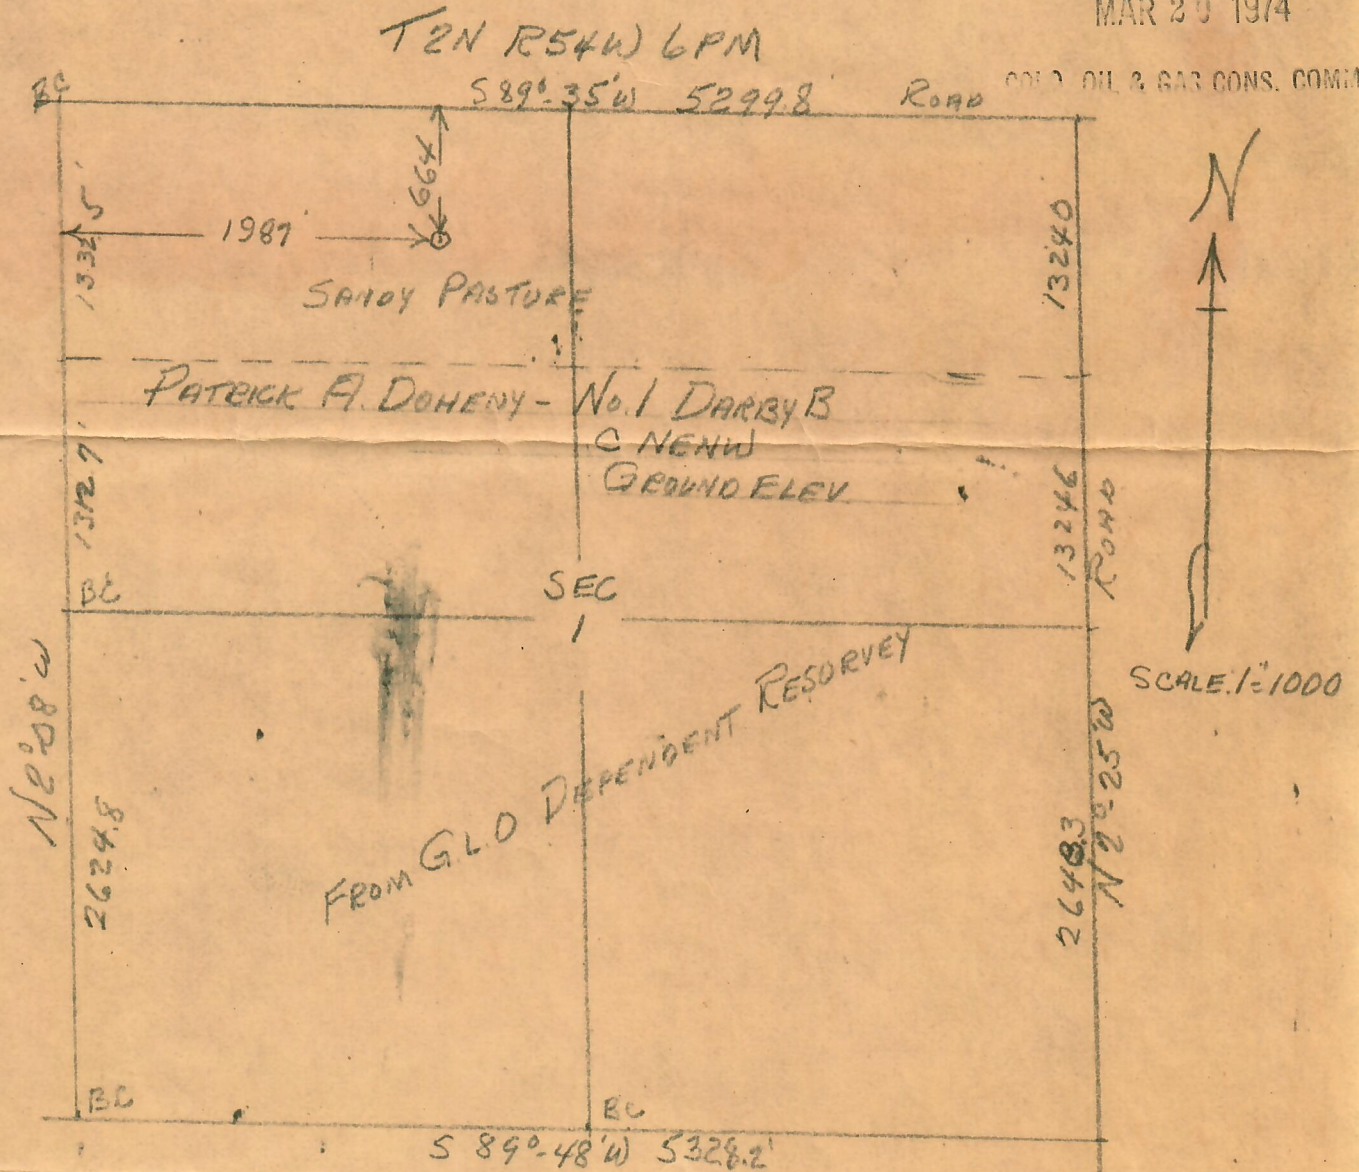

I hereby certify that the above plat is an accurate representation of a correct survey showing the location of Patrick A. Doheny - No. 1 Darby B Oilwell in C NE NW Sec. 1 T2N R54W 6PM. The elevation of the ground at the stake is 4468.2 feet above sea level from U.S.C.&G. Bench Mark.

Fort Morgan, Colorado
March 5, 1974

Cecil J. Calhoun
Registered Professional Engineer
State of Colorado

74-103