


BEST IMAGE
AVAILABLE

CERTIFICATE OF SURVEY
for
Kingwood Oil Co.

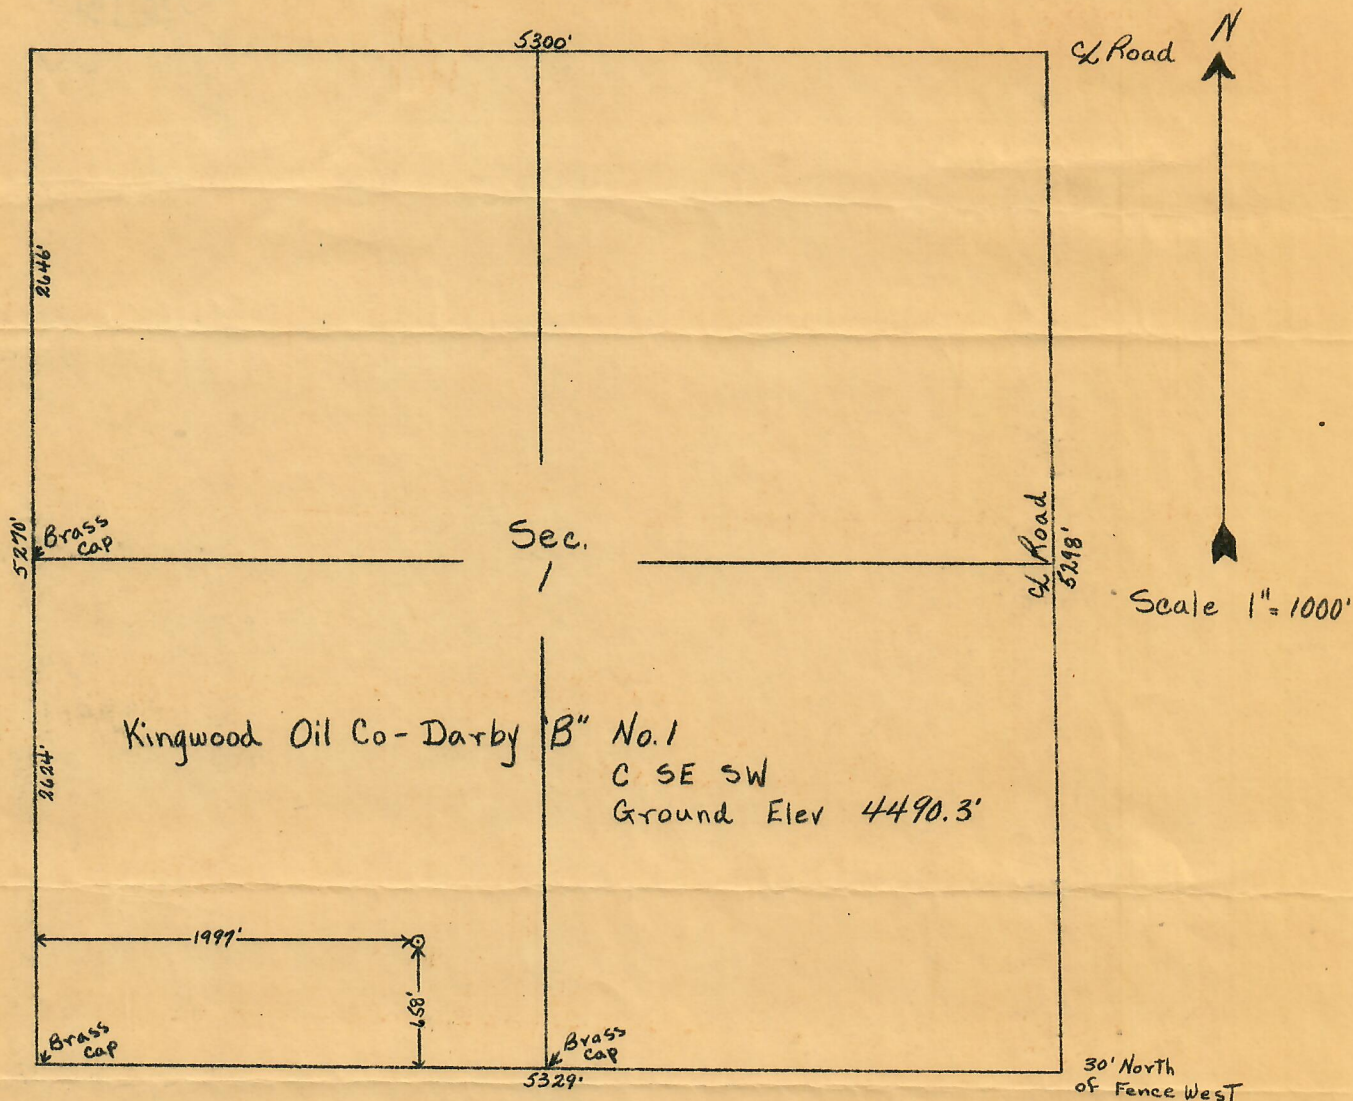

T2N R54W 6 P.M.



I hereby certify that the above plat is an accurate representation of a correct survey showing the location of Kingwood Oil Co.-Darby "B" No. 1 Oilwell located in the CSE 1/4 SW 1/4 Sec. 1 T2N R54W 6 P.M. The elevation of the ground at the stake is 4490.3 feet above sea level from U.S.C.&G. Bench Mark.

Fort Morgan, Colorado
November 23, 1955

Leslie J. Robinson
Registered Professional Engineer
State of Colorado