


00064873

CERTIFICATE OF SURVEY  
for  
Patrick A. Doheny  
Washington County, Colorado

RECEIVED

MAR 20 1974

COLO. OIL & GAS CONS. COMM.

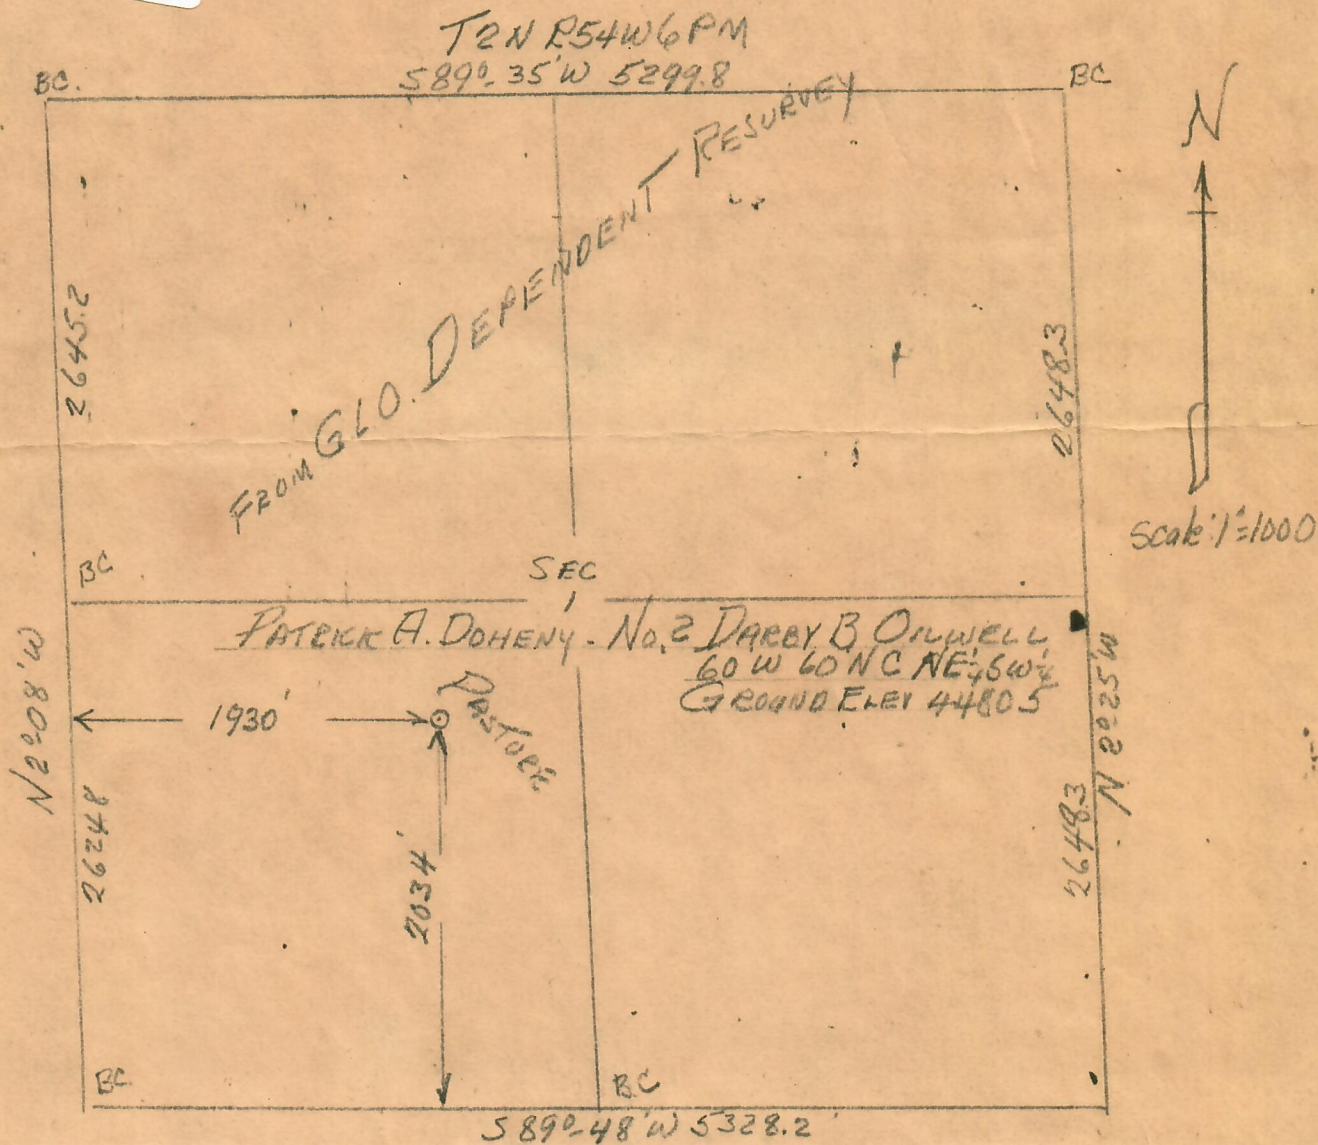

I hereby certify that the above plat is an accurate representation of a correct survey showing the location of Patrick A. Doheny-No. 2 Darby B Oilwell 60 feet west and 60 feet north of C NE 1/4 SW 1/4 Sec. 1 T2N R54W 6PM. The elevation of the ground at the stake is 4480.5 feet above sea level from U.S.C.&G. Bench Mark.

Fort Morgan, Colorado  
March 18, 1974

*Reed J. Osborne*  
Registered Professional Engineer  
State of Colorado

74-136