


M:\CLIENTS\HIGGINS\WCC\CREDO-RESULTS-DWG-LAYOUT1 10/03/2006 9:15AM

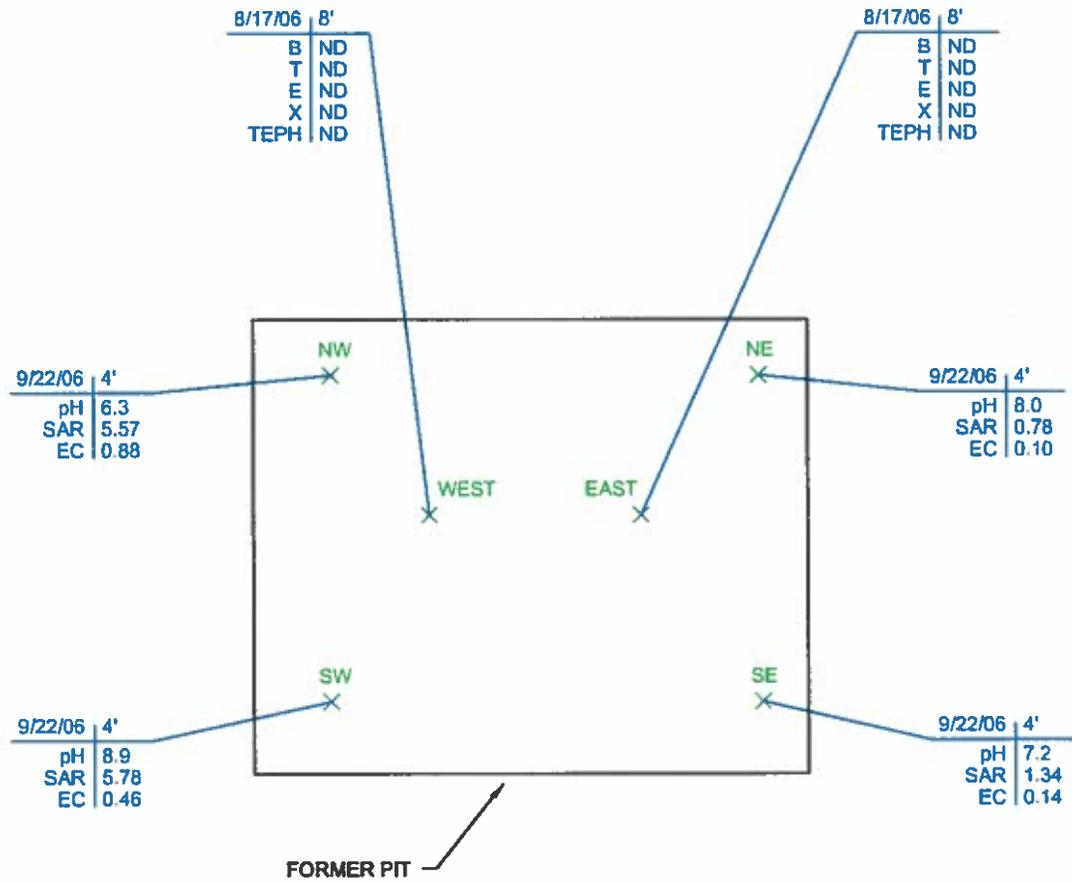

LEGEND

X SOIL SAMPLE LOCATION

CHEMICAL DATA

- B = BENZENE (µg/l)
- T = TOLUENE (µg/l)
- E = ETHYLBENZENE (µg/l)
- X = XYLENES (µg/l)
- TEPH = TOTAL EXTRACTABLE PETROLEUM HYDROCARBONS (µg/l)
- SAR = SODIUM ABSORTION RATIO
- EC = ELECTRICAL CONDUCTIVITY (MMHOS/CM)
- (ND) = NOT DETECTED

8/17/06 | 4' — DATE OF SAMPLE
 | — DEPTH OF SAMPLE



NOT TO SCALE

HIGGINS AND ASSOCIATES, L.L.C.	
Project No.:	Date Map Generated: 10/3/06
Date Data Collected:	Figure No. 2
Authorized: NMF	SOIL RESULTS
Checked: NMF	TIMPE PIT CLOSURE-FACILITY #227150
Detailed: R.J.V	CREDO PETROLEUM CORPORATION
Client: Western Cleanup Corp.	SWSE SECTION 6, T1N-R56W
ACAD File: Credo-results.dwg	Location: Morgan, County