

Stansfield 1-35


API # 05-125-06560

Plugged Wellbore Configuration



Surface

<- Surface Casing Cut 4' Below GL

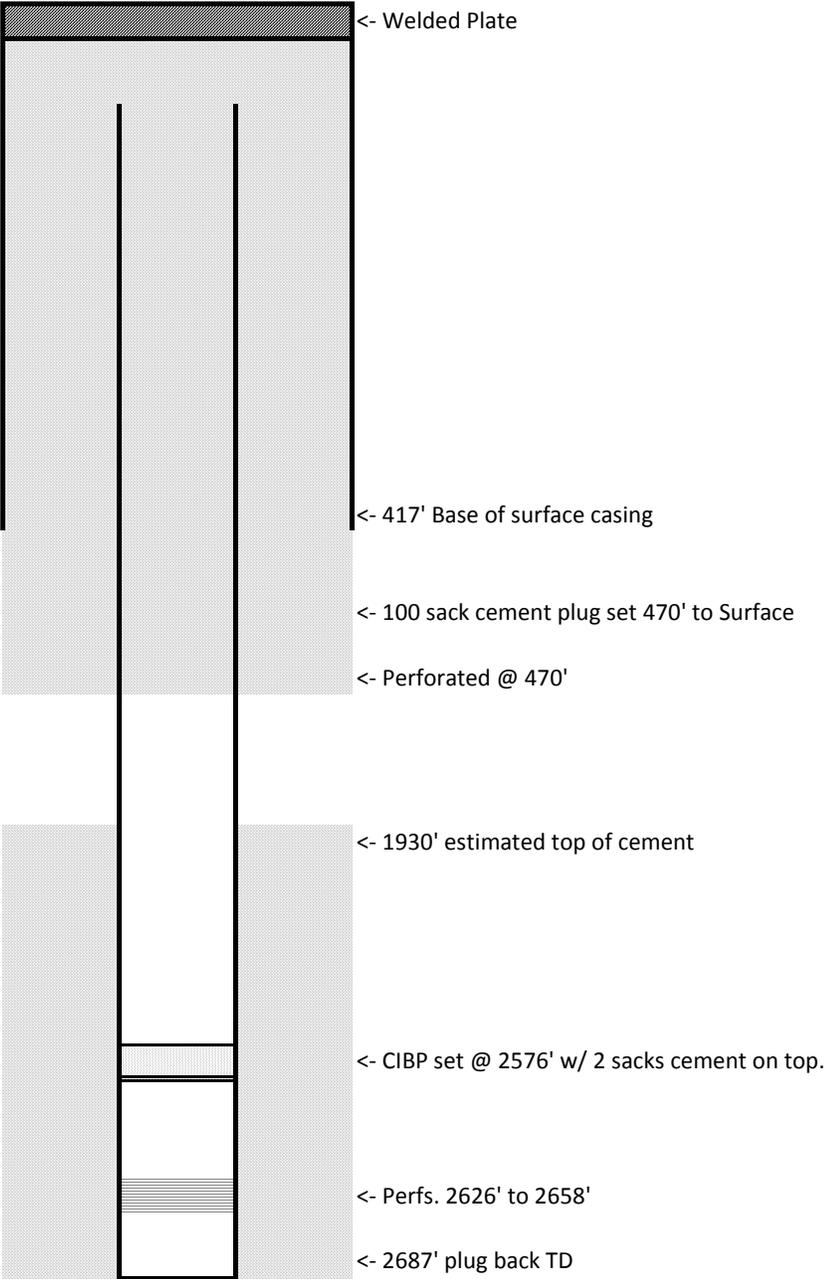

<- Welded Plate

<- 417' Base of surface casing

<- 100 sack cement plug set 470' to Surface

<- Perforated @ 470'

<- 1930' estimated top of cement

<- CIBP set @ 2576' w/ 2 sacks cement on top.

<- Perfs. 2626' to 2658'

<- 2687' plug back TD