Whiting Oil & Gas Corp
1700 Broadway, Suite 2300
Denver, CO 80290
(303) 837-1661

NELSON RANCHES 2

Well Name	API Number	County
NELSON RANCHES 2	051230955400	Weld

Section	Township	Township N/S Dir	Range	Range E/W Dir	Meridian	Quarter 1	Quarter 2
7	10	N	58	W		SW	NW

Vertical - Original Hole, 10/31/2018 2:59:26 PM

Vertical schematic (actual)

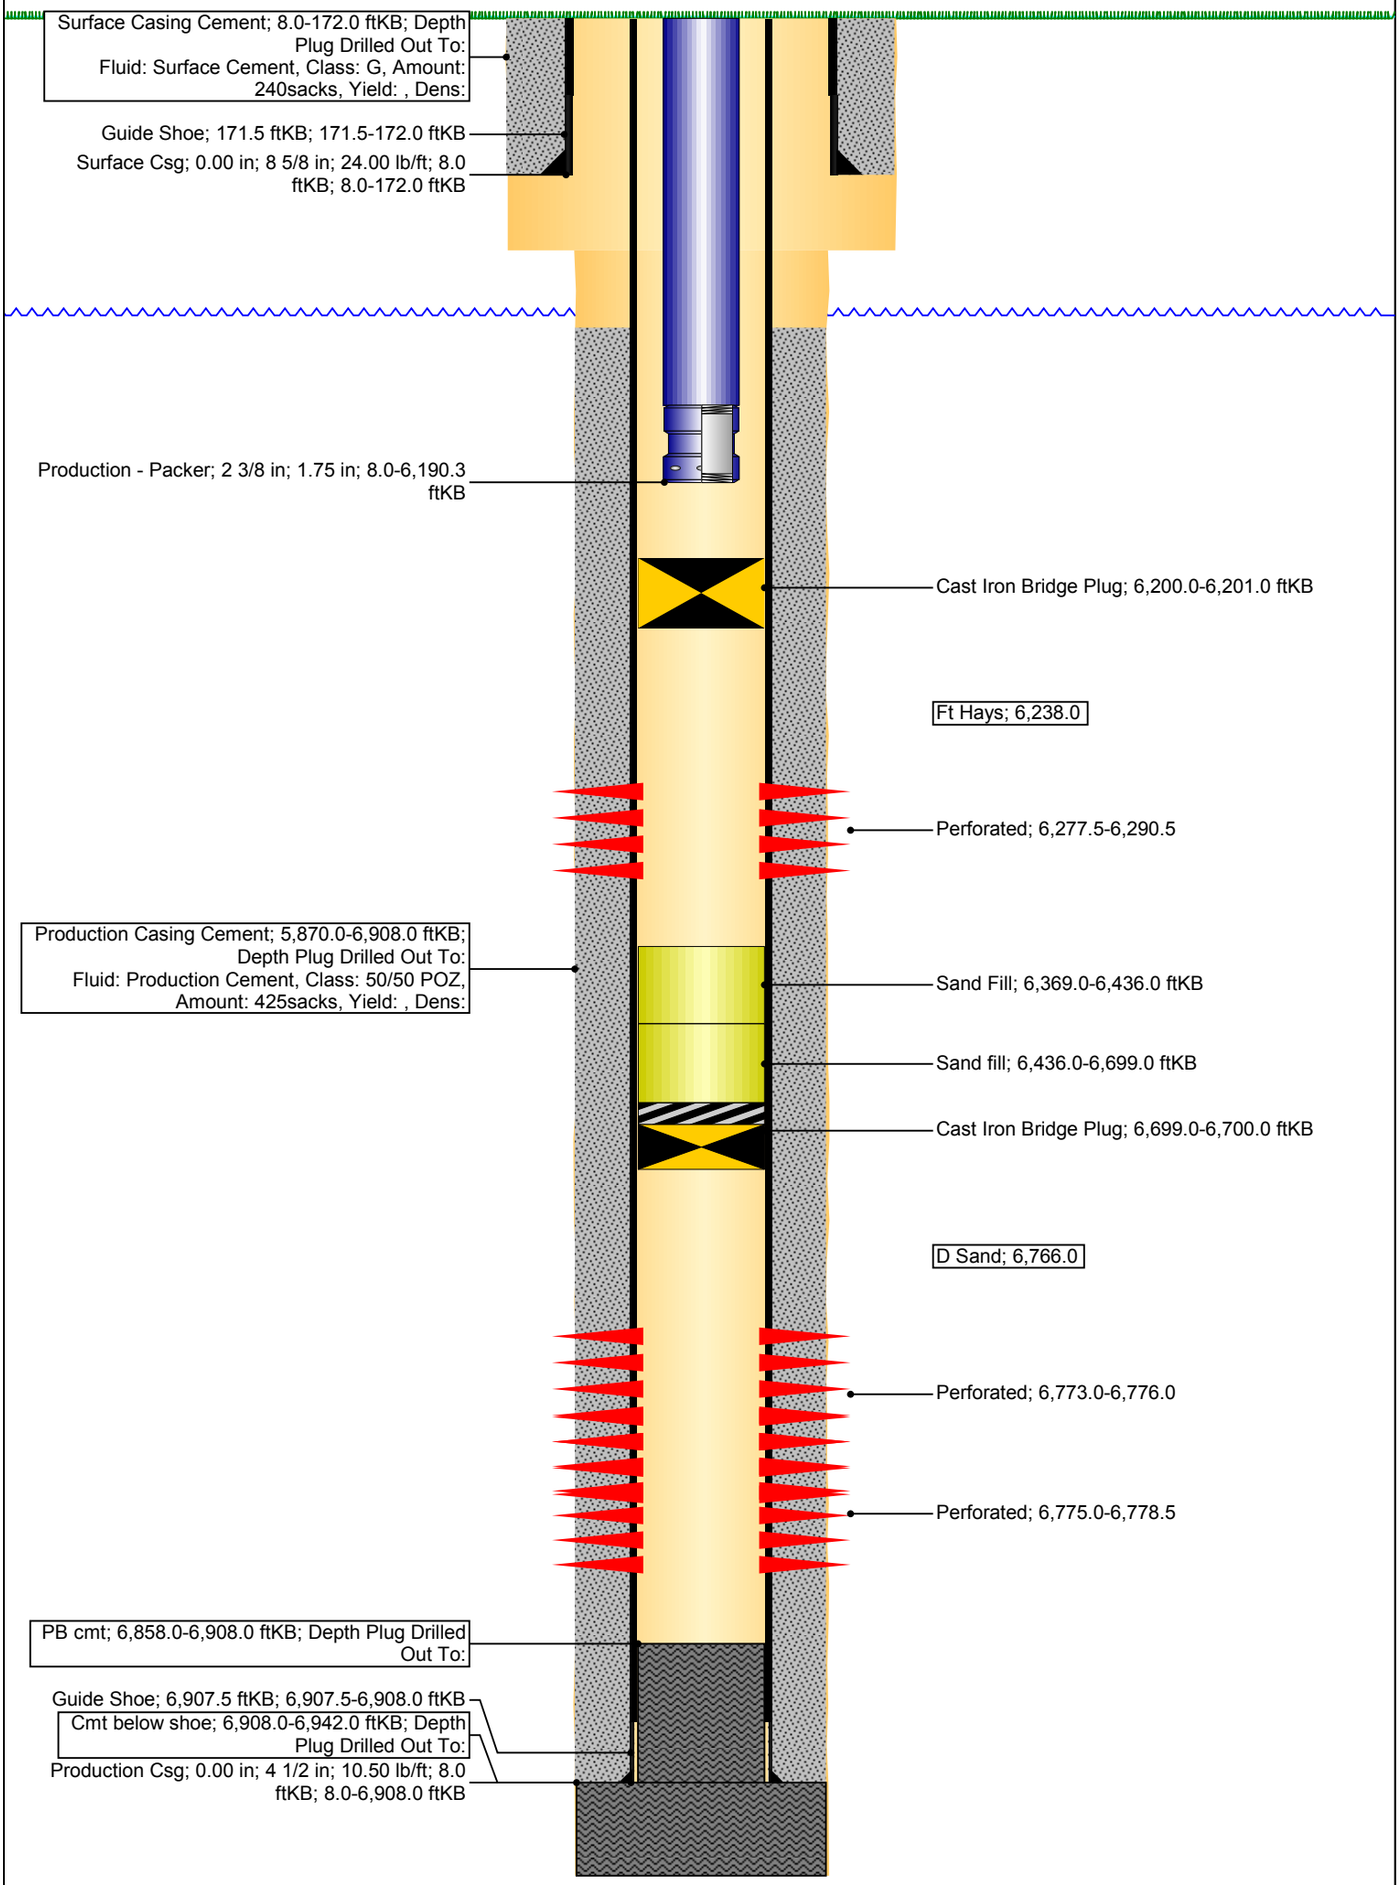

Report Date: 10/31/2018