


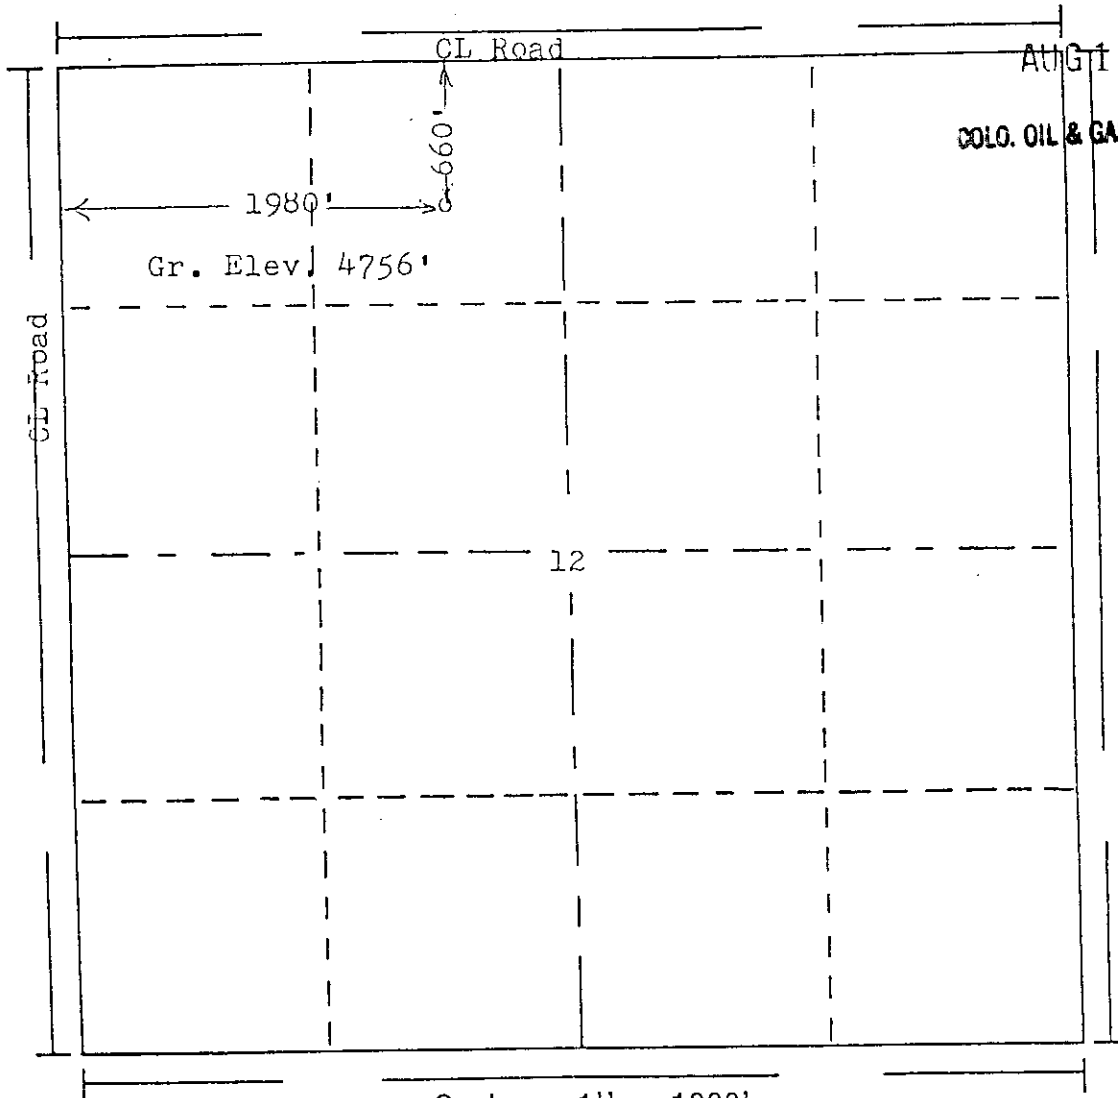

R. 58W

RECEIVED N




Aug 15 1986

COLO. OIL & GAS CONS. COMM.

T.
7
N

Scale --- 1" = 1000'

In accordance with a request from Cache Exploration, Inc.
determined the location of CEI-LRB NO.1 (Re-entry)
to be 660' FN & 1980' FW as co-ordinates
Section 12 Township 7N Range 58W of the 6th principal Meridian
Weld County, Colorado.

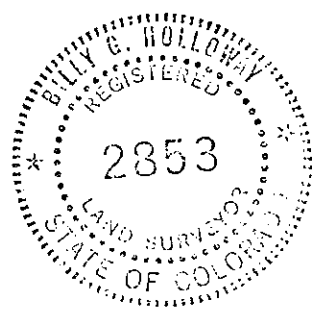

I hereby certify that this oil and/or gas well location certificate was prepared for Cache Exploration, Inc. that it is not a land survey plat or improvement survey plat, and except for the well location, no improvements or easements or encroachments are shown; and that it is not to be relied upon for the establishment of fence, building or other future improvement lines.



Date: July 5, 1986 *Billy G. Holloway*
Licensed Land Surveyor No. 2853
State of Colorado