


**Well Name: CADE STATE O36-19**

VERTICAL, ORIGINAL HOLE, 11/17/2018 2:06:24 PM

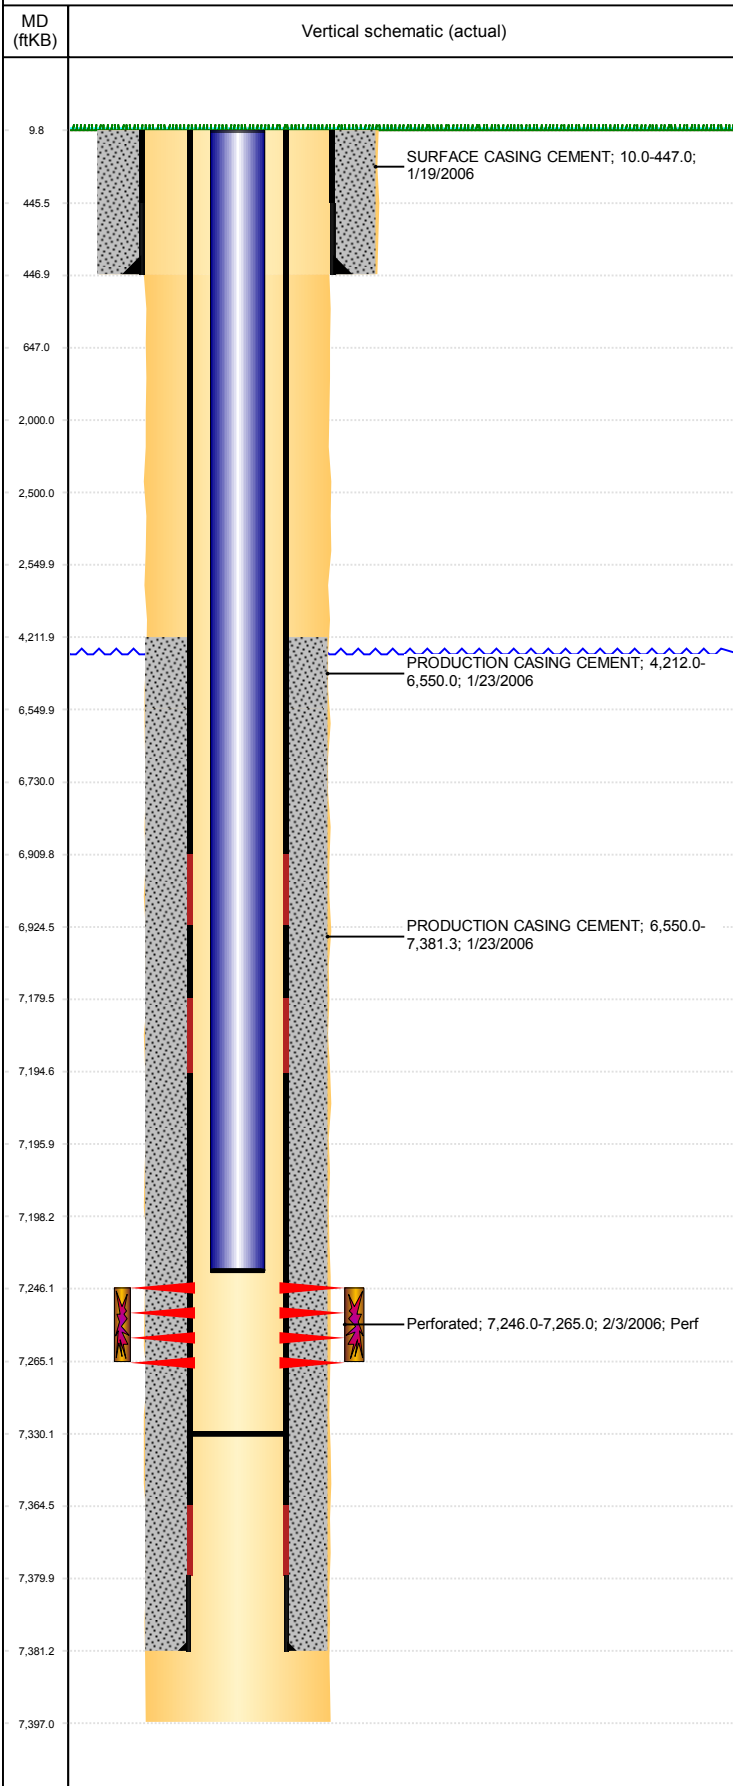

Well Header									
API 05-123-23502		Business Unit DJ BASIN		District 15		Well Config VERTICAL			
KB - GL / MSL (ft... 10.00		Spud Date 1/19/2006		P & A Date		Well Production Status PR		SoRT No	
Comment COGISS SHOWS SI SINCE 11/2017 9' SUB IN TUBING									
Surface Location (Congressional)									
Qtr 3 NW	Qtr 4 NW	Section 36	Twonshp 4	Twonsh... N	Range 67	Rng E/... W	Actual Latitude (°) 40.27240379	Actual Longitude (°) -104.84399628	
Wellbore Sections									
Section Des			Size (in)			Act Top, MD (ftKB)		Act Btm, MD (ftKB)	
SURFACE			12 1/4			10		447	
PRODUCTION			7 7/8			447		7,397	
Casing Strings									
Csg Des			Run Date		OD (in)	Wt/Len (lb/ft)	Grade	Top, MD (ftKB)	MD (ftKB)
Surface			1/19/2006		8 5/8	24.00	J-55	10.0	447.0
Production			1/23/2006		4 1/2	11.60	M-80	10.0	7,381.3
Cement									
Des					Start Date		Top (ftKB)		Btm (ftKB)
SURFACE CASING CEMENT					1/19/2006		10.0		447.0
PRODUCTION CASING CEMENT					1/23/2006		4,212.0		6,550.0
PRODUCTION CASING CEMENT					1/23/2006		6,550.0		7,381.3
Zone Statuses									
Zone Name		Status Date	Status	Fluid Type	Job			Prod Method	
CODELL		2/28/2006	PR		DRILLING/COMPLETION - ORIGINAL, 1/19/2006...			Flowing	
Perforation Data									
Linked Zone			Bnch/Stg	Entered Shot Total	Top (ftKB)		Btm (ftKB)		Date
CODELL, ORIGINAL HOLE				76	7,246.00		7,265.00		2/3/2006
Stimulation Intervals									
Zone					Start Date		Top (ftKB)		Btm (ftKB)
CODELL, ORIGINAL HOLE					2/16/2006		7,246.0		7,265.0
Other In Hole									
Run Date		Des				OD (in)	Top (ftKB)		Btm (ftKB)
Logs									
Date		Type					Top, MD (ftKB)		Btm, MD (ftKB)
1/24/2006		COMPENSATED DENSITY					2,390.0		7,370.0
1/24/2006		INDUCTION					447.0		7,390.0
2/3/2006		CEMENT BOND					4,100.0		7,329.0
6/7/2018		GYRO					10.0		7,100.0
Plug Back Total Depths									
Date		Type		Com					Depth (ftKB)
1/23/2006		FLOAT COLLAR		TOP OF FLOAT COLLAR					7,364.0
2/3/2006		FILL		DEPTH LOGGER ON CBL					7,330.0