
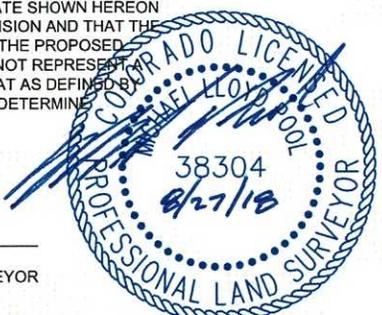


# TROUDT 26N-23B-M WELL LOCATION CERTIFICATE - AS-BUILT

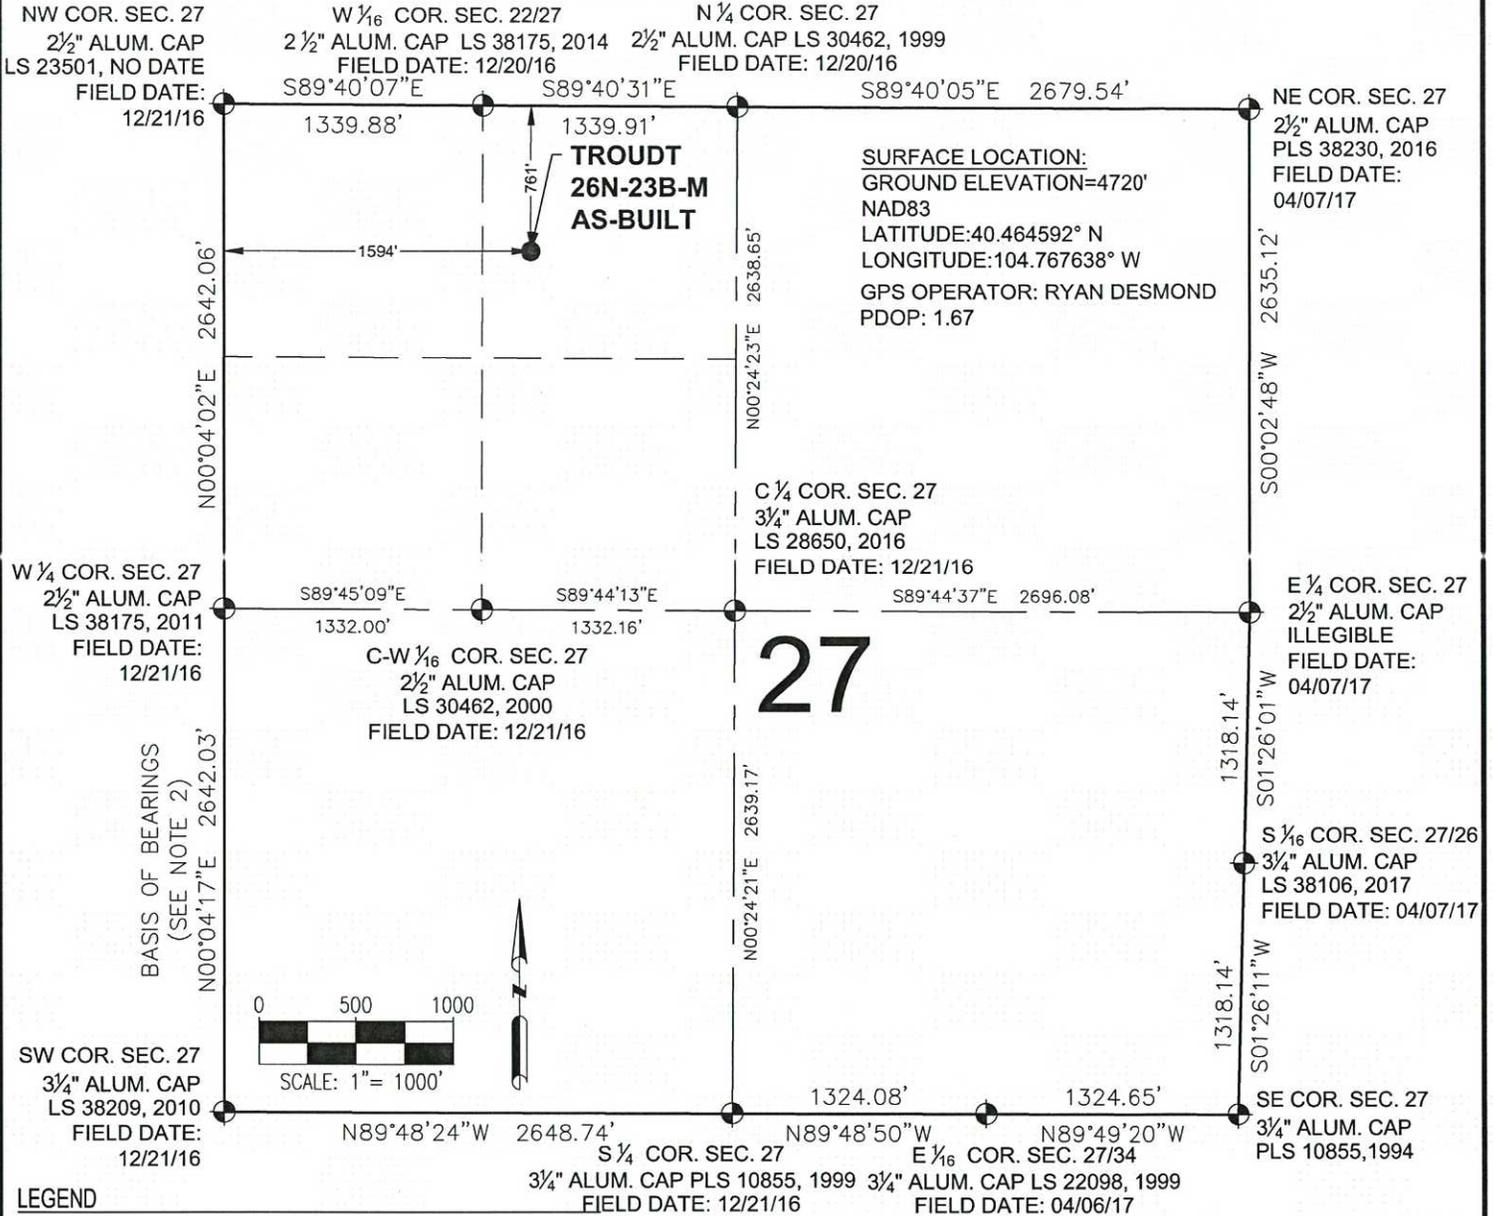

 7535 Hilltop Circle Denver, CO 80221 (303) 928-7128 www.ascentgeomatics.com	FIELD DATE: <b>07-12-18</b>	WELL NAME: <b>TROUDT 26N-23B-M</b>	PREPARED FOR: SRC ENERGY
	DRAWING DATE: <b>08-23-18</b>	SURFACE LOCATION: NE 1/4 NW 1/4 SEC. 27, T6N, R66W, 6TH P.M. WELD COUNTY, COLORADO	
BY: SJH	CHECKED BY: CSG		