




RECEIVED

MAY 4 1972

COLO. OIL & GAS CONS. COMM.


R. 66W

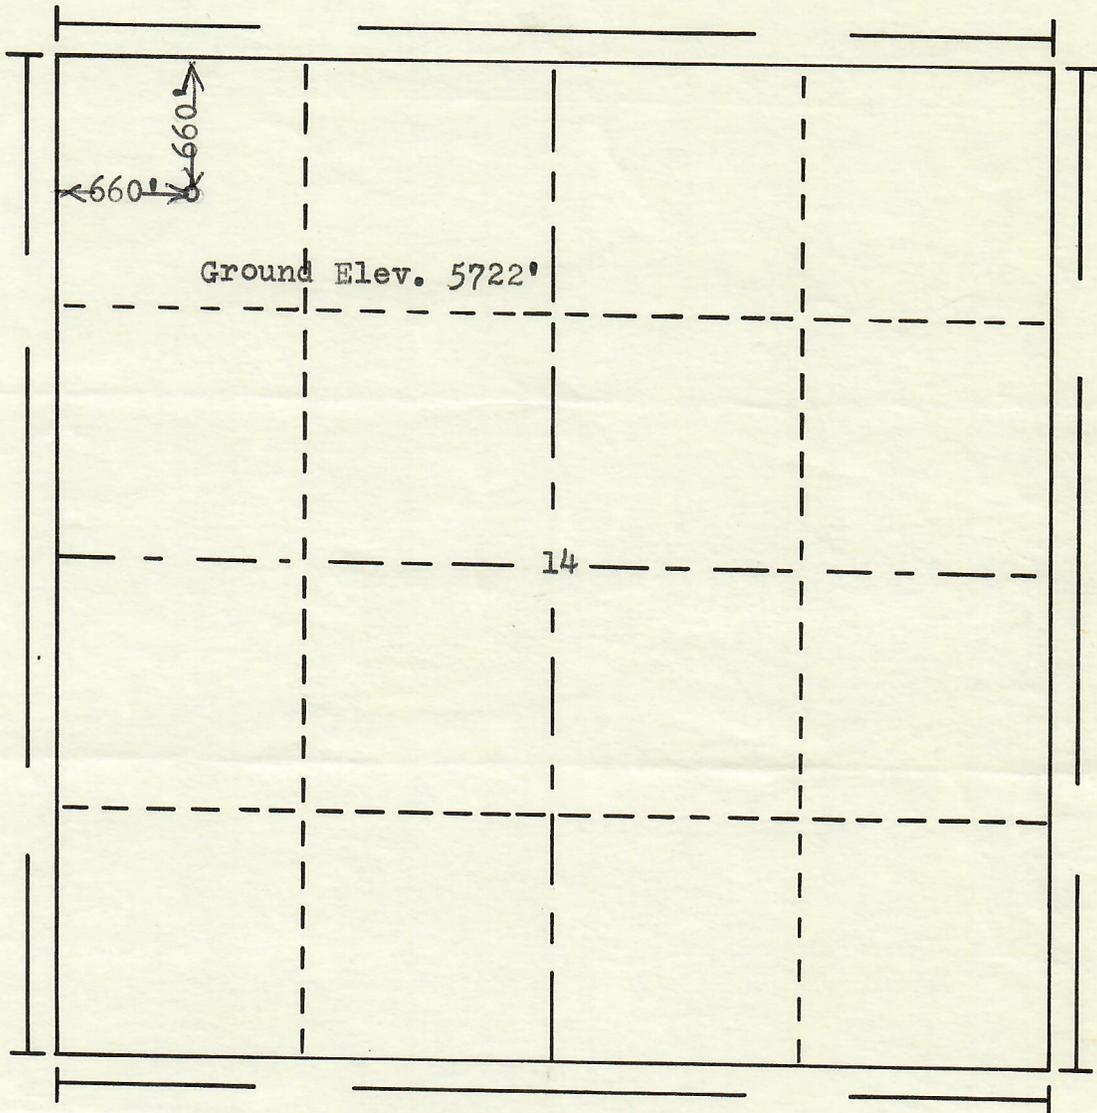

T.
11
N

Scale... 1" = 1000'

Powers Elevation Company, Inc. of Denver, Colorado
 has in accordance with a request from Mr. McIlnay
 for Rainbow Resources Inc.,
 determined the location of No.1-14 Warren Livestock Co.
 to be CNW NW Section 14 Township 11N
 Range 66W of the 6th Principal Meridian
Weld County, Colorado

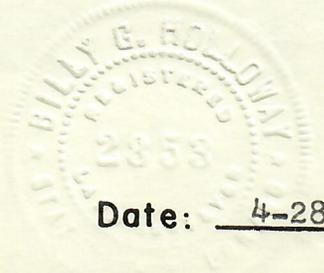

I hereby certify that this plat is an accurate representation of a correct survey showing the location of

Date: 4-28-72

Billy G. Holloway
 Licensed Land Surveyor No. 2853
 State of Colorado