


Attachment #1 – Current Plugged Wellbore Diagram

Well Bangert #31-19
Operator EnCana Energy Resources Inc.
Location NE NE Section 19-T2N-R66W
County Weld
State Colorado
Field Wattenberg
Footages 465' FNL & 655' FEL Section 19
BHL 97' FSL & 1547' FEL Section 18
Spud Date 04/05/2003
TD Date 04/10/2003
Completion Date 04/17/2003

Log Tops

Sussex 4340'
 Niobrara 7113'
 Codell 7396'
 J 2 Sand 7848'
 Skull Creek 7949'
 TD 8137'

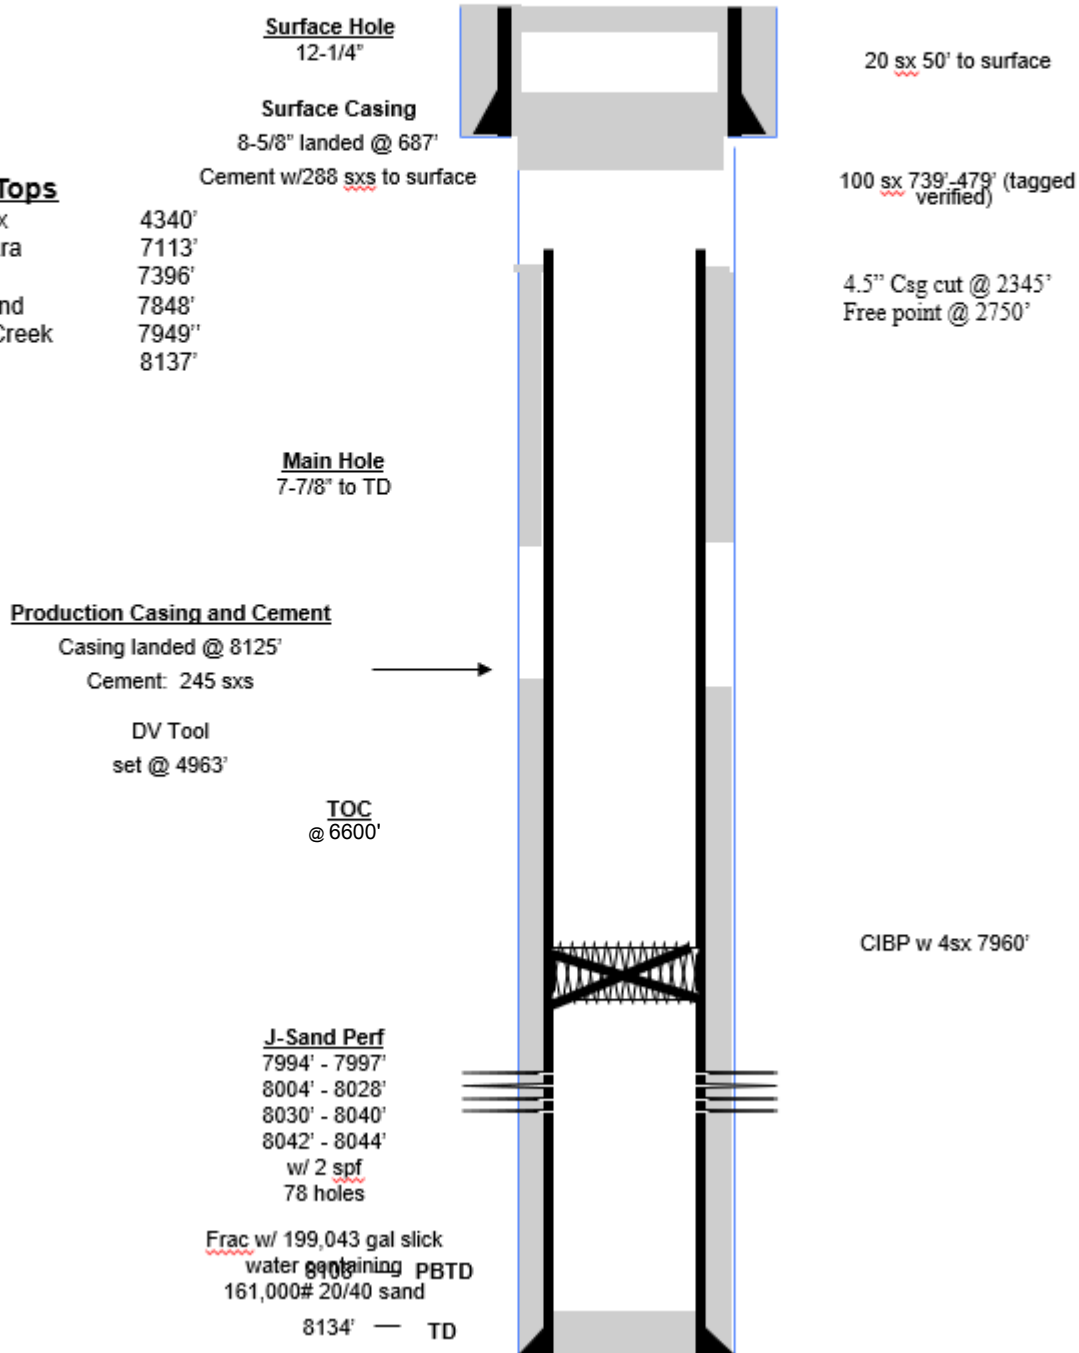

Attachment #2 – Proposed Plugged Wellbore Diagram

Well

Operator EnCana Energy Resources Inc.
 API# 05-123-21065
 Location NE NE Section 19-T2N-R66W
 County Weld
 State Colorado
 Field Wattenberg
 Footages 465' FNL & 655' FEL Section 19
 BHL 97' FSL & 1547' FEL Section 18
 Spud Date 04/05/2003
 TD Date 04/10/2003
 Completion Date 04/17/2003

Bangert #31-19

Log Tops

Fox Hills	652'
Deepest ww	722'
Sussex	4340'
Niobrara	7113'
Codell	7396'
J 2 Sand	7848'
Skull Creek	7949'
TD	8137'

