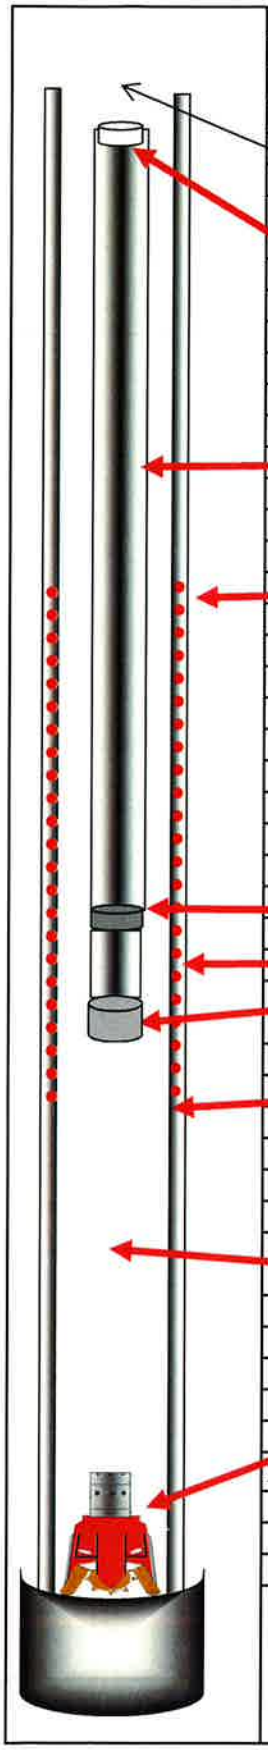

COMPANY	Laramie Energy LLC	05-077-10477-0000	CASING	LINER	TUBING
WELL NAME	Bruton 30-17E	SIZE:	4.5		2.375
FIELD	Bruton 30-10	WEIGHT:	11#		4.7#
COUNTY	MESA	GRADE:			L80
STATE	COLORADO	THREAD:			8rd EUE
DATE	Thursday, November 01, 2018	DEPTH:		EOT w/KB	7,425.88

ITEM	DESCRIPTION	OD	ID	LENGTH FEET
	K.B.			30.00
	Tubing Hanger Cameron 7 1/16" 5 K Hanger	7.063	1.901	0.86
	236 JTS 2 3/8" 4.7# EUE L-80	2.375	1.901	7,361.88
	TOP PERF 6374'			
	Zones: Cameo, Williams Fork			
	Baker F-Nipple 1.810"	3.125	1.810	0.84
	1 JT 2 3/8" 4.7# EUE L-80	2.375	1.901	31.67
	1/2 POBS	3.250	2.000	0.63
	BOTTOM PERF 7790'			
	1/2 POBS & 3 3/4" mill @ 7850'			
P.B.T.D		**EOT w/ K.B.**		**7,425.88**

PREPARED FOR: