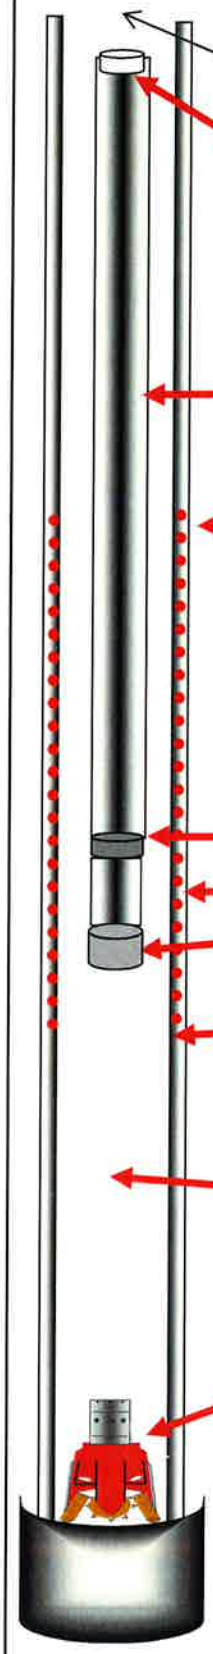

COMPANY	Laramie Energy LLC	05-077-10468-0000	CASING	LINER	TUBING
WELL NAME	Bruton Federal 30-17W	SIZE:	4.5		2.375
FIELD	Bruton 30-10	WEIGHT:	11#		4.7#
COUNTY	MESA	GRADE:			L80
STATE	COLORADO	THREAD:			8rd EUE
DATE	Tuesday, October 30, 2018	DEPTH:		EOT w/KB	7,677.98
					LENGTH
ITEM	DESCRIPTION		OD	ID	FEET
	K.B.				30.00
	Tubing Hanger Cameron 7 1/16" 5 K Hanger		7.063	1.901	0.86
	242 JTS 2 3/8" 4.7# EUE L-80		2.375	1.901	7,614.08
	TOP PERF 6584'				
	Zones: Cameo, Williams Fork				
	Baker F-Nipple 1.810"		3.125	1.810	0.84
	1 JT 2 3/8" 4.7# EUE L-80		2.375	1.901	31.57
	1/2 POBS		3.250	2.000	0.63
	BOTTOM PERF 8058'				
	1/2 POBS & 3 3/4" mill @ 8130'				
P.B.T.D			**EOT w/ K.B.**		**7,677.98**

PREPARED FOR: