

RECEIVED

CERTIFICATE OF SURVEY
for

APR 18 1984




00221282

C.W.I. Oil and Gas Co.
Weld County, Colorado

COLO. OIL & GAS CONS. COMM.

T7N R64W 6PM

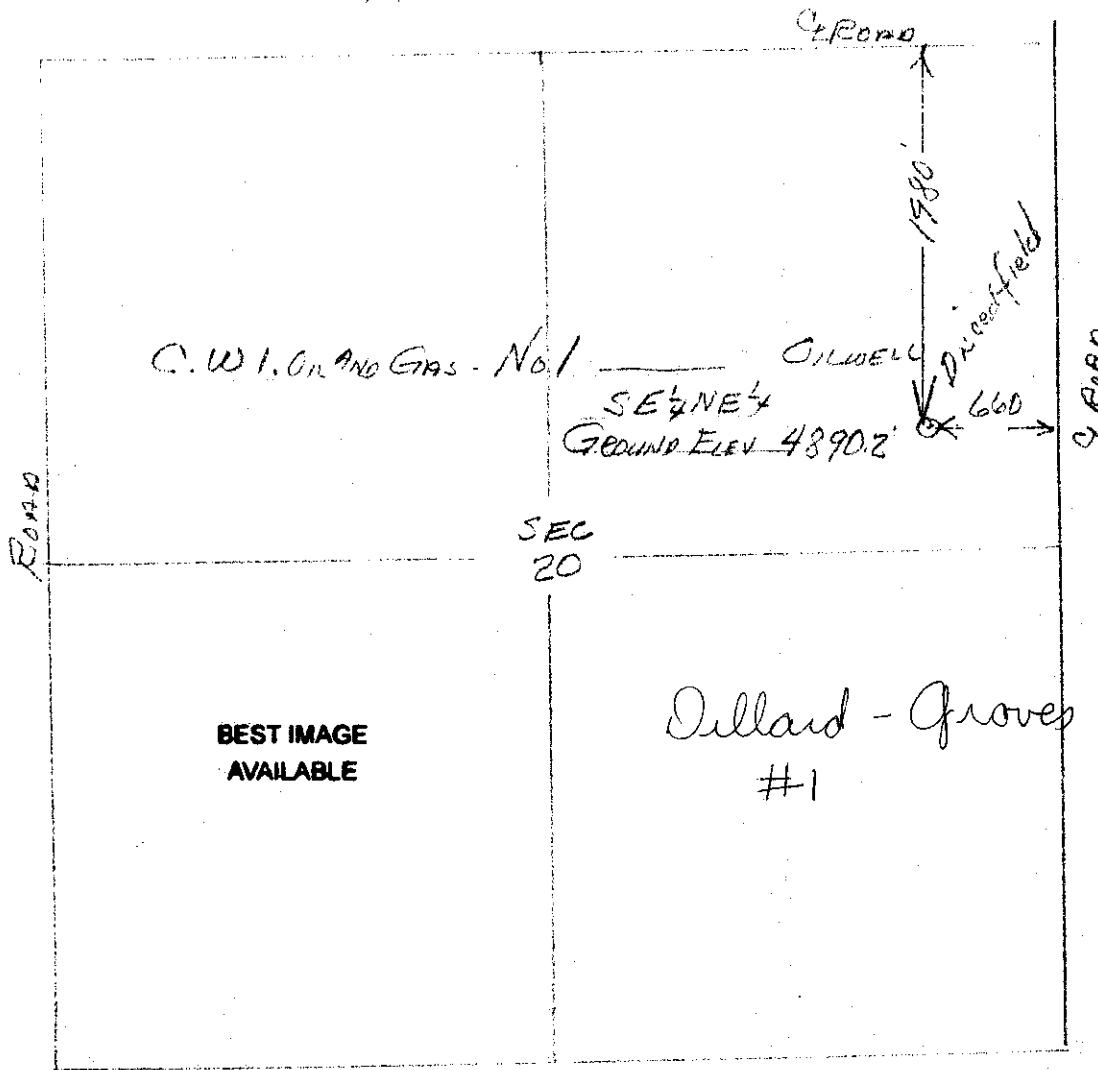

I hereby certify that the above plat is an accurate representation of a correct survey showing the location of C.W.I. Oil and Gas Co.-No. 1 Oilwell in SE 1/4 NE 1/4 Sec. 20 T7N R64W 6PM. The elevation of ground at the stake is 4890.2 feet above sea level from U.S.G.S. Bench Mark.

Fort Morgan, Colorado
Apr 12, 1984

Heath J. Osborne
Registered Professional Engineer
State of Colorado