





CERTIFICATE OF SURVEY
for
Midwest Oil Corp.
Weld County, Colorado

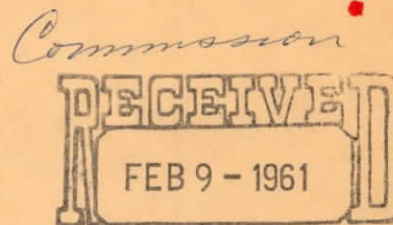

OIL & GAS
CONSERVATION COMMISSION

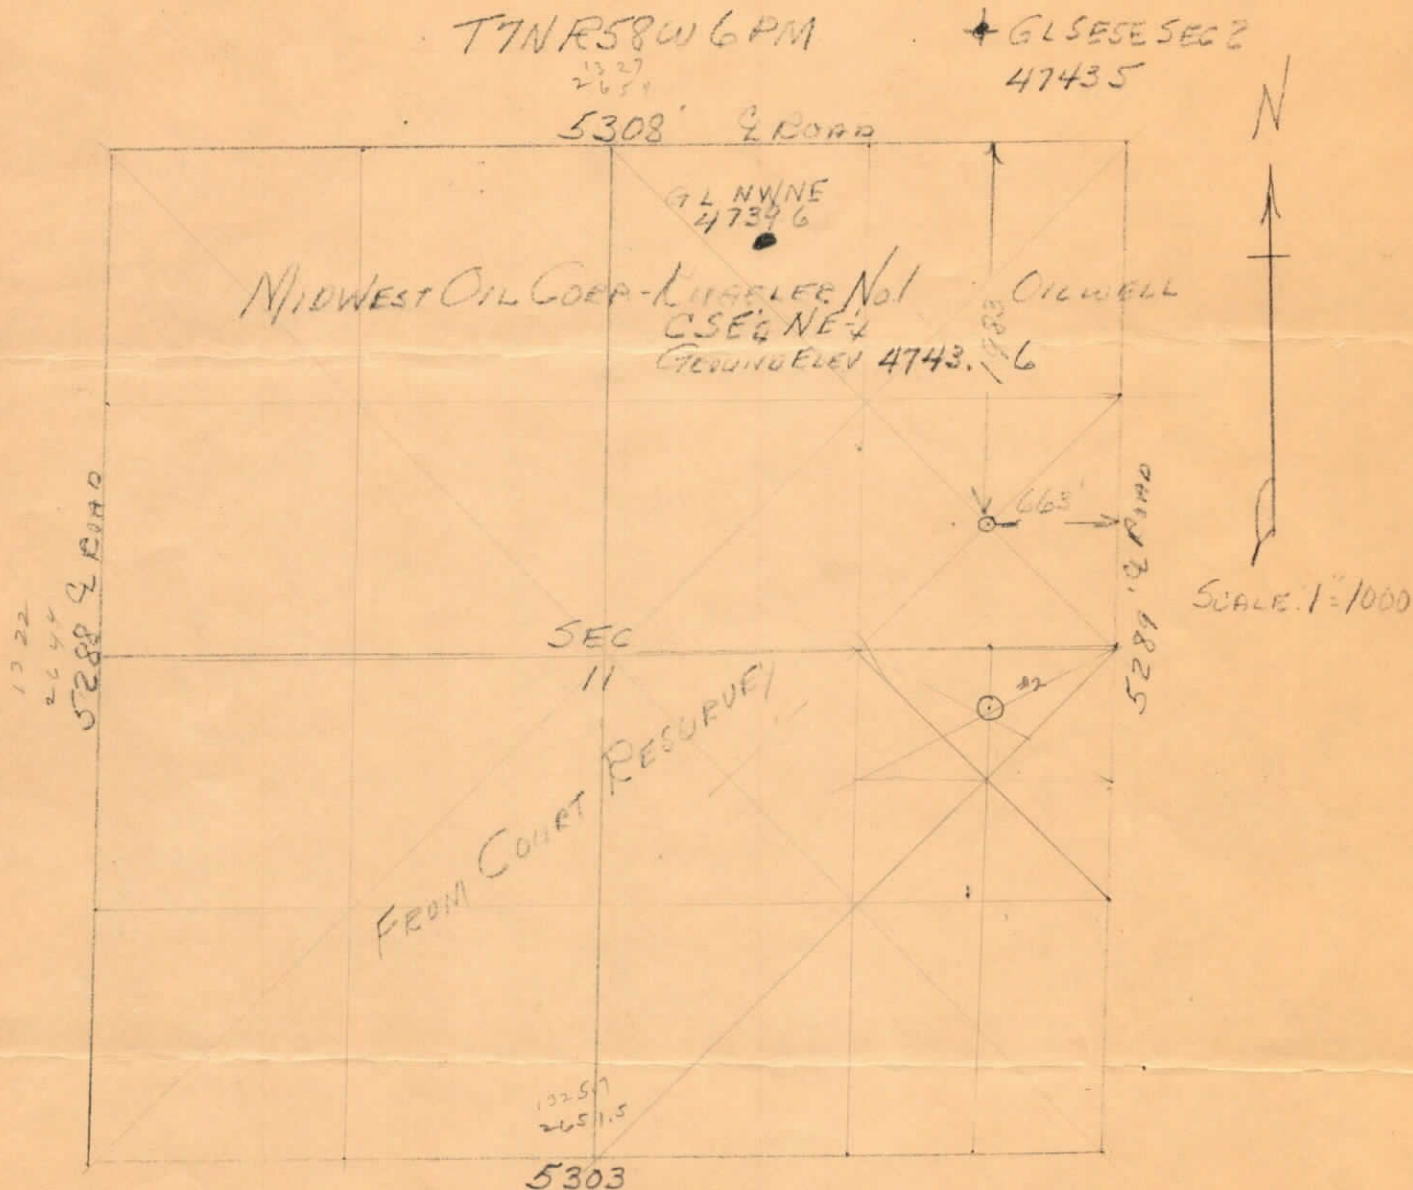

I hereby certify that the above plat is an accurate representation of a correct survey showing the location of Midwest Oil Corp.-Kugeler No.1 Oilwell in C SE 1/4 NE 1/4 Sec. 11 T7N R58W 6PM. The elevation of the ground at the stake is 4743.6 feet above sea level from U.S.C.&G. Bench Mark.

Fort Morgan, Colorado
Feb. 2, 1961

Registered Professional Engineer
State of Colorado.