


WELBORE DIAGRAM: After P&A operations

Company: <u>Ward Petroleum</u>	Well No.: <u>AMEND #1</u>	API: <u>05-001-07215</u>
Lease: _____	Field: <u>WATTENBERG</u>	
Location: <u>SESE, 30, 1S, 66 W, 6TH PM</u>	County: <u>ADAMS</u>	State: <u>COLORADO</u>

WELLHEAD:

Surface Casing

Size: 8-5/8"
 Wght: 23#
 Type:
 Depth: 210'
 Csg ID:
 Csg Drift:
 TOC: SURFACE
 Hole Size: 12-1/4"

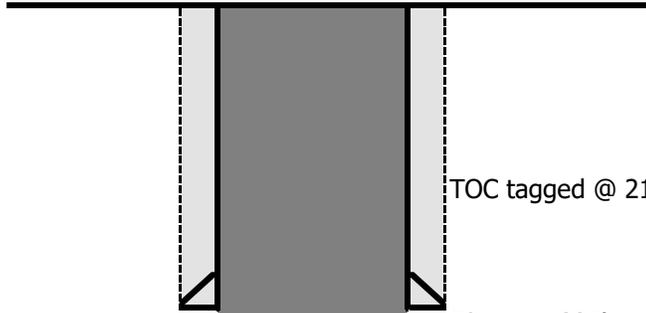


TOC tagged @ 216, PU 1' and circulate 80 sx to surface

50 sxs at 325', tagged

Open Hole

Size: 7-7/8"
 Wght:
 Type:
 Depth: 8310'
 Csg ID:
 Csg Drift:
 TOC:
 Hole Size: 7-7/8"

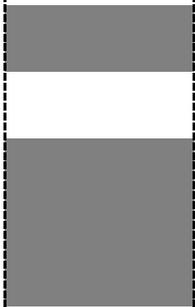


50 sxs at 604'

TOC tagged @ 1040'- Good tag

50 sxs at 1516'

Drill out cement and dried mud to 3,026'

50 sxs at 3,000'

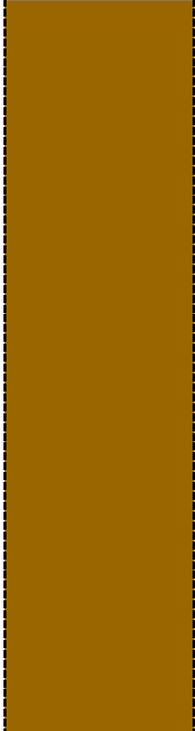

Updated:

By: Marshall Hall

TD: 8,310'