


CERTIFICATE OF SURVEY
for
Parker and Parsley
Weld County, Colorado



00122232

T5N R64W 6PM.

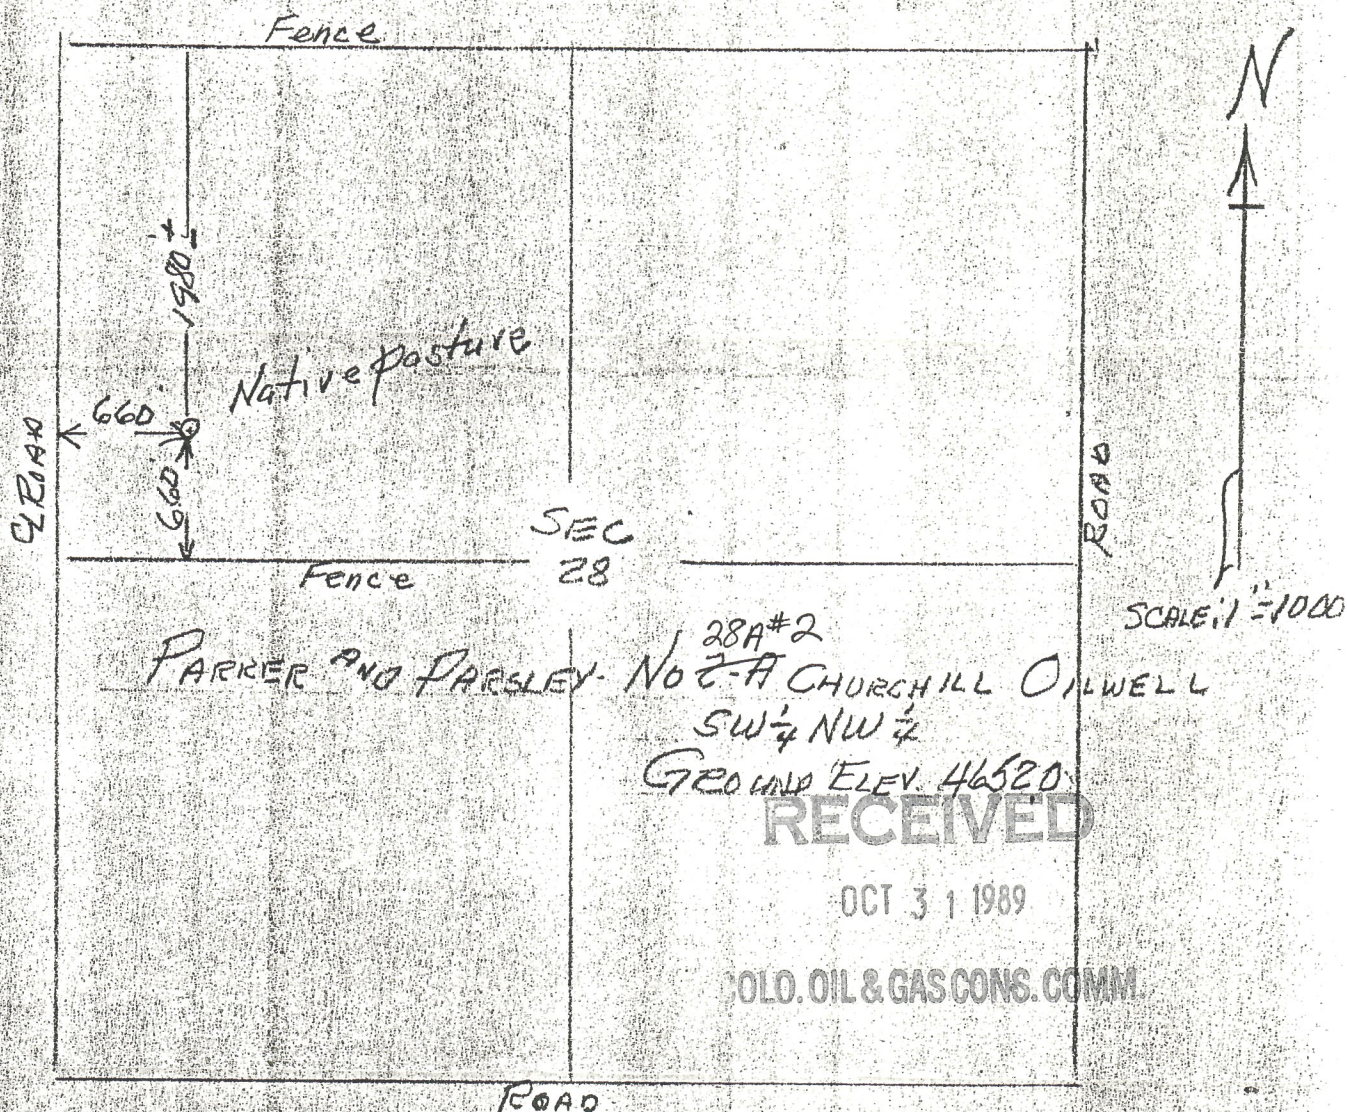

I hereby certify that the above plat is an accurate representation of a correct survey showing the location of Parker and Parsley-No. 2-A 28A#2 Churchill Oilwell in SW 1/4 NW 1/4 Sec. 28 T5N R64W 6PM. The elevation of the ground at the stake is 4652.0 feet above sea level from U.S.G.S. Bench Mark.

Fort Morgan, Colorado
Oct. 23, 1989

David A. Brown
Registered Professional Engineer
State of Colorado