COMPANY: Rio Mesa Resources	LEASE: Carrie Hill #7
PREPARED FOR:	DATE: / PHONE:
PREPARED BY:	STATION: / PHONE:

EQUIPMENT SPECIFICATION
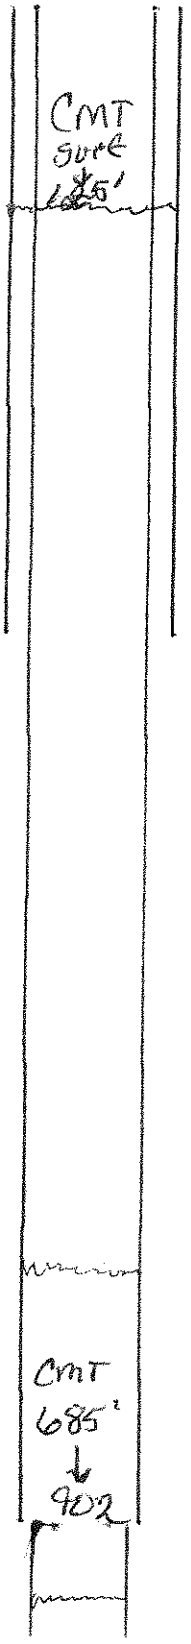
ITEM	DESCRIPTION	I.D.	O.D.	LENGTH	DEPTH
	8 5/8 SET @ 300'				
	7" SET @ 840'				
	OPEN HOLE TO 937'				
	Pump 45 SKS FROM 125				
	1" 8 5/8"				
			8 5/8 Shoe @ 300'		
	TAG Cmt @ 685'				
	(NO TAG) Pump 185KS @ 902				
	Pump 50 SKS @ 902'				
			7" Shoe @	840'