


DOW 21-28
Final P&A WBD

660 FNL 1980 FWL NENW 28 5N 63W 6th PM
Lat 40.37597 Long -104.44314
Weld County, Colorado
API #05-123-20383

Spud date 4/27/2001

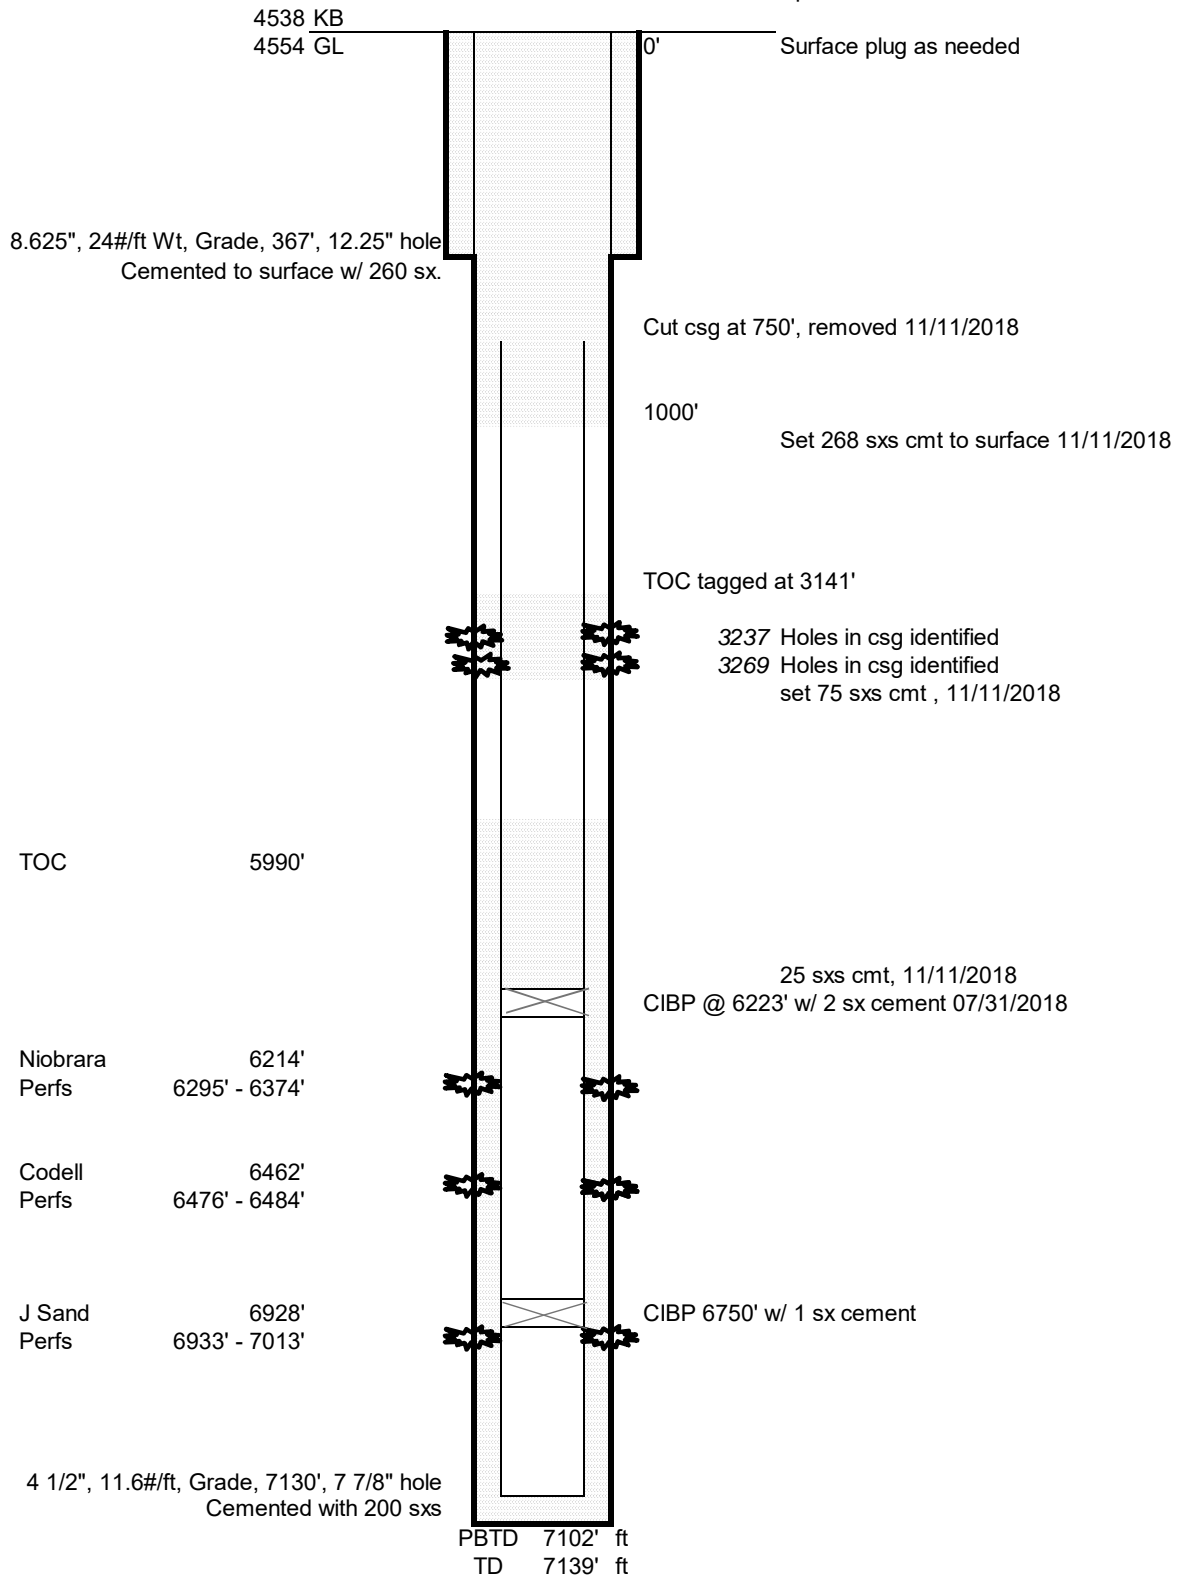

Updated 12/18/2018 AN