


CERTIFICATE OF SURVEY  
for  
Tower Drilling Co.  
Weld County, Colorado

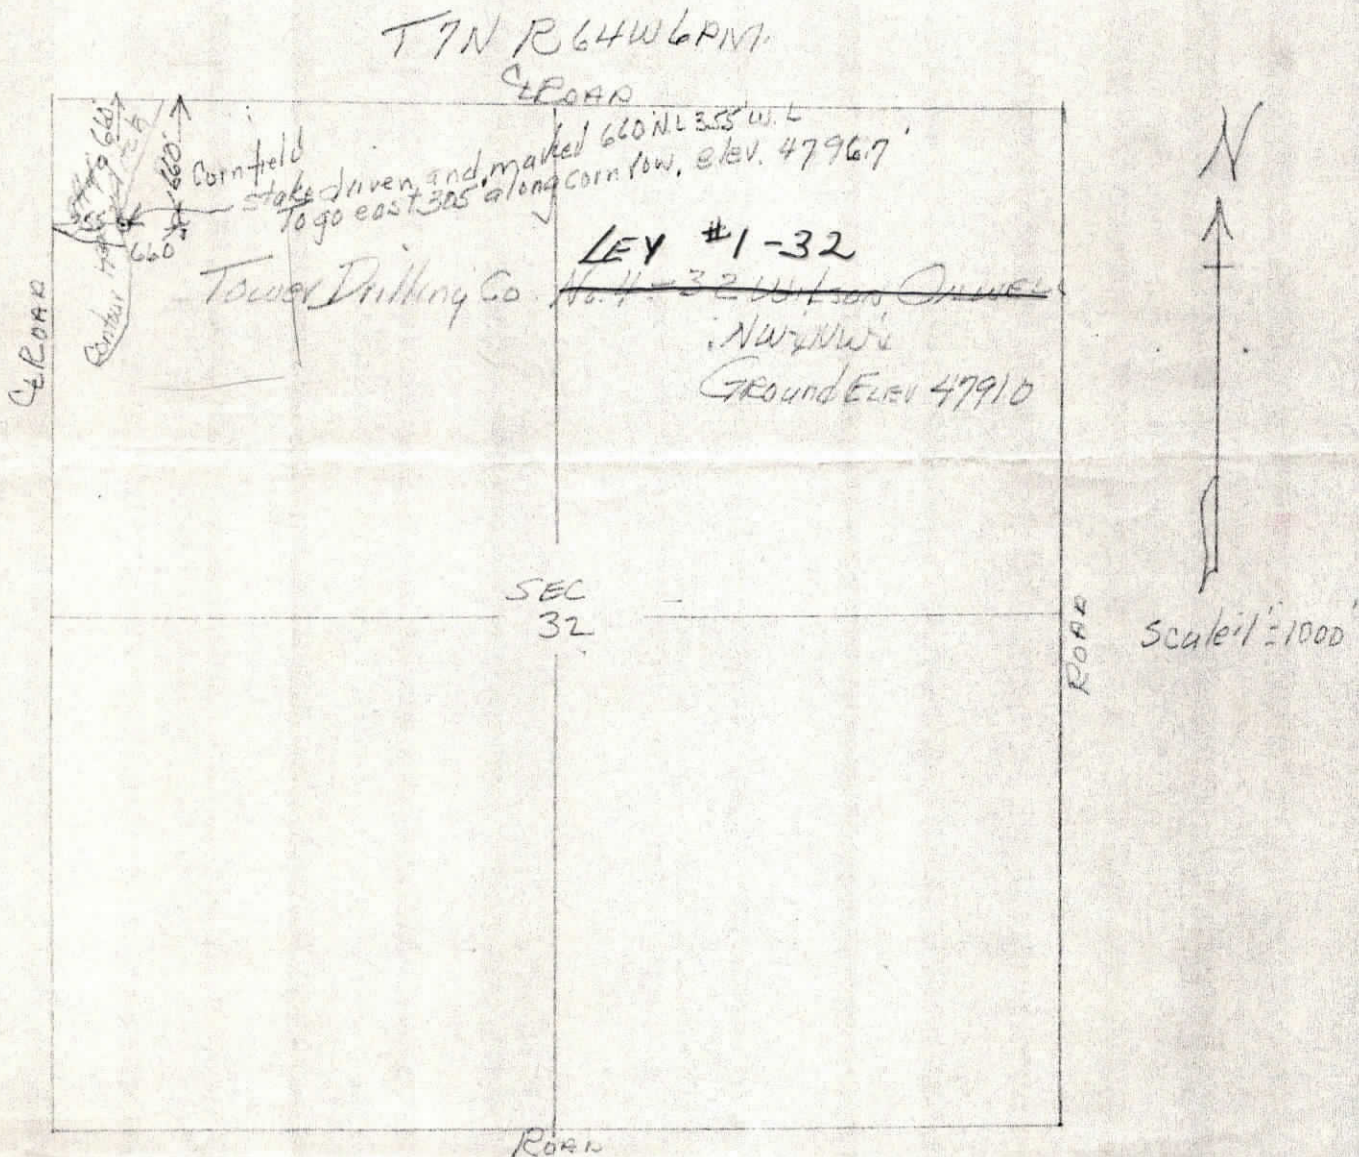

I hereby certify that the above plat is an accurate representation of a correct survey showing the location of Tower Drilling Co.-No.4-32 Wilson Oilwell in NW $\frac{1}{4}$ NW $\frac{1}{4}$  Sec.32 T7N R64W 6PM. The elevation of the ground at the the location is 4791.0 feet above sea level from U.S.G.S. Bench Mark.

Fort Morgan, Colorado  
July 30, 1985

*David Osborne*  
Registered Professional Engineer  
State of Colorado