

CERTIFICATE OF SURVEY
for
Power Energy Resources
Weld County, Colorado

RECEIVED


NOV 28 1984

COLORADO OIL & GAS CONS. COMM.



00226605

T7N R65W 6PM

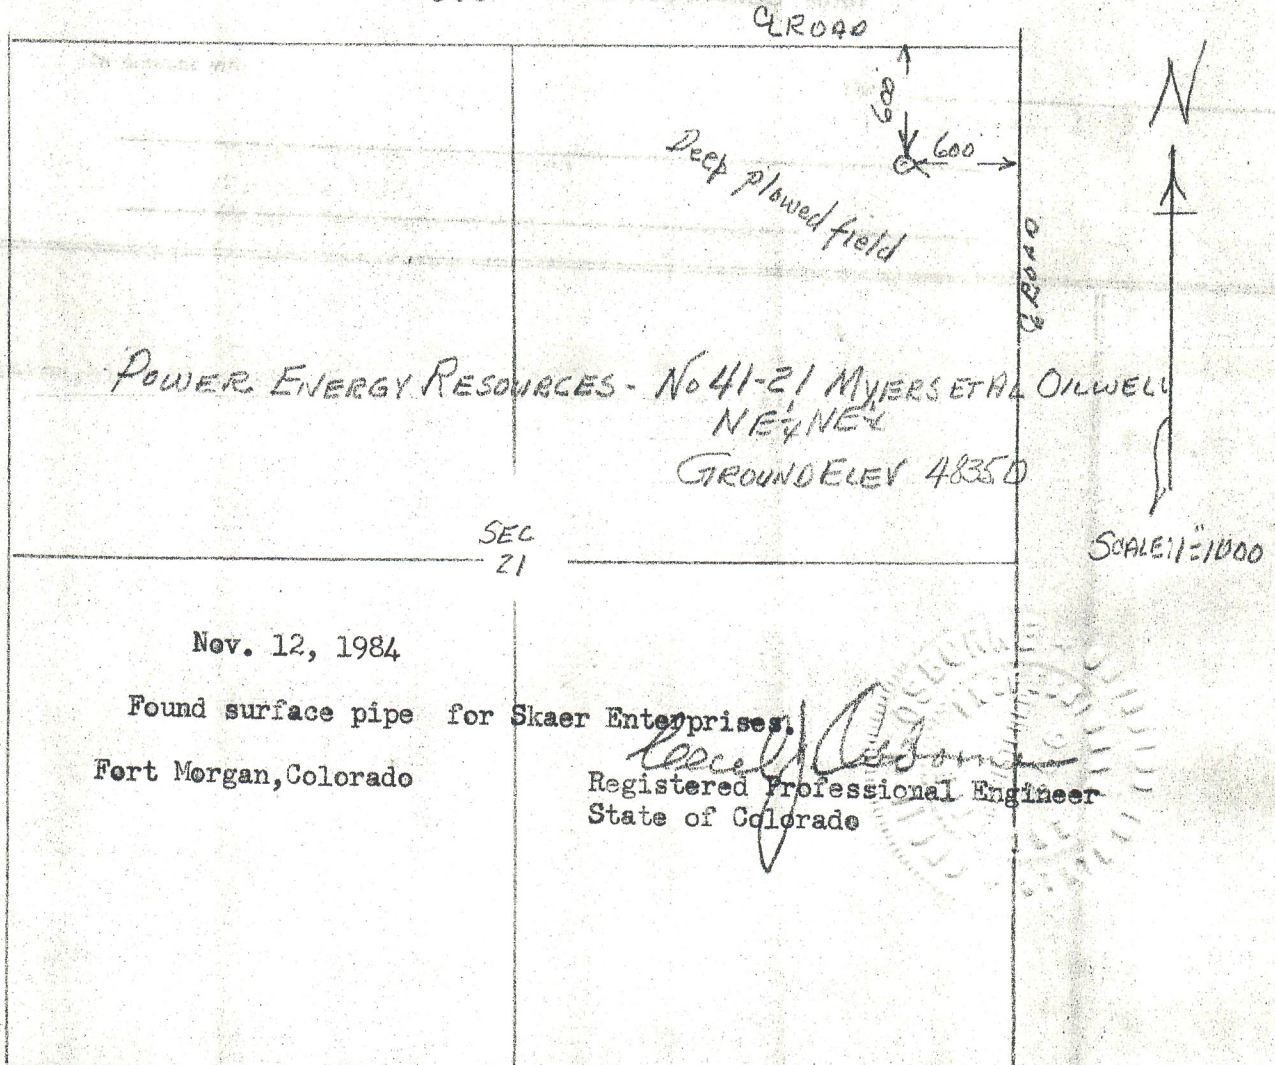

Nov. 12, 1984

Found surface pipe for Skaer Enterprises.
Fort Morgan, Colorado

Leslie J. Osborne
Registered Professional Engineer
State of Colorado

I hereby certify that the above plat is an accurate representation of a correct survey showing the location of Power Energy Resources-No. 41.-21 Myers et al Oilwell in NE 1/4 NE 1/4 Sec. 21 T7N R65W 6PM. The elevation of the ground at the stake is 4835.0 feet above sea level from U.S.C.S. Bench Mark.

Fort Morgan, Colorado
Dec. 5, 1983

Leslie J. Osborne
Registered Professional Engineer
State of Colorado