


WELL CERTIFICATION EXHIBIT COYOTE TRAILS 33S-20-1N

SW1/4 SE1/4 SEC. 28, T1N, R68W, 6TH P.M.

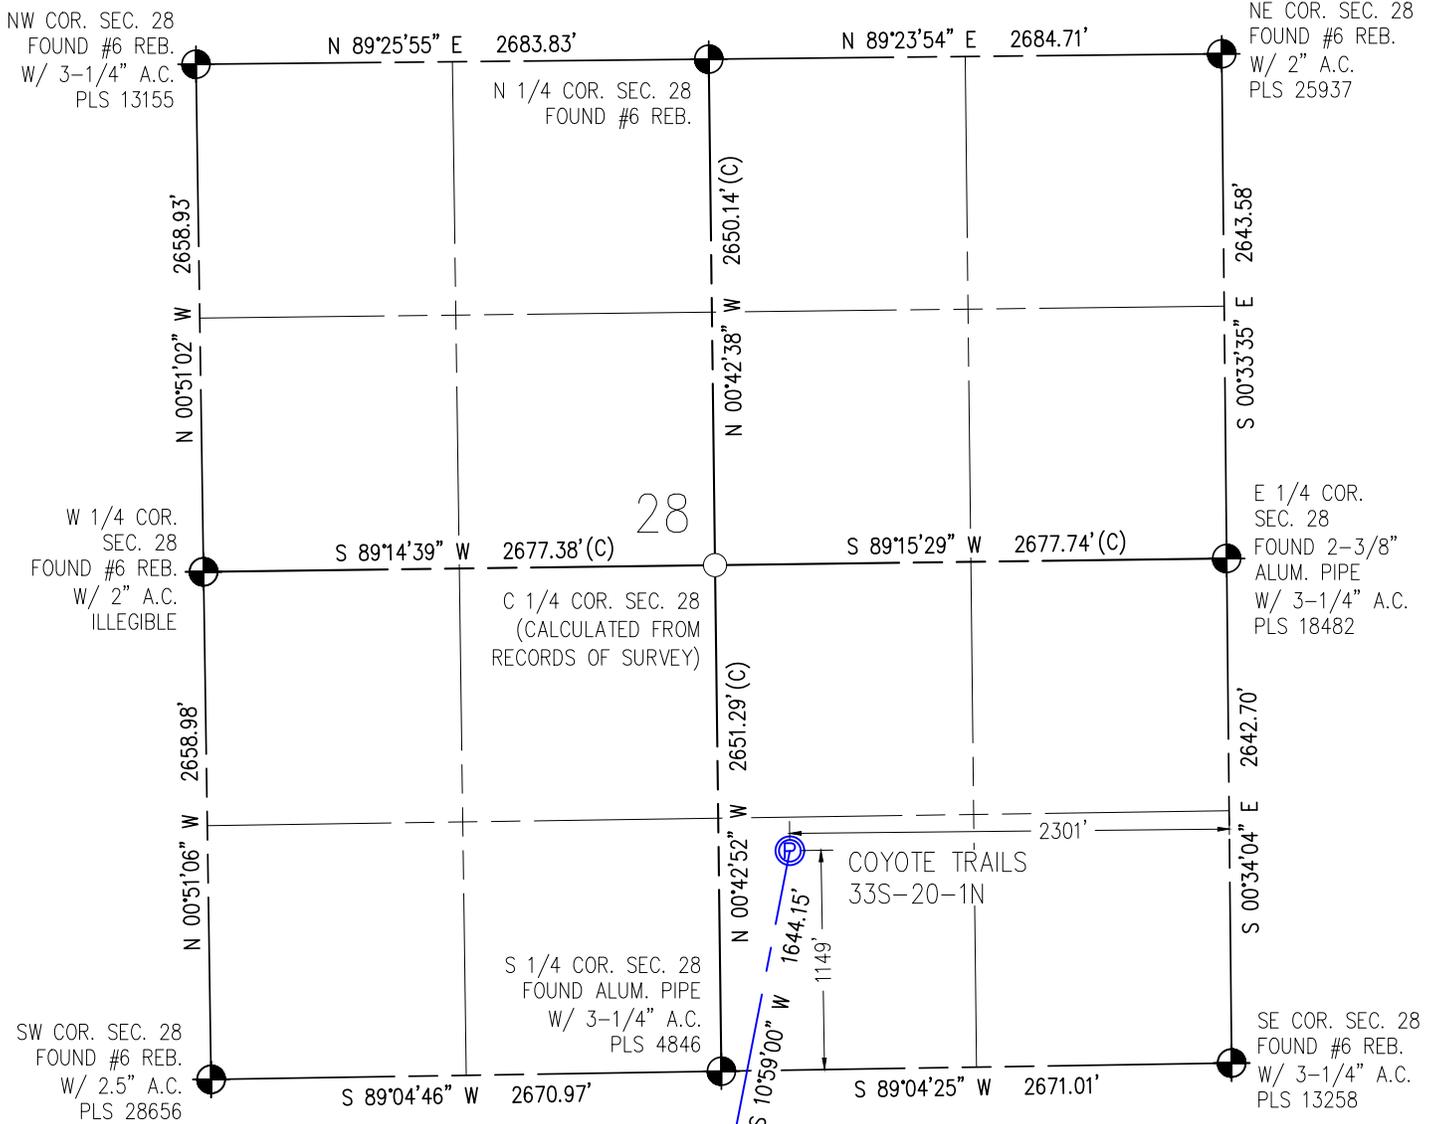

NW COR. SEC. 28
FOUND #6 REB.
W/ 3-1/4" A.C.
PLS 13155

N 1/4 COR. SEC. 28
FOUND #6 REB.

NE COR. SEC. 28
FOUND #6 REB.
W/ 2" A.C.
PLS 25937

W 1/4 COR.
SEC. 28
FOUND #6 REB.
W/ 2" A.C.
ILLEGIBLE

C 1/4 COR. SEC. 28
(CALCULATED FROM
RECORDS OF SURVEY)

E 1/4 COR.
SEC. 28
FOUND 2-3/8"
ALUM. PIPE
W/ 3-1/4" A.C.
PLS 18482

SW COR. SEC. 28
FOUND #6 REB.
W/ 2.5" A.C.
PLS 28656

S 1/4 COR. SEC. 28
FOUND ALUM. PIPE
W/ 3-1/4" A.C.
PLS 4846

SE COR. SEC. 28
FOUND #6 REB.
W/ 3-1/4" A.C.
PLS 13258

WELL BORES CONTINUE INTO
SECTION 33 (SHEET 2)

I HEREBY CERTIFY THAT THIS WELL LOCATION CERTIFICATE WAS PREPARED BY ME, OR UNDER MY DIRECT SUPERVISION, THAT THE FIELD WORK WAS COMPLETED ON 06/30/2017, THAT THIS IS NOT A LAND SURVEY PLAT OR AN IMPROVEMENT SURVEY PLAT, AND THAT THIS IS NOT TO BE RELIED UPON FOR ESTABLISHMENT OF FENCE, BUILDING OR OTHER FUTURE IMPROVEMENT LINES.



AARON A. DEMO
Professional Land Surveyor Registration No. 38285
State of Colorado
FOR AND ON BEHALF OF BASELINE ENGINEERING CORP.



Scale 1" = 1000' ft

SURFACE LOCATION
SEC. 28, T1N, R68W
GROUND ELEVATION = 5273'
PDOP = 1.3
LATITUDE = 40.017977"
LONGITUDE = -105.007281"
1149' FSL, 2301' FEL
ENTRY POINT LOCATION
SEC. 33, T1N, R68W
LATITUDE = 40.013552"
LONGITUDE = -105.008431"
460' FNL, 2626' FEL
BOTTOM HOLE LOCATION
SEC. 4, T1S, R68W
LATITUDE = 39.987010"
LONGITUDE = -105.008227"
150' FSL, 2134' FWL

NOTES:

1. ● INDICATES SECTION CORNER
2. ○ INDICATES CALCULATED CORNER
3. (C) INDICATES CALCULATED DIMENSION
4. ELEVATION BASED ON NAVD88 (GEOID12B)
5. BEARINGS DERIVED FROM COLORADO COORDINATE SYSTEM OF 1983 NORTH ZONE.
6. OPERATOR: TRAVIS WINNICKI
7. IMPROVEMENTS: SEE LOCATION DRAWING FOR ALL VISIBLE IMPROVEMENTS WITHIN 500' OF DISTURBED AREA.
8. WELL FOOTAGES ARE MEASURED AT RIGHT ANGLES TO THE SECTION LINES.

NEAREST CULTURAL ITEMS:

BUILDING: 1431' SW
BUILDING UNIT: 1431' SW
HIGH OCCUPANCY BUILDING UNIT: 4679' SW
DESIGNATED OUTSIDE ACTIVITY AREA: 5280'+
PUBLIC ROAD: WELD COUNTY ROAD 4 1222' S
ABOVE GROUND UTILITY: 1722' S
RAILROAD: 5280'+
PROPERTY LINE: 373' W
SURFACE USE: GRASSLAND.
NEAREST EXISTING WELL: MEIKLE 28-1 553' SE




DRAWN BY RPM	CHECKED BY AAD
INITIAL SUBMITAL REVISED	08/24/2017 N/A
DRAWING SIZE	8.5" X 11"
JOB NO.	EXT01N6W28-01
SHEET	1 OF 3

BASELINE
Engineering - Planning - Surveying
4007 S. LINCOLN AVENUE, SUITE 405 - LOVELAND, COLORADO 80537
P: 970.353.7800 - F: 970.353.7801 - www.baselinecorp.com

M:\co - Well Head Staking\EXT01N6W28-01 (FRONT RANGE)\Drawings\EXT01N6W28-01 (COYOTE TRAILS) - 2 (SOUTH).dwg, 8/24/2017 11:17:00 AM, Ryan McAdams

WELL CERTIFICATION EXHIBIT COYOTE TRAILS 33S-20-1N

SW1/4 SE1/4 SEC. 28, T1N, R68W, 6TH P.M.

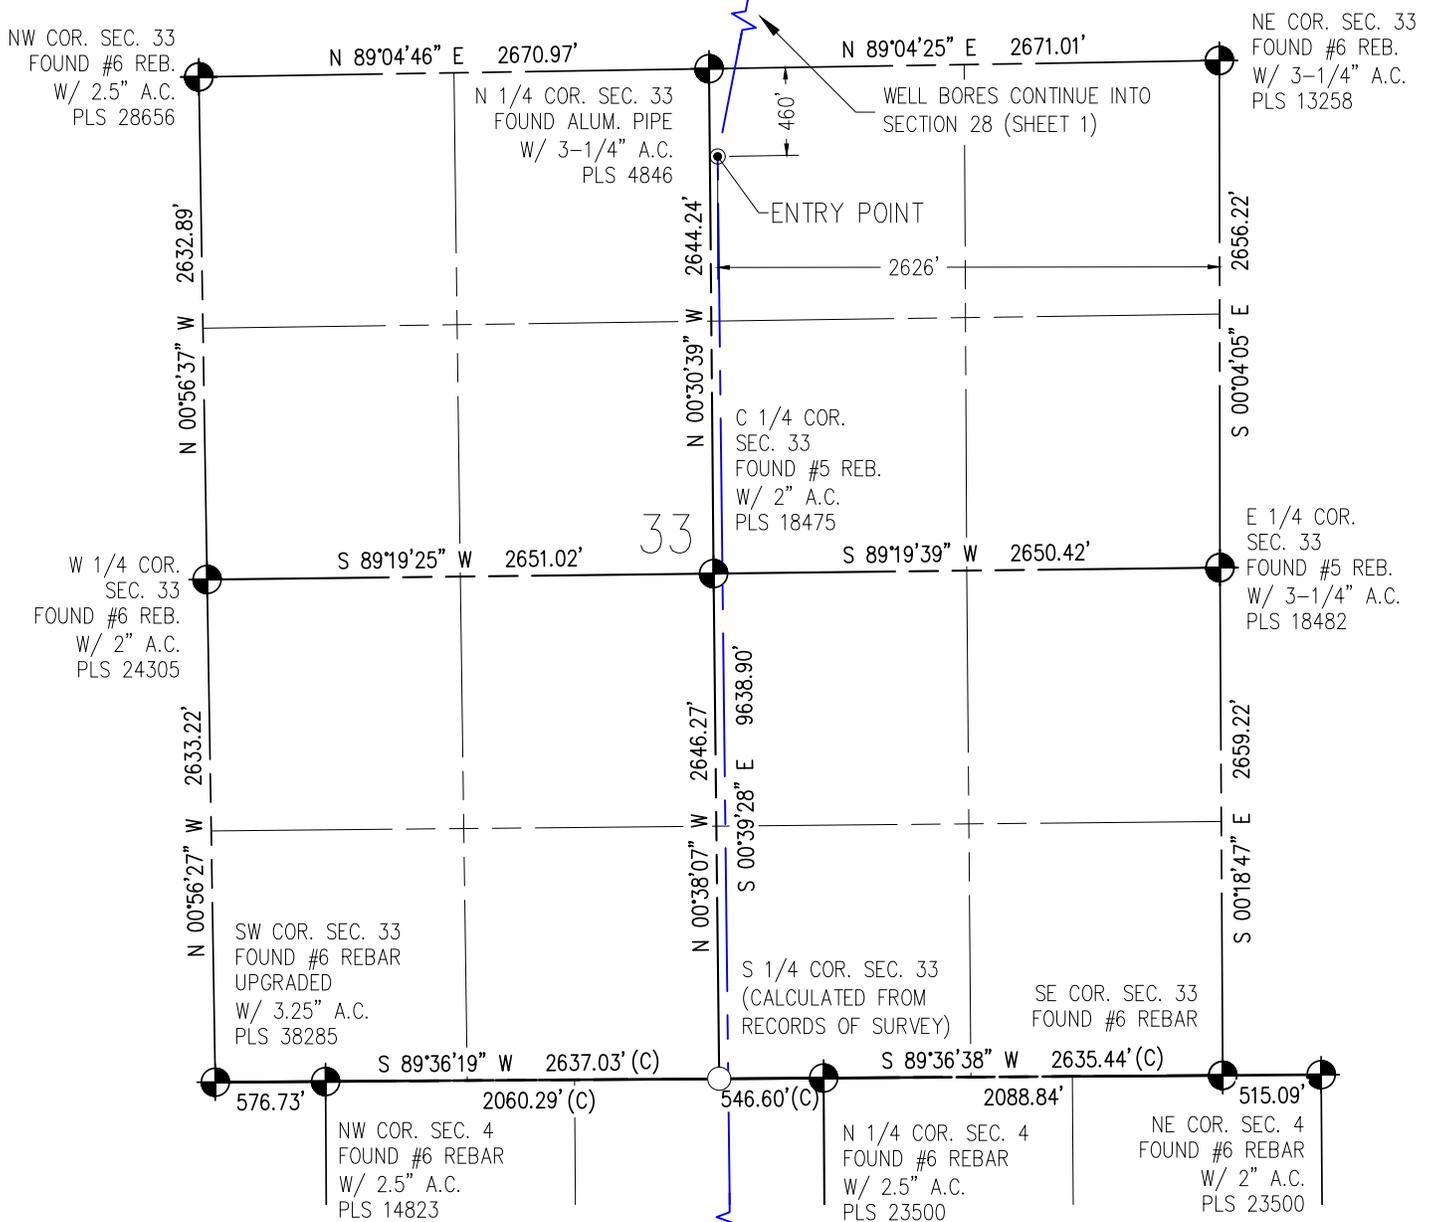


- NOTES:**
- INDICATES SECTION CORNER
 - INDICATES CALCULATED CORNER
 - (C) INDICATES CALCULATED DIMENSION
 - ELEVATION BASED ON NAVD88 (GEOID12B)
 - BEARINGS DERIVED FROM COLORADO COORDINATE SYSTEM OF 1983 NORTH ZONE.
 - OPERATOR: TRAVIS WINNICKI
 - IMPROVEMENTS: SEE LOCATION DRAWING FOR ALL VISIBLE IMPROVEMENTS WITHIN 500' OF DISTURBED AREA.
 - WELL FOOTAGES ARE MEASURED AT RIGHT ANGLES TO THE SECTION LINES.

I HEREBY CERTIFY THAT THIS WELL LOCATION CERTIFICATE WAS PREPARED BY ME, OR UNDER MY DIRECT SUPERVISION, THAT THE FIELD WORK WAS COMPLETED ON 06/30/2017, THAT THIS IS NOT A LAND SURVEY PLAT OR AN IMPROVEMENT SURVEY PLAT, AND THAT IT IS NOT TO BE RELIED UPON FOR ESTABLISHMENT OF FENCE, BUILDING OR OTHER FUTURE IMPROVEMENT LINES.



AARON A. DEMO
Professional Land Surveyor Registration No. 38285
State of Colorado
FOR AND ON BEHALF OF BASELINE ENGINEERING CORP.

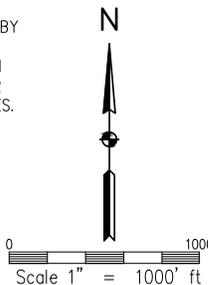

SURFACE LOCATION
SEC. 28, T1N, R68W
GROUND ELEVATION = 5273'
PDOP = 1.3
LATITUDE = 40.017977°
LONGITUDE = -105.007281°
1149' FSL, 2301' FEL
ENTRY POINT LOCATION
SEC. 33, T1N, R68W
LATITUDE = 40.013552°
LONGITUDE = -105.008431°
460' FNL, 2626' FEL
BOTTOM HOLE LOCATION
SEC. 4, T1S, R68W
LATITUDE = 39.987010°
LONGITUDE = -105.008227°
150' FSL, 2134' FWL

NEAREST CULTURAL ITEMS:

BUILDING: 1431' SW
BUILDING UNIT: 1431' SW
HIGH OCCUPANCY BUILDING UNIT: 4679' SW
DESIGNATED OUTSIDE ACTIVITY AREA: 5280'+
PUBLIC ROAD: WELD COUNTY ROAD 4 1222' S
ABOVE GROUND UTILITY: 1722' S
RAILROAD: 5280'+
PROPERTY LINE: 373' W
SURFACE USE: GRASSLAND.
NEAREST EXISTING WELL: MEIKLE 28-1 553' SE




DRAWN BY	CHECKED BY
RPM	AAD
INITIAL SUBMITTAL	08/24/2017
REVISED	N/A
DRAWING SIZE	8.5" X 11"
JOB NO.	EXT01N68W28-01
SHEET	2 OF 3

BASELINE
Engineering - Planning - Surveying

4007 S. LINCOLN AVENUE, SUITE 405 - LOVELAND, COLORADO 80537
P: 970.353.7800 - F: 970.353.7801 - www.baselinecorp.com

WELL CERTIFICATION EXHIBIT COYOTE TRAILS 33S-20-1N

SW1/4 SE1/4 SEC. 28, T1N, R68W, 6TH P.M.

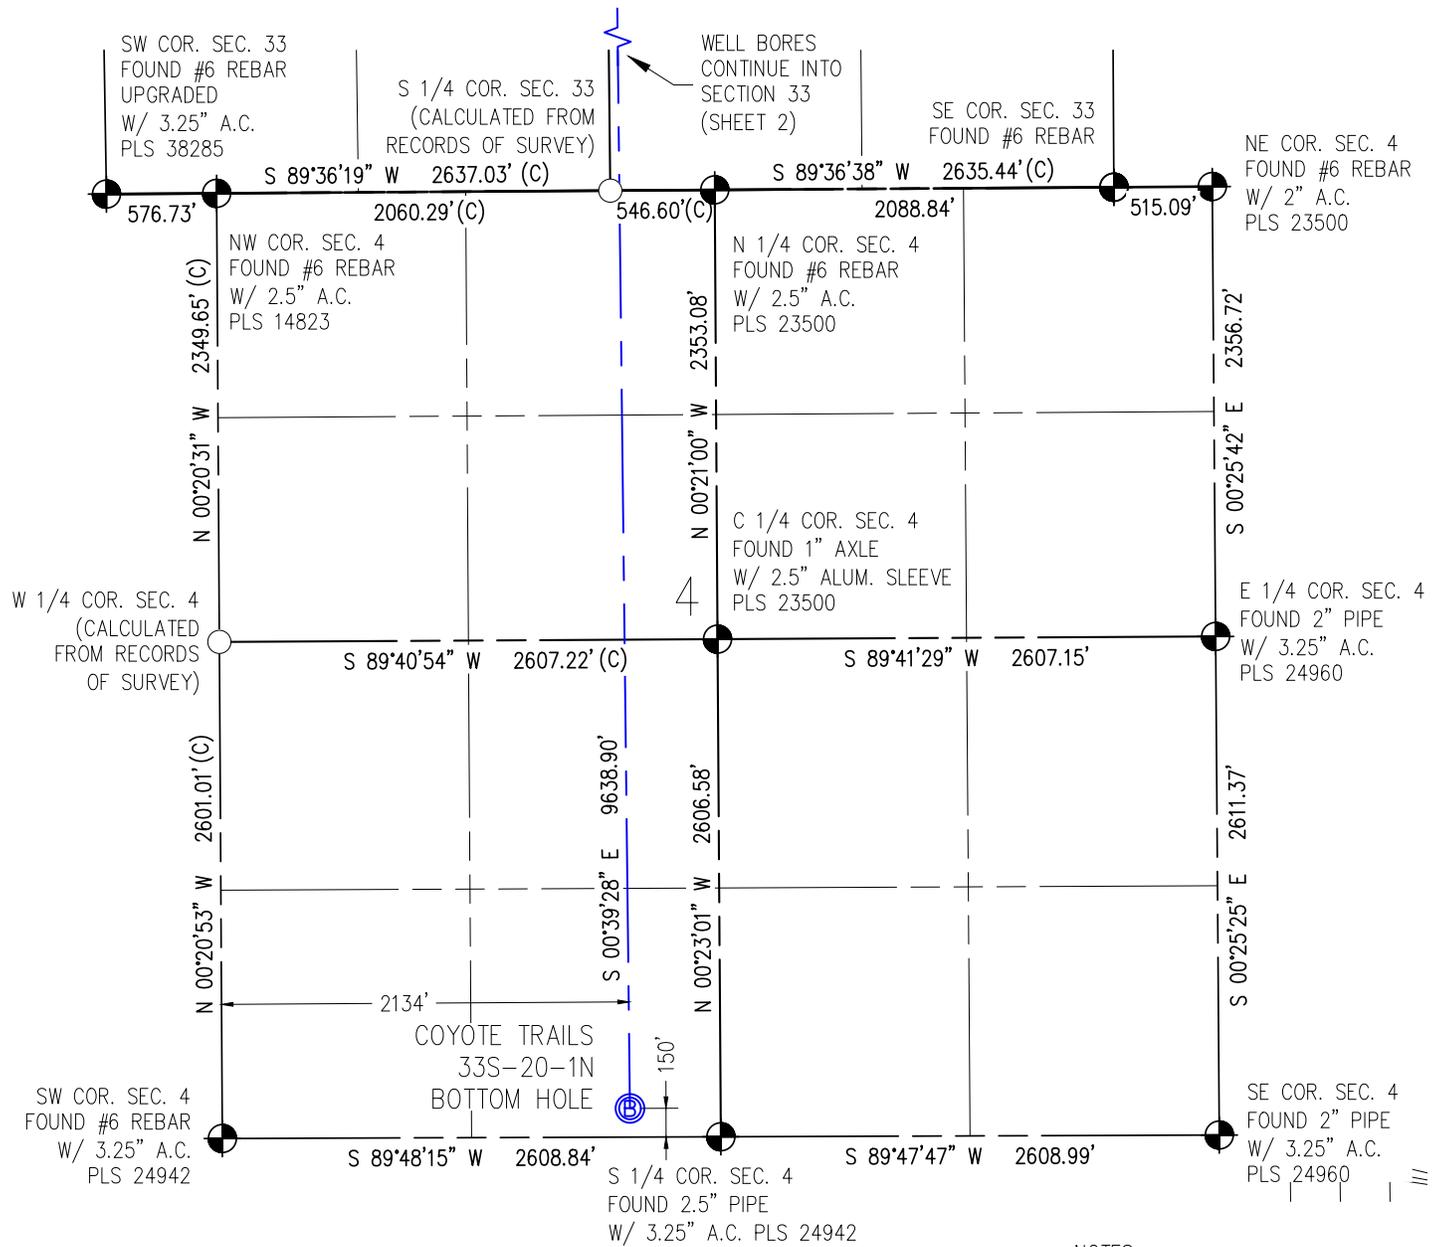


NOTES:


1. ● INDICATES SECTION CORNER
2. ○ INDICATES CALCULATED CORNER
3. (C) INDICATES CALCULATED DIMENSION
4. ELEVATION BASED ON NAVD88 (GEOID12B)
5. BEARINGS DERIVED FROM COLORADO COORDINATE SYSTEM OF 1983 NORTH ZONE.
6. OPERATOR: TRAVIS WINNICKI
7. IMPROVEMENTS: SEE LOCATION DRAWING FOR ALL VISIBLE IMPROVEMENTS WITHIN 500' OF DISTURBED AREA.
8. WELL FOOTAGES ARE MEASURED AT RIGHT ANGLES TO THE SECTION LINES.

SURFACE LOCATION
 SEC. 28, T1N, R68W
 GROUND ELEVATION = 5273'
 PDOP = 1.3
 LATITUDE = 40.017977°
 LONGITUDE = -105.007281°
 1149' FSL, 2301' FEL
ENTRY POINT LOCATION
 SEC. 33, T1N, R68W
 LATITUDE = 40.013552°
 LONGITUDE = -105.008431°
 460' FNL, 2626' FEL
BOTTOM HOLE LOCATION
 SEC. 4, T1S, R68W
 LATITUDE = 39.987010°
 LONGITUDE = -105.008227°
 150' FSL, 2134' FWL

I HEREBY CERTIFY THAT THIS WELL LOCATION CERTIFICATE WAS PREPARED BY ME, OR UNDER MY DIRECT SUPERVISION, THAT THE FIELD WORK WAS COMPLETED ON 06/30/2017, THAT THIS IS NOT A LAND SURVEY PLAT OR AN IMPROVEMENT SURVEY PLAT, AND THAT IT IS NOT TO BE RELIED UPON FOR ESTABLISHMENT OF FENCE, BUILDING OR OTHER FUTURE IMPROVEMENT LINES.

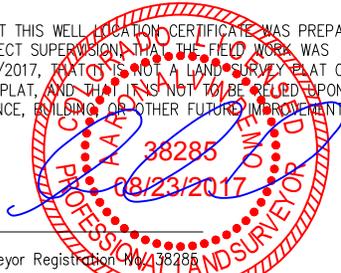

AARON A. DEMO
 Professional Land Surveyor Registration No. 38285
 State of Colorado
 FOR AND ON BEHALF OF BASELINE ENGINEERING CORP.

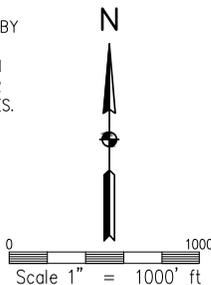

NEAREST CULTURAL ITEMS:

BUILDING: 1431' SW
 BUILDING UNIT: 1431' SW
 HIGH OCCUPANCY BUILDING UNIT: 4679' SW
 DESIGNATED OUTSIDE ACTIVITY AREA: 5280'+
 PUBLIC ROAD: WELD COUNTY ROAD 4 1222' S
 ABOVE GROUND UTILITY: 1722' S
 RAILROAD: 5280'+
 PROPERTY LINE: 373' W
 SURFACE USE: GRASSLAND.
 NEAREST EXISTING WELL: MEIKLE 28-1 553' SE



DRAWN BY	CHECKED BY
RPM	AAD
INITIAL SUBMITTAL	08/24/2017
REVISED	N/A
DRAWING SIZE	8.5" X 11"
JOB NO.	EXT01N68W28-01
SHEET	3 OF 3



4007 S. LINCOLN AVENUE, SUITE 405 - LOVELAND, COLORADO 80537
 P: 970.353.7800 - F: 970.353.7801 - www.baselinecorp.com