


CURRENT

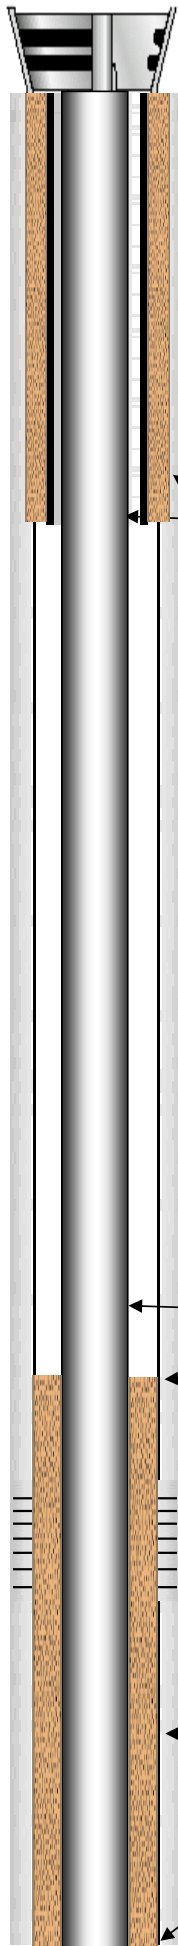

COMPANY					DATE	
SCHNEIDER ENERGY SERVICES, LLC					1/15/19	
LEASE						
NUGGET UNIT-WAGERS # 2						
CASING	Size	Weight	Grade	Thread	Depth	
LINER	Size	Weight	Grade	Thread	Depth	
drill pipe	First String	Size	Weight	Grade	Thread	Depth
	Second String	Size	Weight	Grade	Thread	Depth
Prepared for:			Perforations:			
COGCC			D SAND 5247' TO 5269'			
ITEM No#	Length	Description			ID	OD
1	104.00	8-5/8" 24# SURFACE CASING				104.00
2		90 SACKS OF CEMENT				
3		5-1/2" PRODUCTION CASING				
4		TOP OF CEMENT 5000' (CALC)				
5		D SAND PERFS 5247' TO 5269'				
6		125 SACKS OF CEMENT				
7		5-1/2" CASING LANDED AT 5363'				5363.00
PREPARED BY					PHONE:	
JEFF SCHNEIDERQ					(970)381-9588	
OFFICE			PHONE		INVOICE #	
FORT MORGAN, CO			(970)867-9437			