




VERBAL REQUEST

NOTICE OF INTENTION TO DRILL X

Bonding Status Blanket (P & S)

NOTICE OF INTENTION TO ABANDON \_\_\_\_\_

OTHER \_\_\_\_\_

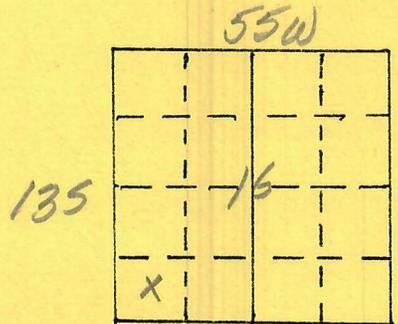

COMPANY Murfin Drilg. ADDRESS \_\_\_\_\_

BY Baren Babcock PHONE NO. \_\_\_\_\_ Ext. \_\_\_\_\_

WELL NO. 1-16 Title \_\_\_\_\_ LEASE 5-5-N Colo. State

COUNTY Lincoln FIELD WC

Location C 5W 5W Sec. 16 Twp. 135 Range 55W Meridian \_\_\_\_\_  
\_\_\_\_\_ ft from \_\_\_\_\_ Section line, and \_\_\_\_\_ ft from \_\_\_\_\_ Section line  
N or S E or W

ESTIMATED DATE OF WORK 11/3/83 ESTIMATED TIME \_\_\_\_\_

DETAILS OF PLAN OF WORK: T.D. 8200' FORMATION Miss

SURFACE CASING 400' - 8 5/8"  
\_\_\_\_\_  
\_\_\_\_\_  
\_\_\_\_\_  
\_\_\_\_\_  
\_\_\_\_\_

APPROVED BY AM 83 DATE 11/3/83