


# Berge Exploration, Inc Penrod 4-3 - P&A Re-Entry

## FINAL WELLBORE DIAGRAM

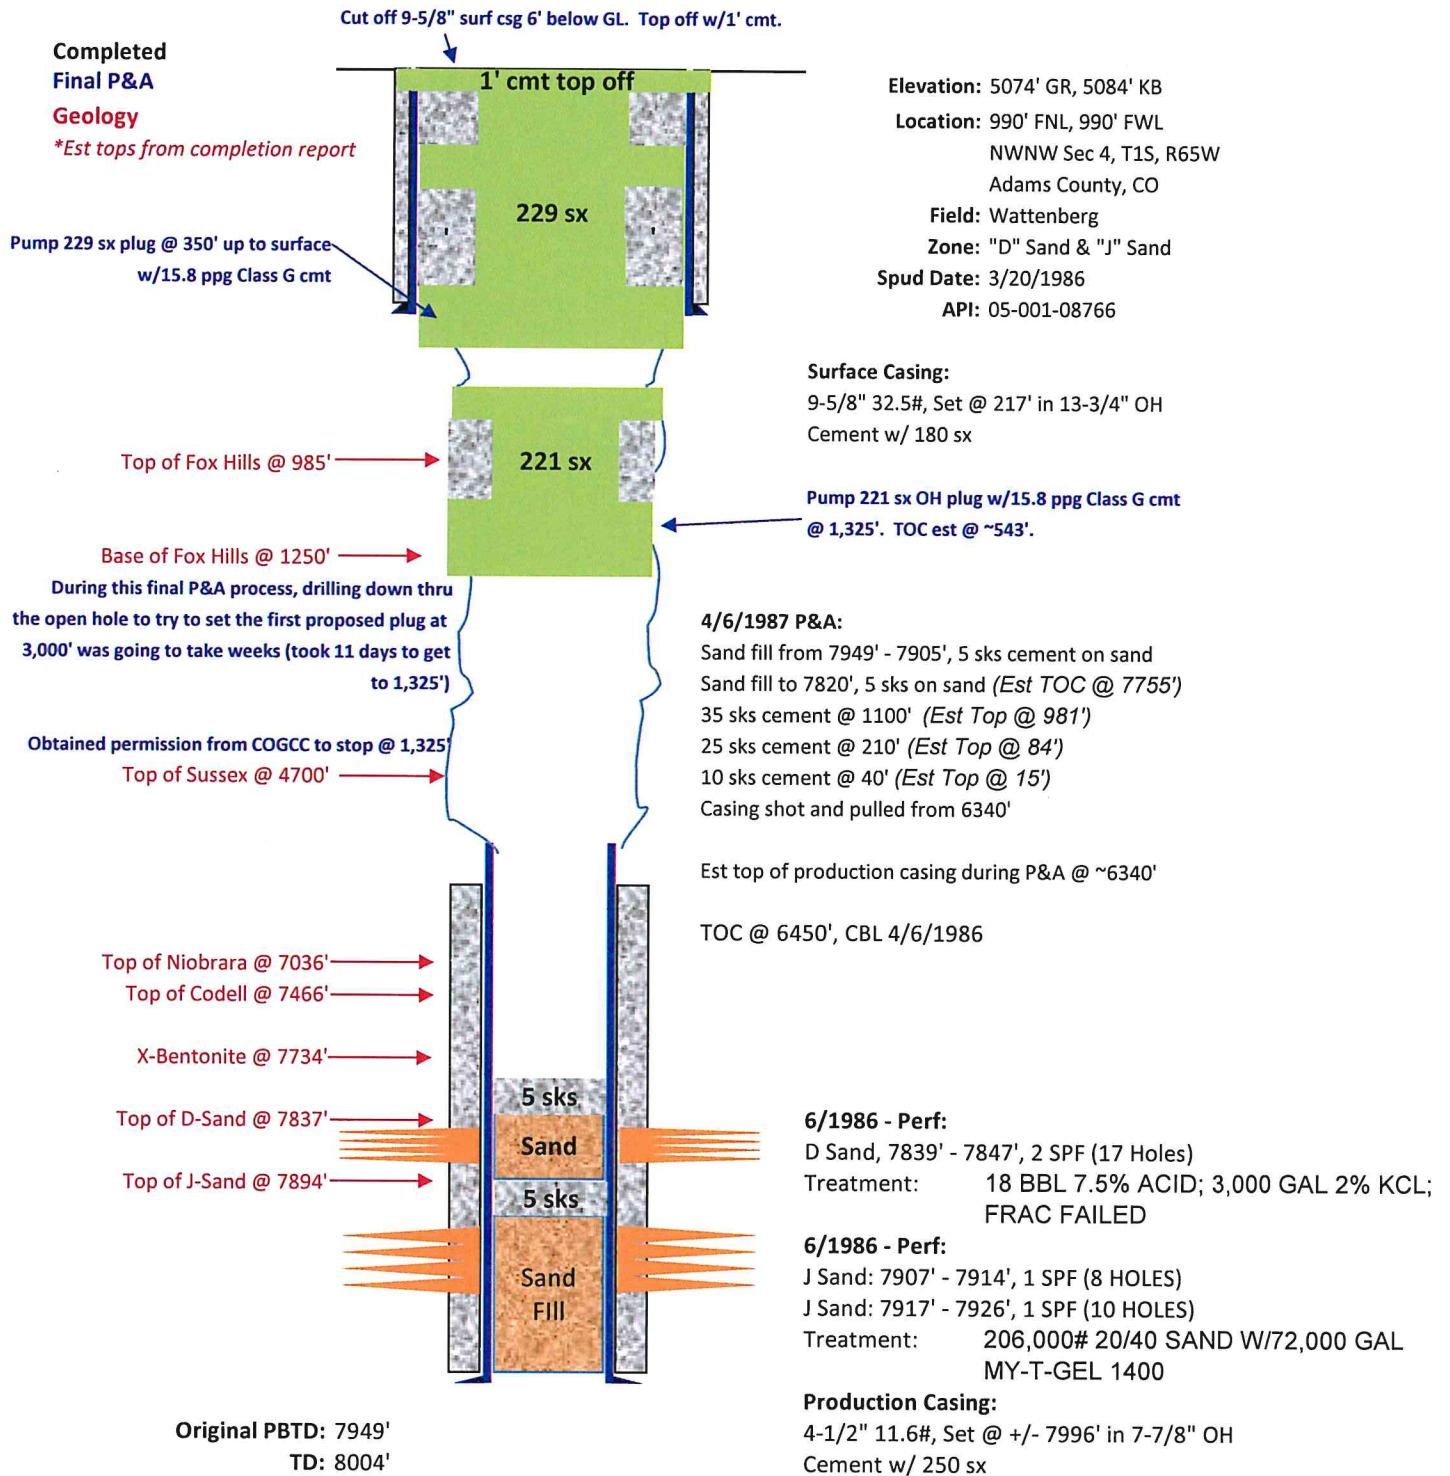

(Not to Scale)