


Before Plugging:

8 5/8" 24# Surface Set @ 230' MD

Cement Plug from 28' - Surface

Cement Plug from 250' - 210'

7 7/8" Open Hole TD @ 8275' MD

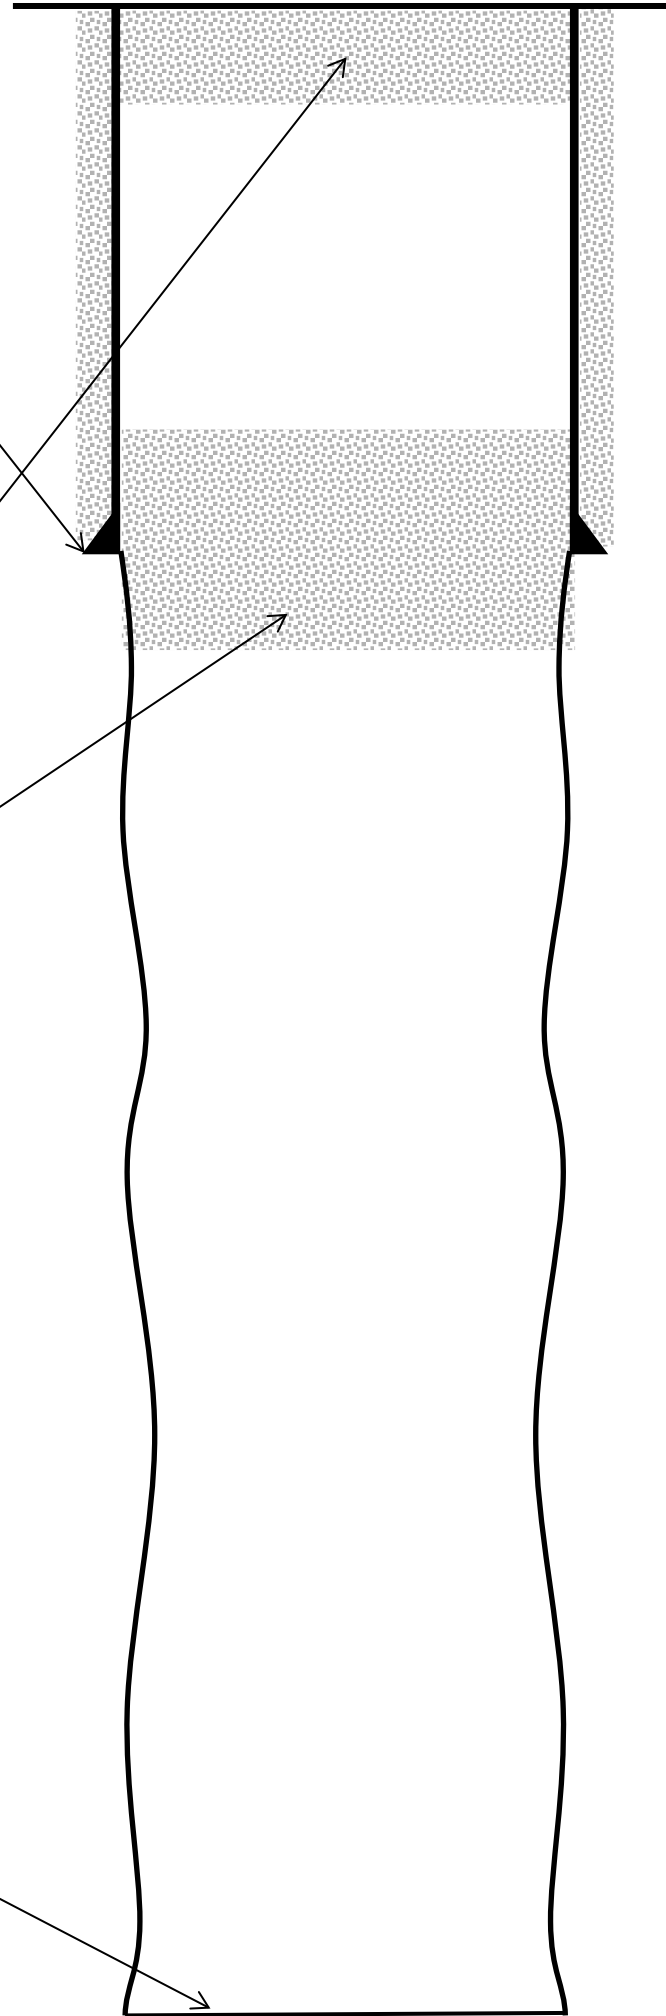

After Plugging:

8 5/8" 24# Surface Set @ 230' MD

Cement Plug from 260' - Surface

Cement plug from 1400' - 1500' MD

7 7/8" Open Hole TD @ 8275' MD

