


Well Name: SPIKE STATE D16-08

VERTICAL, ORIGINAL HOLE, 1/21/2019 10:00:16 AM

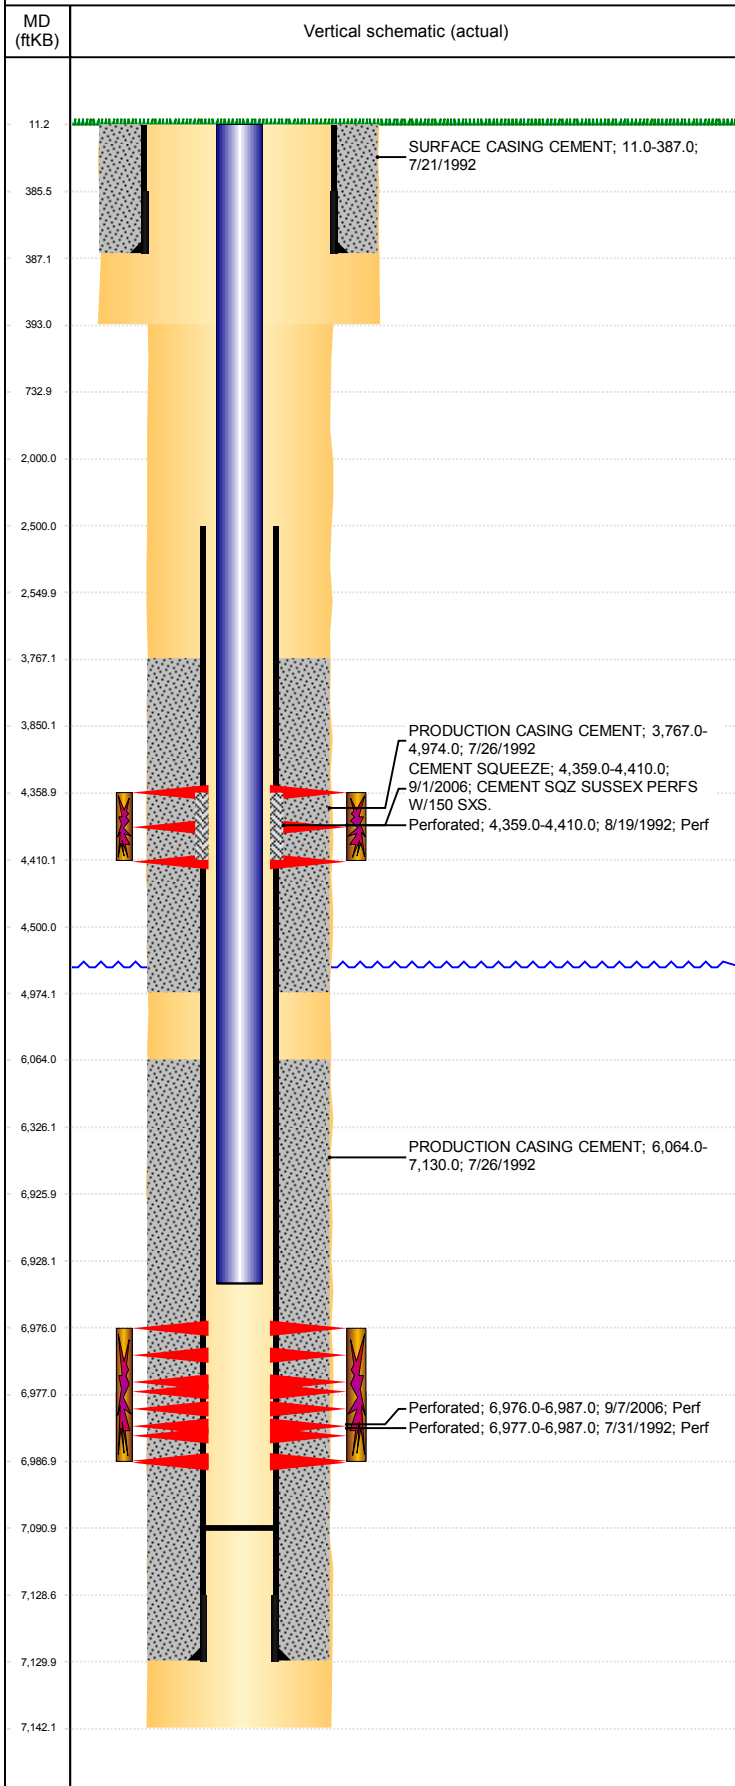

Well Header									
API 05-123-15910		Business Unit DJ BASIN			District 15		Well Config VERTICAL		
KB - GL / MSL (ft... 11.00		Spud Date 7/21/1992		P & A Date		Well Production Status PR			SoRT No
Comment									
Surface Location (Congressional)									
Qtr 3 SE	Qtr 4 NE	Section 16	Twonshp 3	Twonsh... N	Range 64	Rng E /... W	Actual Latitude (°) 40.22715199		Actual Longitude (°) -104.54848756
Wellbore Sections									
Section Des			Size (in)			Act Top, MD (ftKB)		Act Btm, MD (ftKB)	
SURFACE			12 1/4			11		393	
PRODUCTION			7 7/8			393		7,142	
Casing Strings									
Csg Des			Run Date		OD (in)	Wt/Len (lb/ft)	Grade	Top, MD (ftKB)	MD (ftKB)
Surface			7/21/1992		8 5/8	24.00	J-55	11.0	387.0
Production			7/26/1992		3 1/2	9.30	J-55	11.0	7,130.0
Cement									
Des					Start Date		Top (ftKB)		Btm (ftKB)
SURFACE CASING CEMENT					7/21/1992		11.0		387.0
PRODUCTION CASING CEMENT					7/26/1992		3,767.0		4,974.0
PRODUCTION CASING CEMENT					7/26/1992		6,064.0		7,130.0
CEMENT SQUEEZE					9/1/2006		4,359.0		4,410.0
Zone Statuses									
Zone Name		Status Date	Status	Fluid Type	Job			Prod Method	
SUSSEX		10/14/1992	PR	Oil	DRILLING/COMPLETION - ORIGINAL, 7/21/1992...				
SUSSEX		9/1/2006	PR		RE-FRAC, 8/30/2006 00:00				
CODELL		11/3/1992	PR	Oil	DRILLING/COMPLETION - ORIGINAL, 7/21/1992...				
CODELL		10/30/2006	PR	Oil	RE-FRAC, 8/30/2006 00:00				
Perforation Data									
Linked Zone			Bnch/Stg	Entered Shot Total	Top (ftKB)		Btm (ftKB)		Date
SUSSEX, ORIGINAL HOLE				60	4,359.00		4,410.00		8/19/1992
CODELL, ORIGINAL HOLE				44	6,976.00		6,987.00		9/7/2006
CODELL, ORIGINAL HOLE				40	6,977.00		6,987.00		7/31/1992
Stimulation Intervals									
Zone				Start Date		Top (ftKB)		Btm (ftKB)	
SUSSEX, ORIGINAL HOLE				8/19/1992		4,359.0		4,410.0	
CODELL, ORIGINAL HOLE				9/18/2006		6,976.0		6,987.0	
CODELL, ORIGINAL HOLE				8/6/1992		6,977.0		6,987.0	
Other In Hole									
Run Date		Des				OD (in)	Top (ftKB)	Btm (ftKB)	
Logs									
Date		Type				Top, MD (ftKB)		Btm, MD (ftKB)	
7/25/1992		COMPENSATED DENSITY				3,880.0		7,140.0	
7/25/1992		INDUCTION				4,100.0		7,450.0	
7/31/1992		CEMENT BOND				3,700.0		7,087.0	
8/16/2017		GYRO				0.0		6,850.0	
Plug Back Total Depths									
Date		Type		Com				Depth (ftKB)	
7/26/1992		LATCH DOWN COLLAR						7,091.0	