


**Well Name: CAMOLO RED D27-06**

VERTICAL, ORIGINAL HOLE, 1/21/2019 10:29:13 AM

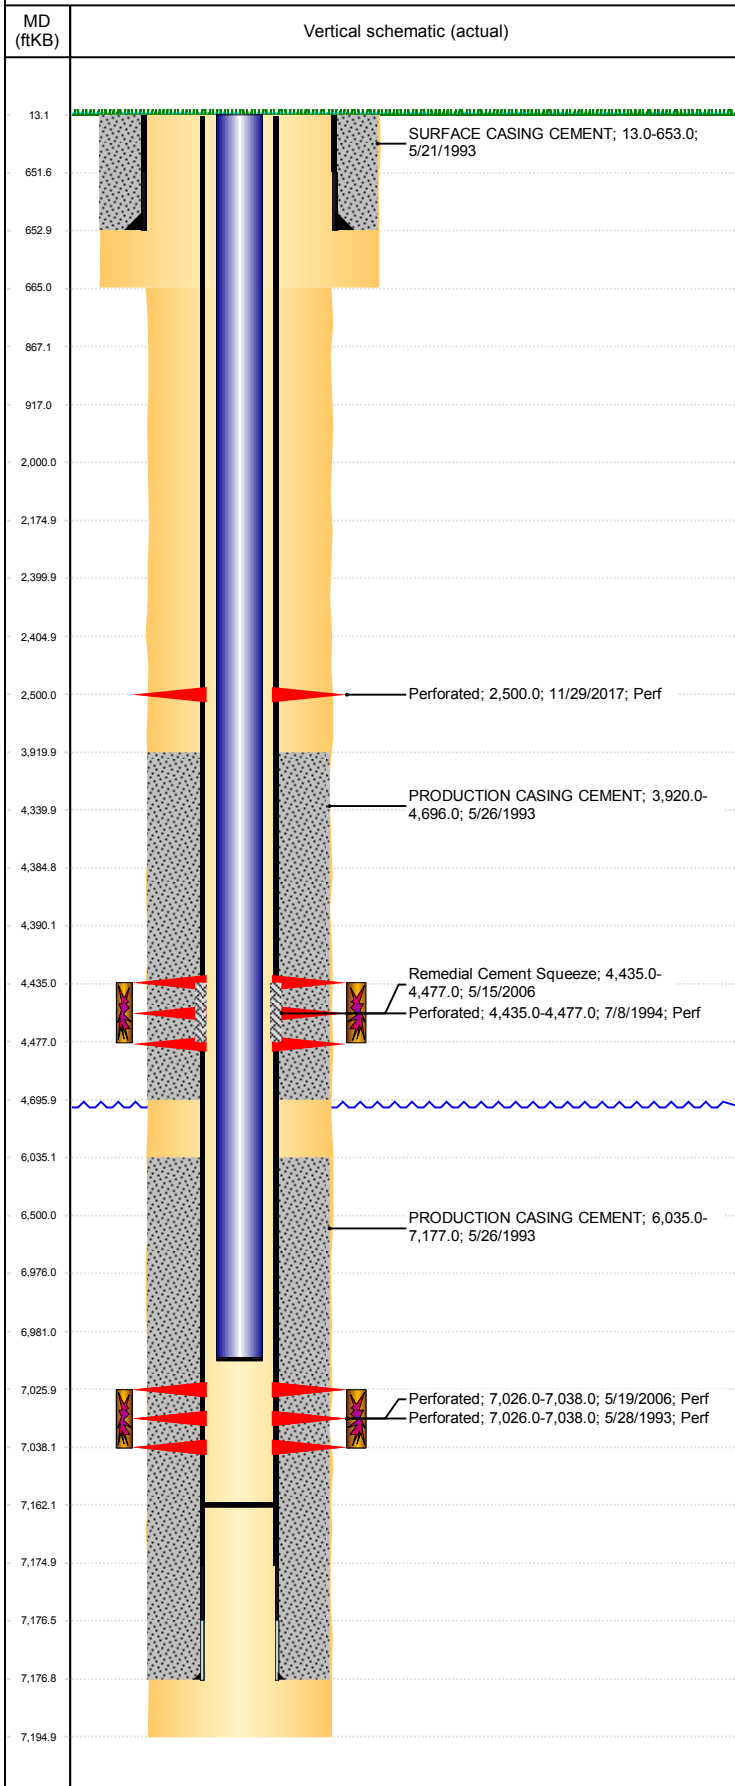

Well Header									
API 05-123-17008		Business Unit DJ BASIN			District 15		Well Config VERTICAL		
KB - GL / MSL (ft... 13.00		Spud Date 5/21/1993		P & A Date		Well Production Status SI			SoRT No
Comment									
Surface Location (Congressional)									
Qtr 3 SE	Qtr 4 NW	Section 27	Twnshp 3	Twنش... N	Range 64	Rng E/... W	Actual Latitude (°) 40.19839012		Actual Longitude (°) -104.53989021
Wellbore Sections									
Section Des			Size (in)			Act Top, MD (ftKB)		Act Btm, MD (ftKB)	
SURFACE			12 1/4			13		665	
PRODUCTION			7 7/8			665		7,195	
Casing Strings									
Csg Des		Run Date		OD (in)	Wt/Len (lb/ft)	Grade	Top, MD (ftKB)	MD (ftKB)	
Surface		5/21/1993		8 5/8	24.00	?	13.0	653.0	
Production		5/26/1993		3 1/2	7.70	M-75	13.0	7,177.0	
Cement									
Des				Start Date		Top (ftKB)		Btm (ftKB)	
SURFACE CASING CEMENT				5/21/1993		13.0		653.0	
PRODUCTION CASING CEMENT				5/26/1993		3,920.0		4,696.0	
PRODUCTION CASING CEMENT				5/26/1993		6,035.0		7,177.0	
Remedial Cement Squeeze				5/15/2006		4,435.0		4,477.0	
Zone Statuses									
Zone Name	Status Date	Status	Fluid Type	Job				Prod Method	
SUSSEX	8/8/1994	PR		RECOMPLETION, 7/8/1994 00:00					
SUSSEX	5/15/2006	AB		RE-FRAC, 5/10/2006 00:00					
CODELL	10/8/2015	PR							
CODELL	3/10/2017	SI							
Perforation Data									
Linked Zone		Bnch/Stg	Entered Shot Total	Top (ftKB)		Btm (ftKB)		Date	
SUSSEX, ORIGINAL HOLE CODELL, ORIGINAL HOLE CODELL, ORIGINAL HOLE				2,500.00		2,500.00		11/29/2017	
			14	4,435.00		4,477.00		7/8/1994	
			48	7,026.00		7,038.00		5/28/1993	
			48	7,026.00		7,038.00		5/19/2006	
Stimulation Intervals									
Zone			Start Date			Top (ftKB)		Btm (ftKB)	
SUSSEX, ORIGINAL HOLE			7/12/1994			4,435.0		4,477.0	
CODELL, ORIGINAL HOLE			6/2/1993			7,026.0		7,038.0	
CODELL, ORIGINAL HOLE			6/2/2006			7,026.0		7,038.0	
Other In Hole									
Run Date		Des				OD (in)	Top (ftKB)	Btm (ftKB)	
Logs									
Date		Type				Top, MD (ftKB)		Btm, MD (ftKB)	
5/25/1993		COMPENSATED DENSITY				3,800.0		7,200.0	
5/25/1993		INDUCTION				3,800.0		7,200.0	
5/28/1993		CEMENT BOND				3,800.0		7,155.0	
8/17/2017		GYRO				0.0		6,950.0	
Plug Back Total Depths									
Date		Type		Com				Depth (ftKB)	
5/28/1993		FILL		DEPTH LOGGER ON CBL				7,162.0	
5/18/2006		FILL		CLEANOUT				7,162.0	