



# Blomenkamp #4 05-121-05567

Liner 2018 December 2018

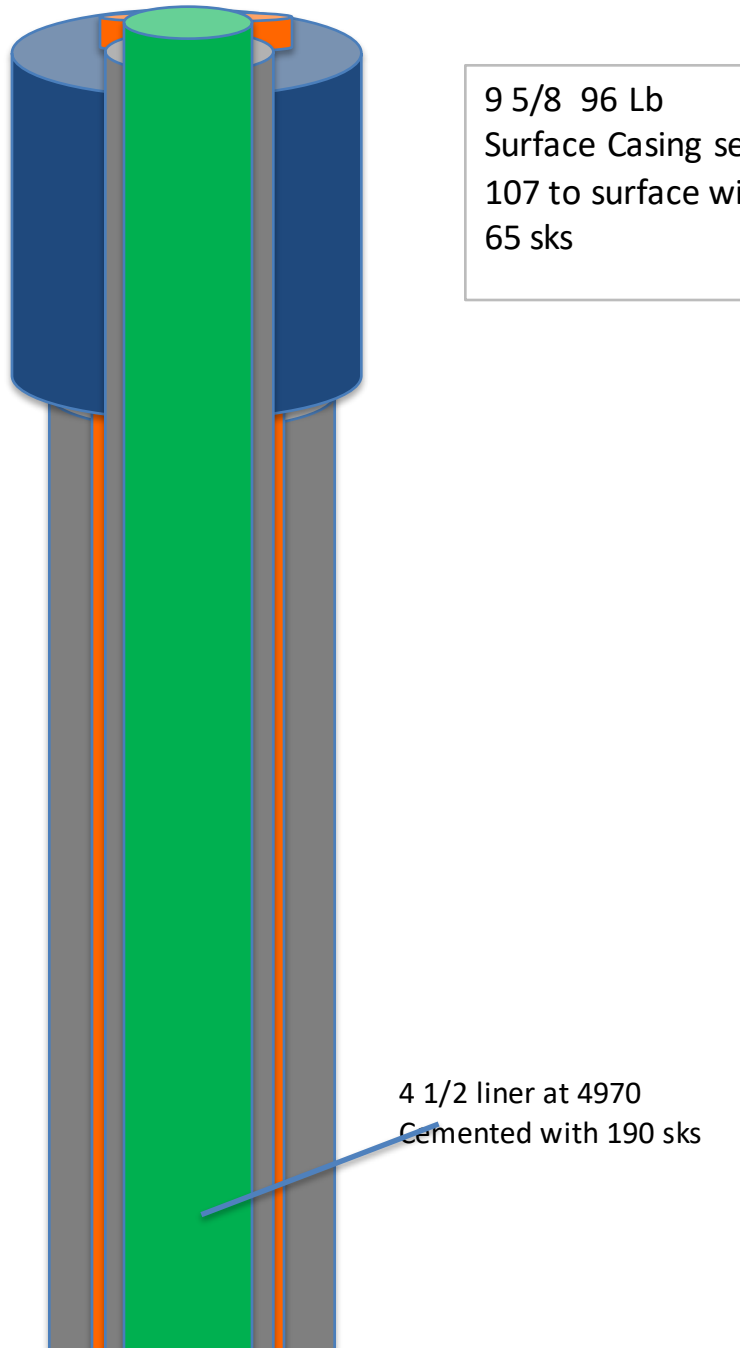

5 1/2 production casing  
surface to 5085 with 200 sks

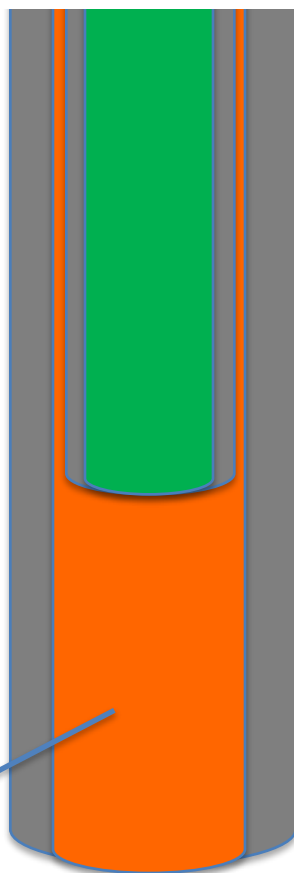

J Sand perforations  
4981-87

TD 5086

at  
ith