


**WELLBORE DIAGRAM**  
**Sunset Plugging Equipment Inc.**  
**Norton AJ-1**

SHL: 660' FSL, 660' FWL Sec. 33-T7N-R66W  
Vertical Well  
Lat/Long: 40.525633, -104.791593  
Weld County, CO  
API 05-123-11597

**Current as Re-Plugged**

**NOT TO SCALE**

TOPS (MD)

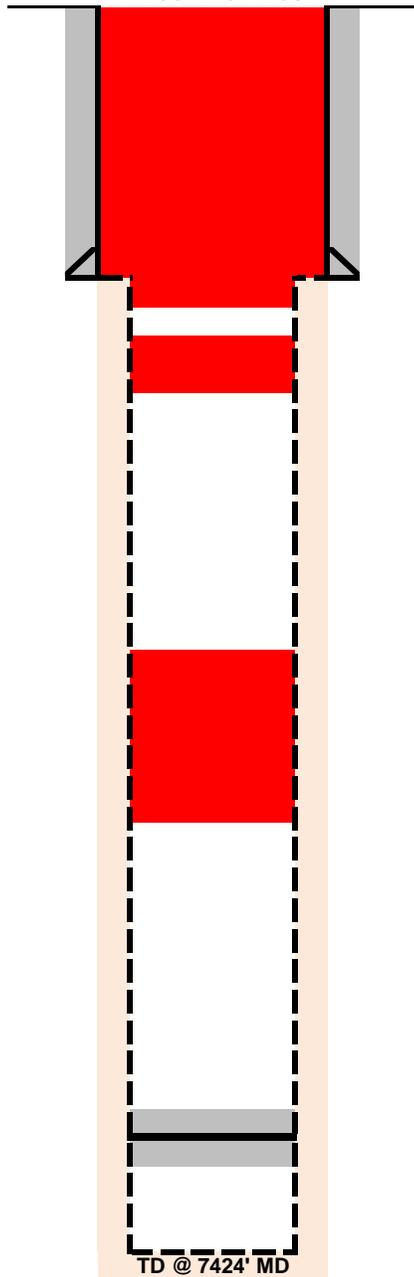

good returns to surface

8-5/8" set @ 307' (12-1/4" OH)  
Surface Plug @ 376' of 170 sks

Tagged plug @ 520'  
Balanced Plug @ 688' of 120 sks

TOC @ 2850'  
tagged plug

Balanced Plug @ 3128' of 120 sks

CIBP @ 6900

7-7/8" OH to TD

TD @ 7424' MD