


Lowe 1A



SI

API #	Lease ID	Permit #	County	KB	GL	Current production		Sec N/ Sec E/W	Sec	Formation	
05-063-06185			Kit Carson	4464'	4459'	3 BOPD	60 BWPD			Morrow	
	Pumping Unit	Motor	State	TD	PBTD	Initial production		Lease	Lease E/W	Blk	Svy
KB = 5'	CMI 456		CO	5780'	5674'	250 BOPD	0 BWPD				

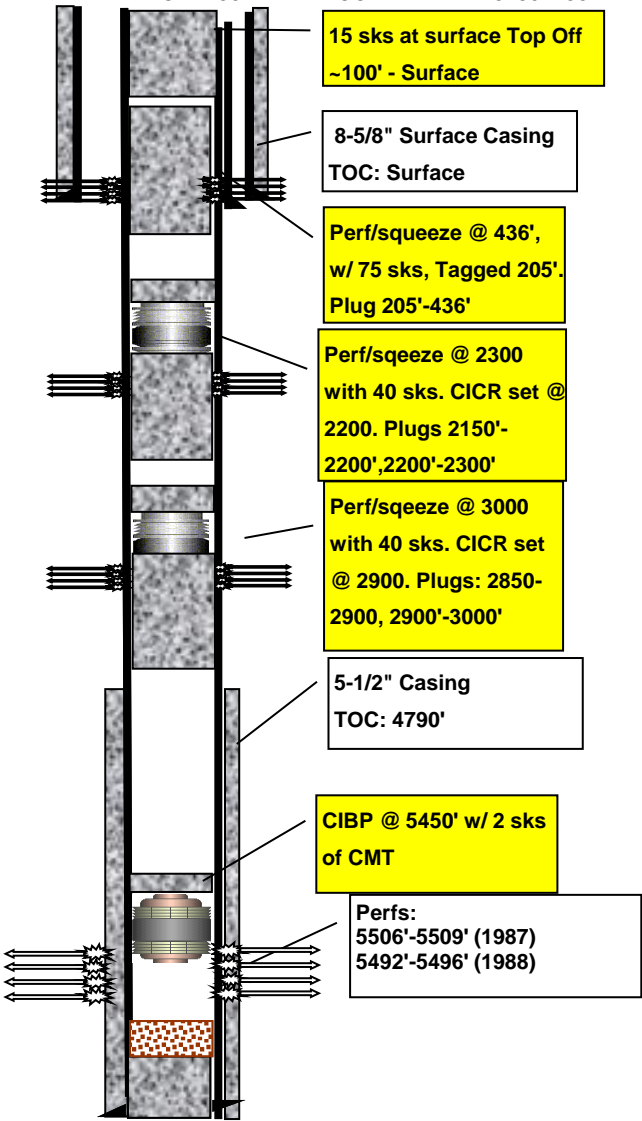

Perforations

Top	Bottom	SPF	Stimulation	OPEN?	
5506	5509		Acid (2010)?	1987	Yes
5492	5496		Acid	1988	Yes
5492'	5509'		Acid (2010)?	2000	Yes

Casing

Depth	Size	Wgt (# Grade	Description
386'	8-5/8"	24	
5780'	5-1/2"	17	

Cement

Casing	Sacks	TOC	Description	OD Hole	Washout
8-5/8"	150	Surface			
5-1/2"	150	4790			

Tubing

Description	Size	Length	Top	Bot
-------------	------	--------	-----	-----

Rods

Description	Size	Length	Top	Bot
-------------	------	--------	-----	-----

Lowe 1A



SI

API #	Lease ID	Permit #	County	KB	GL	Current production		Sec N/	Sec E/W	Sec	Formation
05-063-06185			Kit Carson	4464'	4459'	3 BOPD	60 BWPD				Morrow
	Pumping Unit	Motor	State	TD	PBTD	Initial production		Lease	Lease E/W	Blk	Svy
KB = 5'	CMI 456		CO	5780'	5674'	250 BOPD	0 BWPD				

Lowe 1A



SI

API #	Lease ID	Permit #	County	KB	GL	Current production		Sec N/	Sec E/W	Sec	Formation
05-063-06185			Kit Carson	4464'	4459'	3 BOPD	60 BWPD				Morrow
	Pumping Unit	Motor	State	TD	PBTD	Initial production		Lease	Lease E/W	Blk	Svy
KB = 5'	CMI 456		CO	5780'	5674'	250 BOPD	0 BWPD				