


API #	Lease ID	Permit #	County	KB	GL	Current production	Sec N/ Sec E/W	Sec	Formation	
05-063-06192			Kit Carson	4459'	4454'				Morrow	
	Pumping Unit	Motor	State	TD	PBTD	Initial production	Lease	Lease E/W	Blk	Svy
KB = 5'	AM 320		CO	5780'						

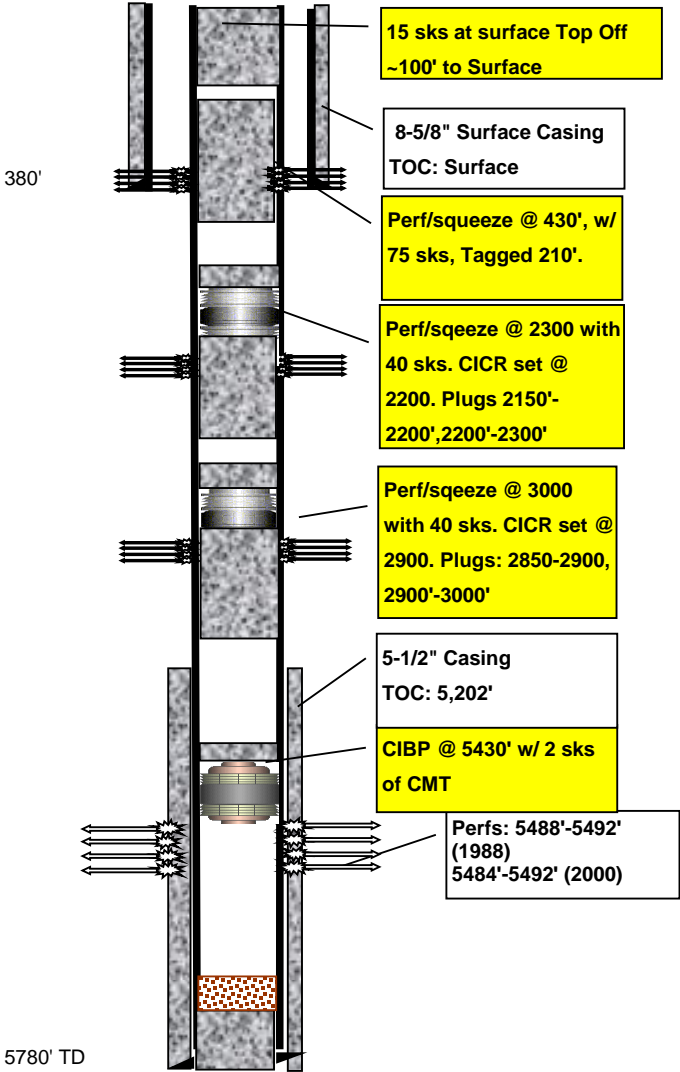

Perforations

Top	Bottom	SPF	Stimulation	OPEN?
5488	5492			1988
5484	5492			2000

Casing

Depth	Size	Wgt (# Grade)	Description
380'	8-5/8"		
5750'	5-1/2"		

Cement

Casing	Sacks	TOC	Description	OD Hole	Washout
8-5/8"	275				
5-1/2"	150	5202			

Tubing

Description	Size	Length	Top	Bot
-------------	------	--------	-----	-----

Rods

Description	Size	Length	Top	Bot
-------------	------	--------	-----	-----



API #	Lease ID	Permit #	County	KB	GL	Current production	Sec N/ Sec E/W	Sec	Formation	
05-063-06192			Kit Carson	4459'	4454'				Morrow	
	Pumping Unit	Motor	State	TD	PBTD	Initial production	Lease	Lease E/W	Blk	Svy
KB = 5'		AM 320	CO	5780'						



API #	Lease ID	Permit #	County	KB	GL	Current production	Sec N/ Sec E/W	Sec	Formation	
05-063-06192			Kit Carson	4459'	4454'				Morrow	
	Pumping Unit	Motor	State	TD	PBTD	Initial production	Lease	Lease E/W	Blk	Svy
KB = 5'		AM 320	CO	5780'						