




00256574

CERTIFICATE OF SURVEY
for
Kenneth Beckold
Jackson County, Colorado

RECEIVED

OCT 9 1979

COLO. OIL & GAS CONS. COMM.

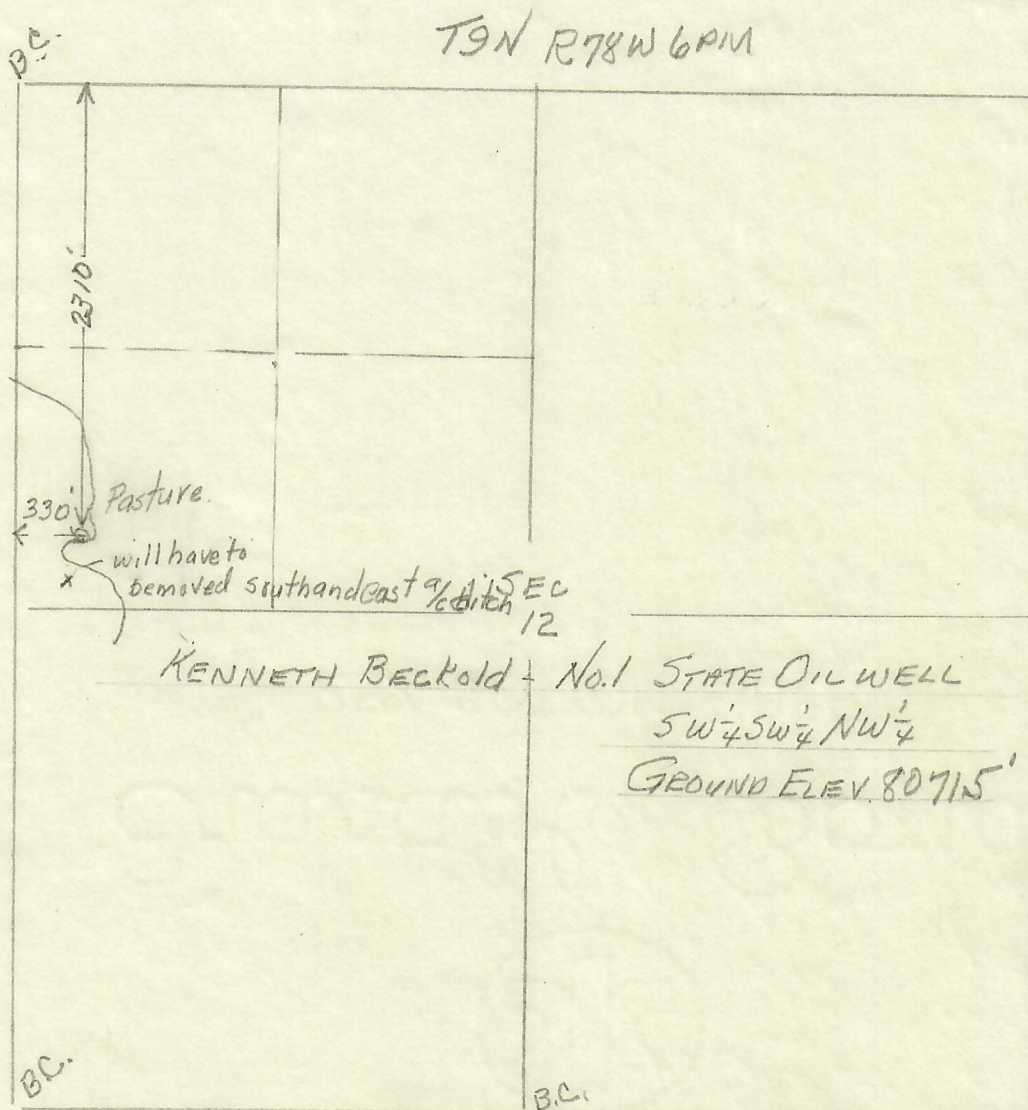

I hereby certify that the above plat is an accurate representation of a correct survey showing the location of ~~Kenneth Beckold~~ ^{Beckold} No. 1 State Oilwell in SW 1/4 SW 1/4 NW 1/4 Sec. 12 T9N R78W 6PM. The elevation of the ground at the stake is 8071.5 feet above sea level from U.S.G.S. Bench Mark.

Fort Morgan, Colorado
Aug. 14, 1979

Leslie J. Osborne
Registered Professional Engineer
State of Colorado

BEST COPY
AVAILABLE

RECEIVED