




1 Mile Offset
No PR Sussex
Deepest WW: 60'

WELLBORE DIAGRAM

CURRENT WBD

661' FNL & 661' FEL

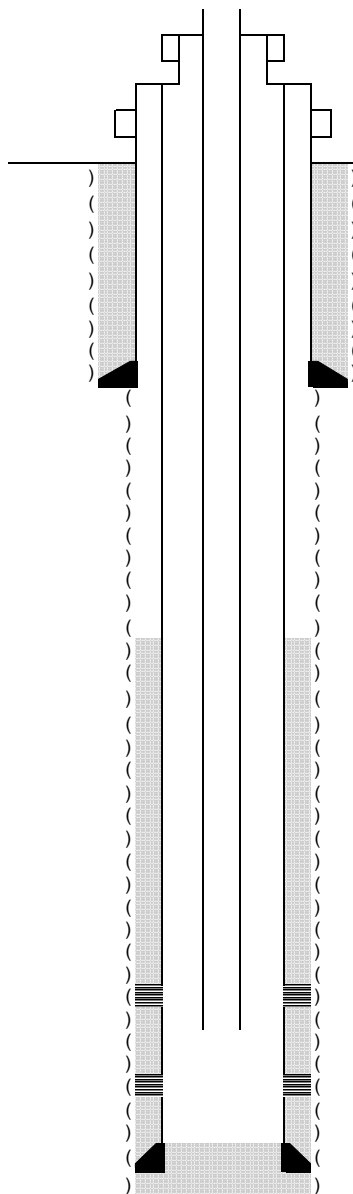

TVD =
MD = 7351'

PBTVD =
PBMD = 7301'

Operator: Great Western Operating Co. LLC
Well Name: Hood 41-20
Lease Number:
Location: NENE S20-T6N-R66W
Field: Wattenberg - #90750
County, State: Weld, CO
API Number: 05-123-32829
Diagram Date: 4/22/2018
Lat/Long: 40.47905, -104.794845

KB ' 4774'

GL ' 4760'

Spud Date: 12/18/2011
Date TD Reached 12/21/2011
Completion Date: 1/6/2012

Surface Casing
(12-1/4" Hole Size) 8-5/8" 24# csg set @ 685'
w/ 490 sx cmt

Production casing
(7-7/8" Hole Size) 4-1/2" 11.6# csg set @ 7316'
w/ 540 sx cmt.

Tubing
2-3/8" tbg set @ 7159'
Jan. 2012

TOC = 2550' (CBL)

Formation Tops (MD)

Greeley Sand 2608'
Parkman 3604'
Sussex 4310'
Shannon 4755'
Niobrara 6853'
Fort Hays 7145'
Codell 7167'

Perforations

Niobrara
6853-7086'

Codell
7169-7182'