


Well Name: TREBOR B11-23

VERTICAL, ORIGINAL HOLE, 2/8/2019 10:41:43 AM

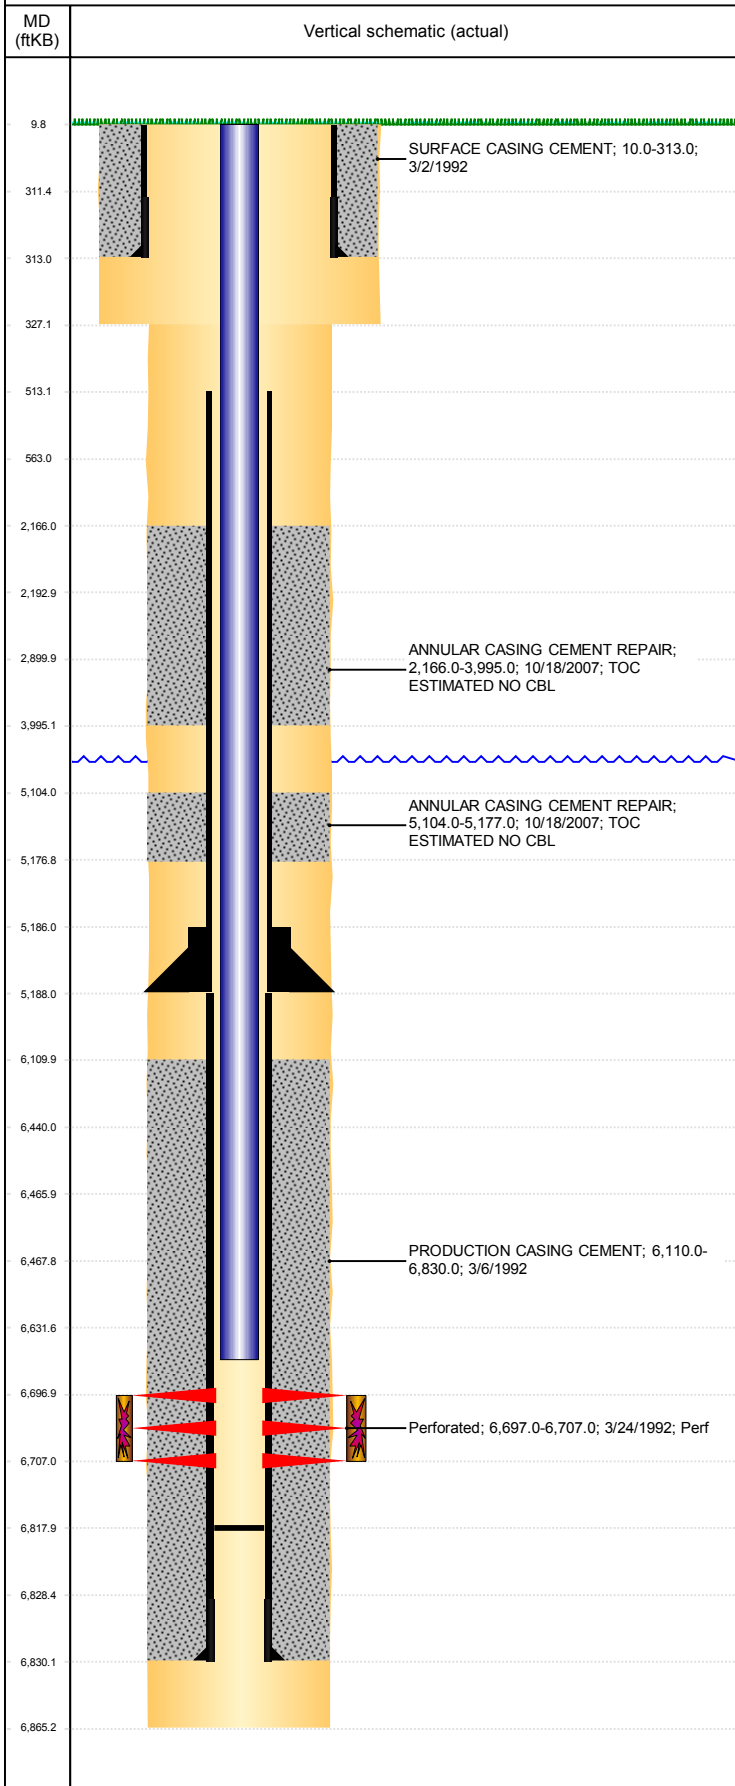

Well Header									
API 05-123-15625		Business Unit DJ BASIN			District 15		Well Config VERTICAL		
KB - GL / MSL (ft... 10.00		Spud Date 3/2/1992		P & A Date		Well Production Status SI		SoRT No	
Comment									
Surface Location (Congressional)									
Qtr 3 NW	Qtr 4 SE	Section 11	Twنشp 5	Twنش... N	Range 64	Rng E... W	Actual Latitude (°) 40.41016242	Actual Longitude (°) -104.51288619	
Wellbore Sections									
Section Des			Size (in)			Act Top, MD (ftKB)		Act Btm, MD (ftKB)	
SURFACE			12 1/4			10		327	
PRODUCTION			7 7/8			327		6,865	
Casing Strings									
Csg Des			Run Date	OD (in)	Wt/Len (lb/ft)	Grade	Top, MD (ftKB)	MD (ftKB)	
Surface			3/2/1992	8 5/8	24.00	K-55	10.0	313.0	
Production			10/16/2007	2 7/8	6.50	N-80	10.0	5,188.0	
Production			3/6/1992	2 7/8	7.90	N-80	10.0	6,830.0	
Cement									
Des				Start Date		Top (ftKB)		Btm (ftKB)	
SURFACE CASING CEMENT				3/2/1992		10.0		313.0	
PRODUCTION CASING CEMENT				3/6/1992		6,110.0		6,830.0	
ANNULAR CASING CEMENT REPAIR				10/18/2007		2,166.0		3,995.0	
ANNULAR CASING CEMENT REPAIR				10/18/2007		5,104.0		5,177.0	
Zone Statuses									
Zone Name		Status Date	Status	Fluid Type	Job			Prod Method	
CODELL		5/9/2011	PR	Water				Flowing	
CODELL		5/9/2017	SI						
Perforation Data									
Linked Zone			Bnch/Stg	Entered Shot Total	Top (ftKB)		Btm (ftKB)		Date
CODELL, ORIGINAL HOLE				40	6,697.00		6,707.00		3/24/1992
Stimulation Intervals									
Zone				Start Date		Top (ftKB)		Btm (ftKB)	
CODELL, ORIGINAL HOLE				3/26/1992		6,697.0		6,707.0	
Other In Hole									
Run Date		Des				OD (in)	Top (ftKB)	Btm (ftKB)	
Logs									
Date		Type				Top, MD (ftKB)		Btm, MD (ftKB)	
3/6/1992		COMPENSATED DENSITY				3,345.0		6,858.0	
3/24/1992		CEMENT BOND				5,916.0		6,790.0	
Plug Back Total Depths									
Date		Type		Com				Depth (ftKB)	
3/6/1992		GUIDE SHOE						6,827.0	
10/19/2007		FILL						6,818.0	