

COGCC

BEST IMAGE  
AVAILABLE

CERTIFICATE OF SURVEY  
for  
Williams, Schmidke  
Washington County, Colorado

RECEIVED


DEC 15 1978

OIL &amp; GAS COM. CO.



00064525

T2N R52W 6PM

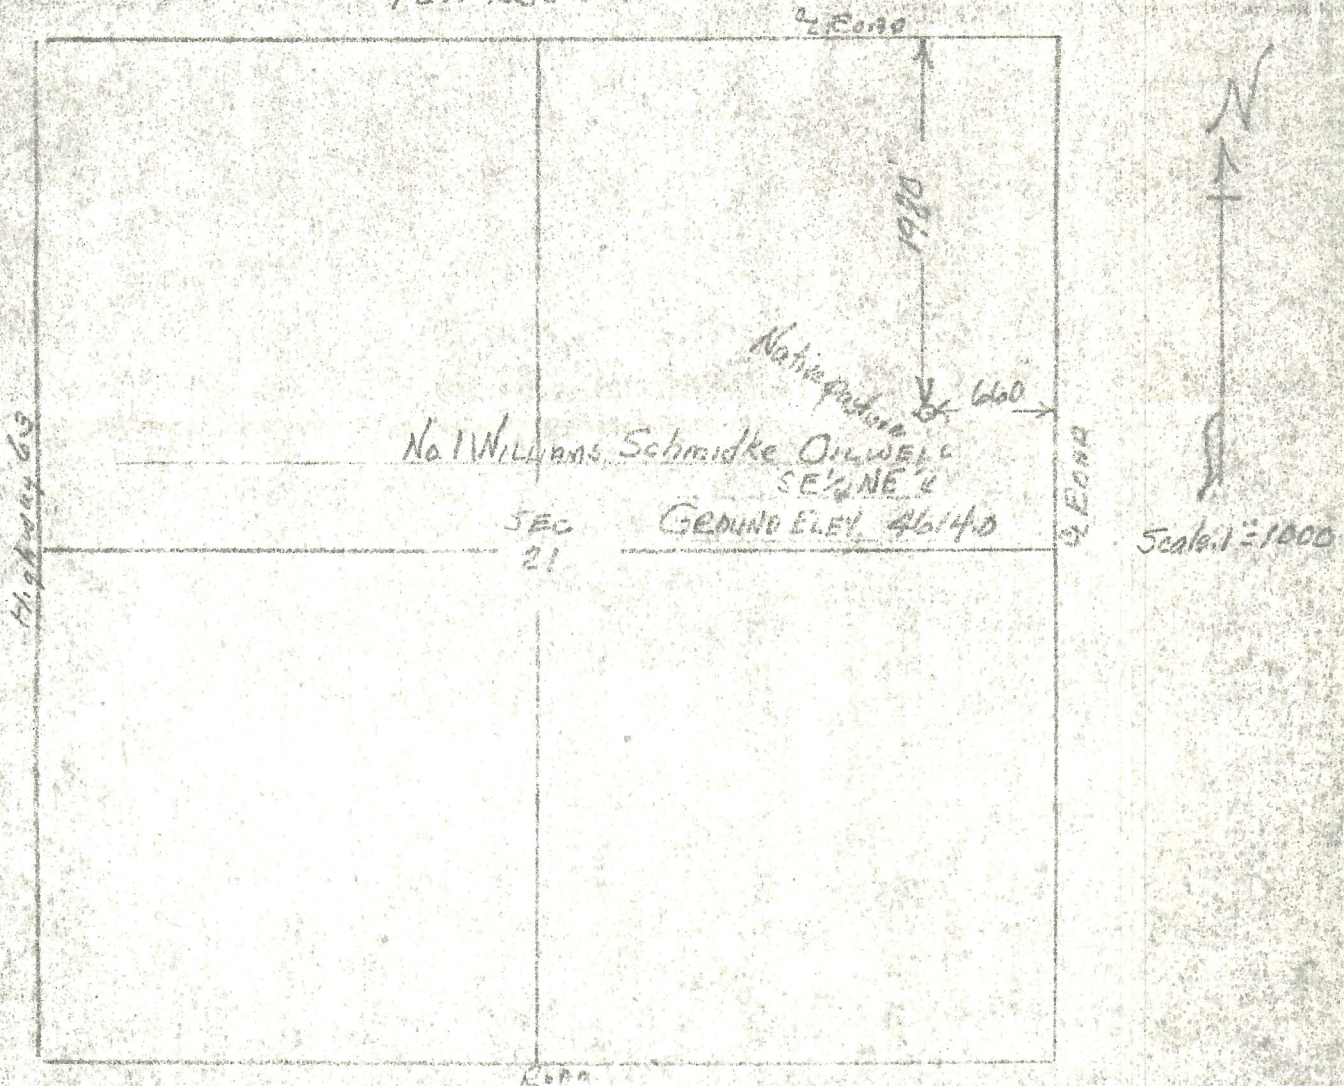

I hereby certify that the above plat is an accurate representation of a correct survey showing the location of No. 1 Williams, Schmidke Oilwell in SE 1/4 NE 1/4 Sec. 21 T2N R52W 6PM. The elevation of the ground at the stake is 4614.0 feet above sea level from U.S.G.S. Bench Mark.

Fort Morgan, Colorado  
Nov. 17, 1978

*Leslie J. Chabone*  
Registered Professional Engineer  
State of Colorado

Permit # 78-1219

BEST IMAGE  
AVAILABLE