


Well Name: SPIKE STATE D14-11

VERTICAL, ORIGINAL HOLE, 2/19/2019 1:08:54 PM

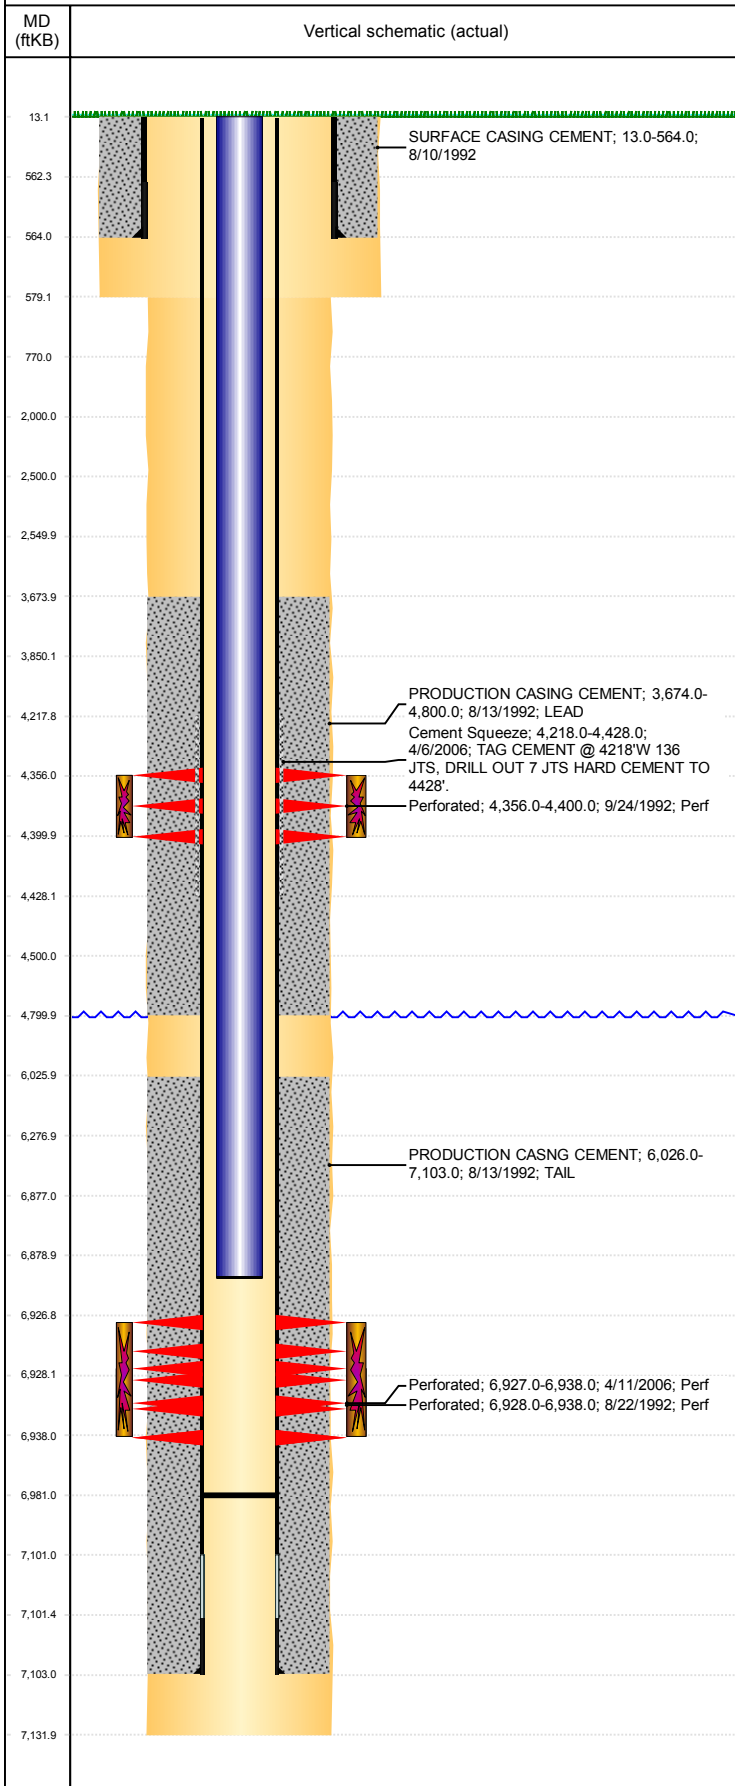

Well Header									
API 05-123-16032		Business Unit DJ BASIN		District 15		Well Config VERTICAL			
KB - GL / MSL (ft... 13.00		Spud Date 8/9/1992		P & A Date		Well Production Status PR			SoRT No
Comment DISCREPANCY ON PBTD: STATE - 6700', REPORT - 6980'; USED 6700'. INFO OF 2ND CODELL PERF 9/9/92- COULDN'T GET TO BOTTOM, INCOMPLETE OPERATION; & TREATMENT RPT FOR 2ND CODELL FRAC 9/12/92.									
Surface Location (Congressional)									
Qtr 3 NE	Qtr 4 SW	Section 14	Twnshp 3	Twnsh... N	Range 64	Rng E/... W	Actual Latitude (") 40.22396550		Actual Longitude (") -104.52016203
Wellbore Sections									
Section Des		Size (in)		Act Top, MD (ftKB)		Act Btm, MD (ftKB)			
SURFACE		12 1/4		13		579			
PRODUCTION		7 7/8		579		7,132			
Casing Strings									
Csg Des		Run Date	OD (in)	Wt/Len (lb/ft)	Grade	Top, MD (ftKB)		MD (ftKB)	
Surface		8/10/1992	8 5/8	24.00		13.0		564.0	
Production		8/13/1992	3 1/2	9.30	N-80	13.0		7,103.0	
Cement									
Des			Start Date		Top (ftKB)		Btm (ftKB)		
SURFACE CASING CEMENT			8/10/1992		13.0		564.0		
PRODUCTION CASING CEMENT			8/13/1992		3,674.0		4,800.0		
PRODUCTION CASNG CEMENT			8/13/1992		6,026.0		7,103.0		
Cement Squeeze			4/6/2006		4,218.0		4,428.0		
Zone Statuses									
Zone Name	Status Date	Status	Fluid Type	Job			Prod Method		
SUSSEX	3/13/1993	PR		COMMINGLE ZONES, 3/13/1993 00:00			Flowing		
SUSSEX	4/6/2006	AB							
CODELL	3/13/1993	PR		COMMINGLE ZONES, 3/13/1993 00:00			Flowing		
CODELL	4/20/2006	PR		RE-FRAC, 4/4/2006 00:00			Flowing		
Perforation Data									
Linked Zone		Bnch/Stg	Entered Shot Total	Top (ftKB)		Btm (ftKB)		Date	
SUSSEX, ORIGINAL HOLE			60	4,356.00		4,400.00		9/24/1992	
CODELL, ORIGINAL HOLE			44	6,927.00		6,938.00		4/11/2006	
CODELL, ORIGINAL HOLE			40	6,928.00		6,938.00		8/22/1992	
Stimulation Intervals									
Zone			Start Date		Top (ftKB)		Btm (ftKB)		
SUSSEX, ORIGINAL HOLE			9/24/1992		4,356.0		4,400.0		
CODELL, ORIGINAL HOLE			4/19/2006		6,927.0		6,938.0		
CODELL, ORIGINAL HOLE			8/29/1992		6,928.0		6,938.0		
CODELL, ORIGINAL HOLE			9/12/1992		6,928.0		6,938.0		
Other In Hole									
Run Date		Des			OD (in)	Top (ftKB)		Btm (ftKB)	
Logs									
Date		Type				Top, MD (ftKB)		Btm, MD (ftKB)	
8/13/1992		COMPENSATED DENSITY				3,980.0		7,103.0	
8/13/1992		INDUCTION				3,980.0		4,580.0	
8/21/1992		CEMENT BOND				3,590.0		6,988.0	
8/22/2017		GYRO				0.0		6,800.0	
Plug Back Total Depths									
Date		Type		Com				Depth (ftKB)	
8/21/1992		FILL		DEPTH LOGGER ON CBL				6,993.0	
4/26/2006		FILL		TAG FILL				6,981.0	