

Project MUSTANG IDP (PW TEST) AFE/Work Order No. 5000005

Pipeline DP406 to C-5 Water Disposal 8" 40.1121, -104.5691
(Name) (Location)

Testing Contractor Nitrogen Services LLC

Pipe O.D. 8" Wall thickness. .74 Grade _____ MFG'R: Flex Steel

Test Fluid Water Additive _____

Test Location: C-5 SWD Section No. _____

Instrumentation: Refinery Supply # 5366 Dead Weight
(Location) (Type)
Refinery Supply 5366 2-5-18
(Mfg'r) (S/N) (Date Calibrated)

Time	Pressure PSIG	Ambient Temp.
10:30	1017	68
10:45	1017	70
11:00	1016	72
11:15	1016	74
11:30	1015	74
11:45	1015	75
12:00	1014	76
12:15	1014	78
12:30	1014	78
12:45	1014	78
13:00	1014	79

Time	Pressure PSIG	Ambient Temp.
13:15	1014	79
13:30	1014	80
13:45	1013	80
14:00	1013	80
14:15	1013	80
14:30	1013	82
14:45	1013	82
15:00	1012	82
15:15	1012	82
15:30	1012	82
15:45	1011	82

Time	Pressure PSIG	Ambient Temp.
16:00	1011	82
16:30	1011	82
17:00	1010	83
17:30	1010	82
18:00	1008	82
18:30	1007	81
18:45	1007	

Test Started 10:30 AM/PM 5/25/2018 DK Test Ended 18:30 AM/PM 5/25/2018 DK
(Time) (Date) (Time) (Date)

Remarks: HUDDT-PL-PPW-PLI-DAG-0001, 0002, 0003, 0004, 0005, 0006,
0007, 0008, 0009, 0010. STA# 1+28 TO STA# 36+77 = 36.049 ft

Weather: _____

Testing Contractor's Representative Mike Spratlen PM [Signature] 5-25-18
(Name) (Title) (Signature) (Date)

Constr. Contractor's Representative Kelly Longworth PM [Signature] 5-25-18
(Name) (Title) (Signature) (Date)

Company Representative Bo Canady Inspector [Signature] 5/25/18
(Name) (Title) (Signature) (Date)

Construction Superintendent Danny Kitchell SUPER [Signature] 5/25/18
(Name) (Title) (Signature) (Date)


Time	Pressure	Ambient	Ground	Pipe	Comments
7:00	753	56	56	68	Holding Ser 1 Hour
7:15	749	58	56	69	
7:30	746	59	56	70	
7:45	744	60	56	71	
8:00	744	61	56	72	Pressuring to Test
8:15	825	61	54	73	
8:30	935	62	54	74	
8:45	1002	62	54	74	Holding
9:00	997	62	54	74	Pressuring to 1026
9:15	1025	63	54	76	Holding
9:30	1023	64	54	76	
9:45	1020	66	54	77	
10:00	1019	66	54	78	
10:15	1018	67	53	80	
10:30	1017	68	53	80	On test
10:45	1017	70	53	82	
11:00	1016	72	53	82	
11:15	1016	74	53	84	
11:30	1015	74	53	85	
11:45	1015	75	53	87	
12:00	1014	76	53	88	
12:15	1014	78	52	90	
12:30	1014	78	52	90	
12:45	1014	78	52	92	
13:00	1014	79	52	93	
13:15	1014	79	52	94	
13:30	1014	80	52	95	
13:45	1013	80	52	96	
14:00	1013	80	52	97	
14:15	1013	80	52	97	
14:30	1013	82	52	98	
14:45	1013	82	52	99	
15:00	1012	82	52	100	
15:15	1012	82	52	100	
15:30	1012	82	52	101	
15:45	1011	82	52	102	
16:00	1011	82	52	102	
16:15	1011	82	52	103	
16:30	1011	82	52	103	
16:45	1011	83	51	103	
17:00	1010	83	51	102	

W. H. Putt

J. C. Coady - m. p. l. t.

Time	Pressure	Ambient	Ground	Pipe	Comments
17:15	1010	83	51	103	
17:30	1010	82	51	103	
17:45	1009	82	51	103	
18:00	1008	82	51	102	
18:15	1008	82	51	102	
18:30	1007	81	51	102	off TEST
18:45	1007				Blowing down
19:00	752				@ 6:50
19:15	755				Blowing
19:30	504				
19:45	503				
20:00	250				
20:20	252				
20:30					
20:45					
21:00					
21:15					
21:30					
21:45					
22:00					

W.B. Put
1/2
Landy-molt

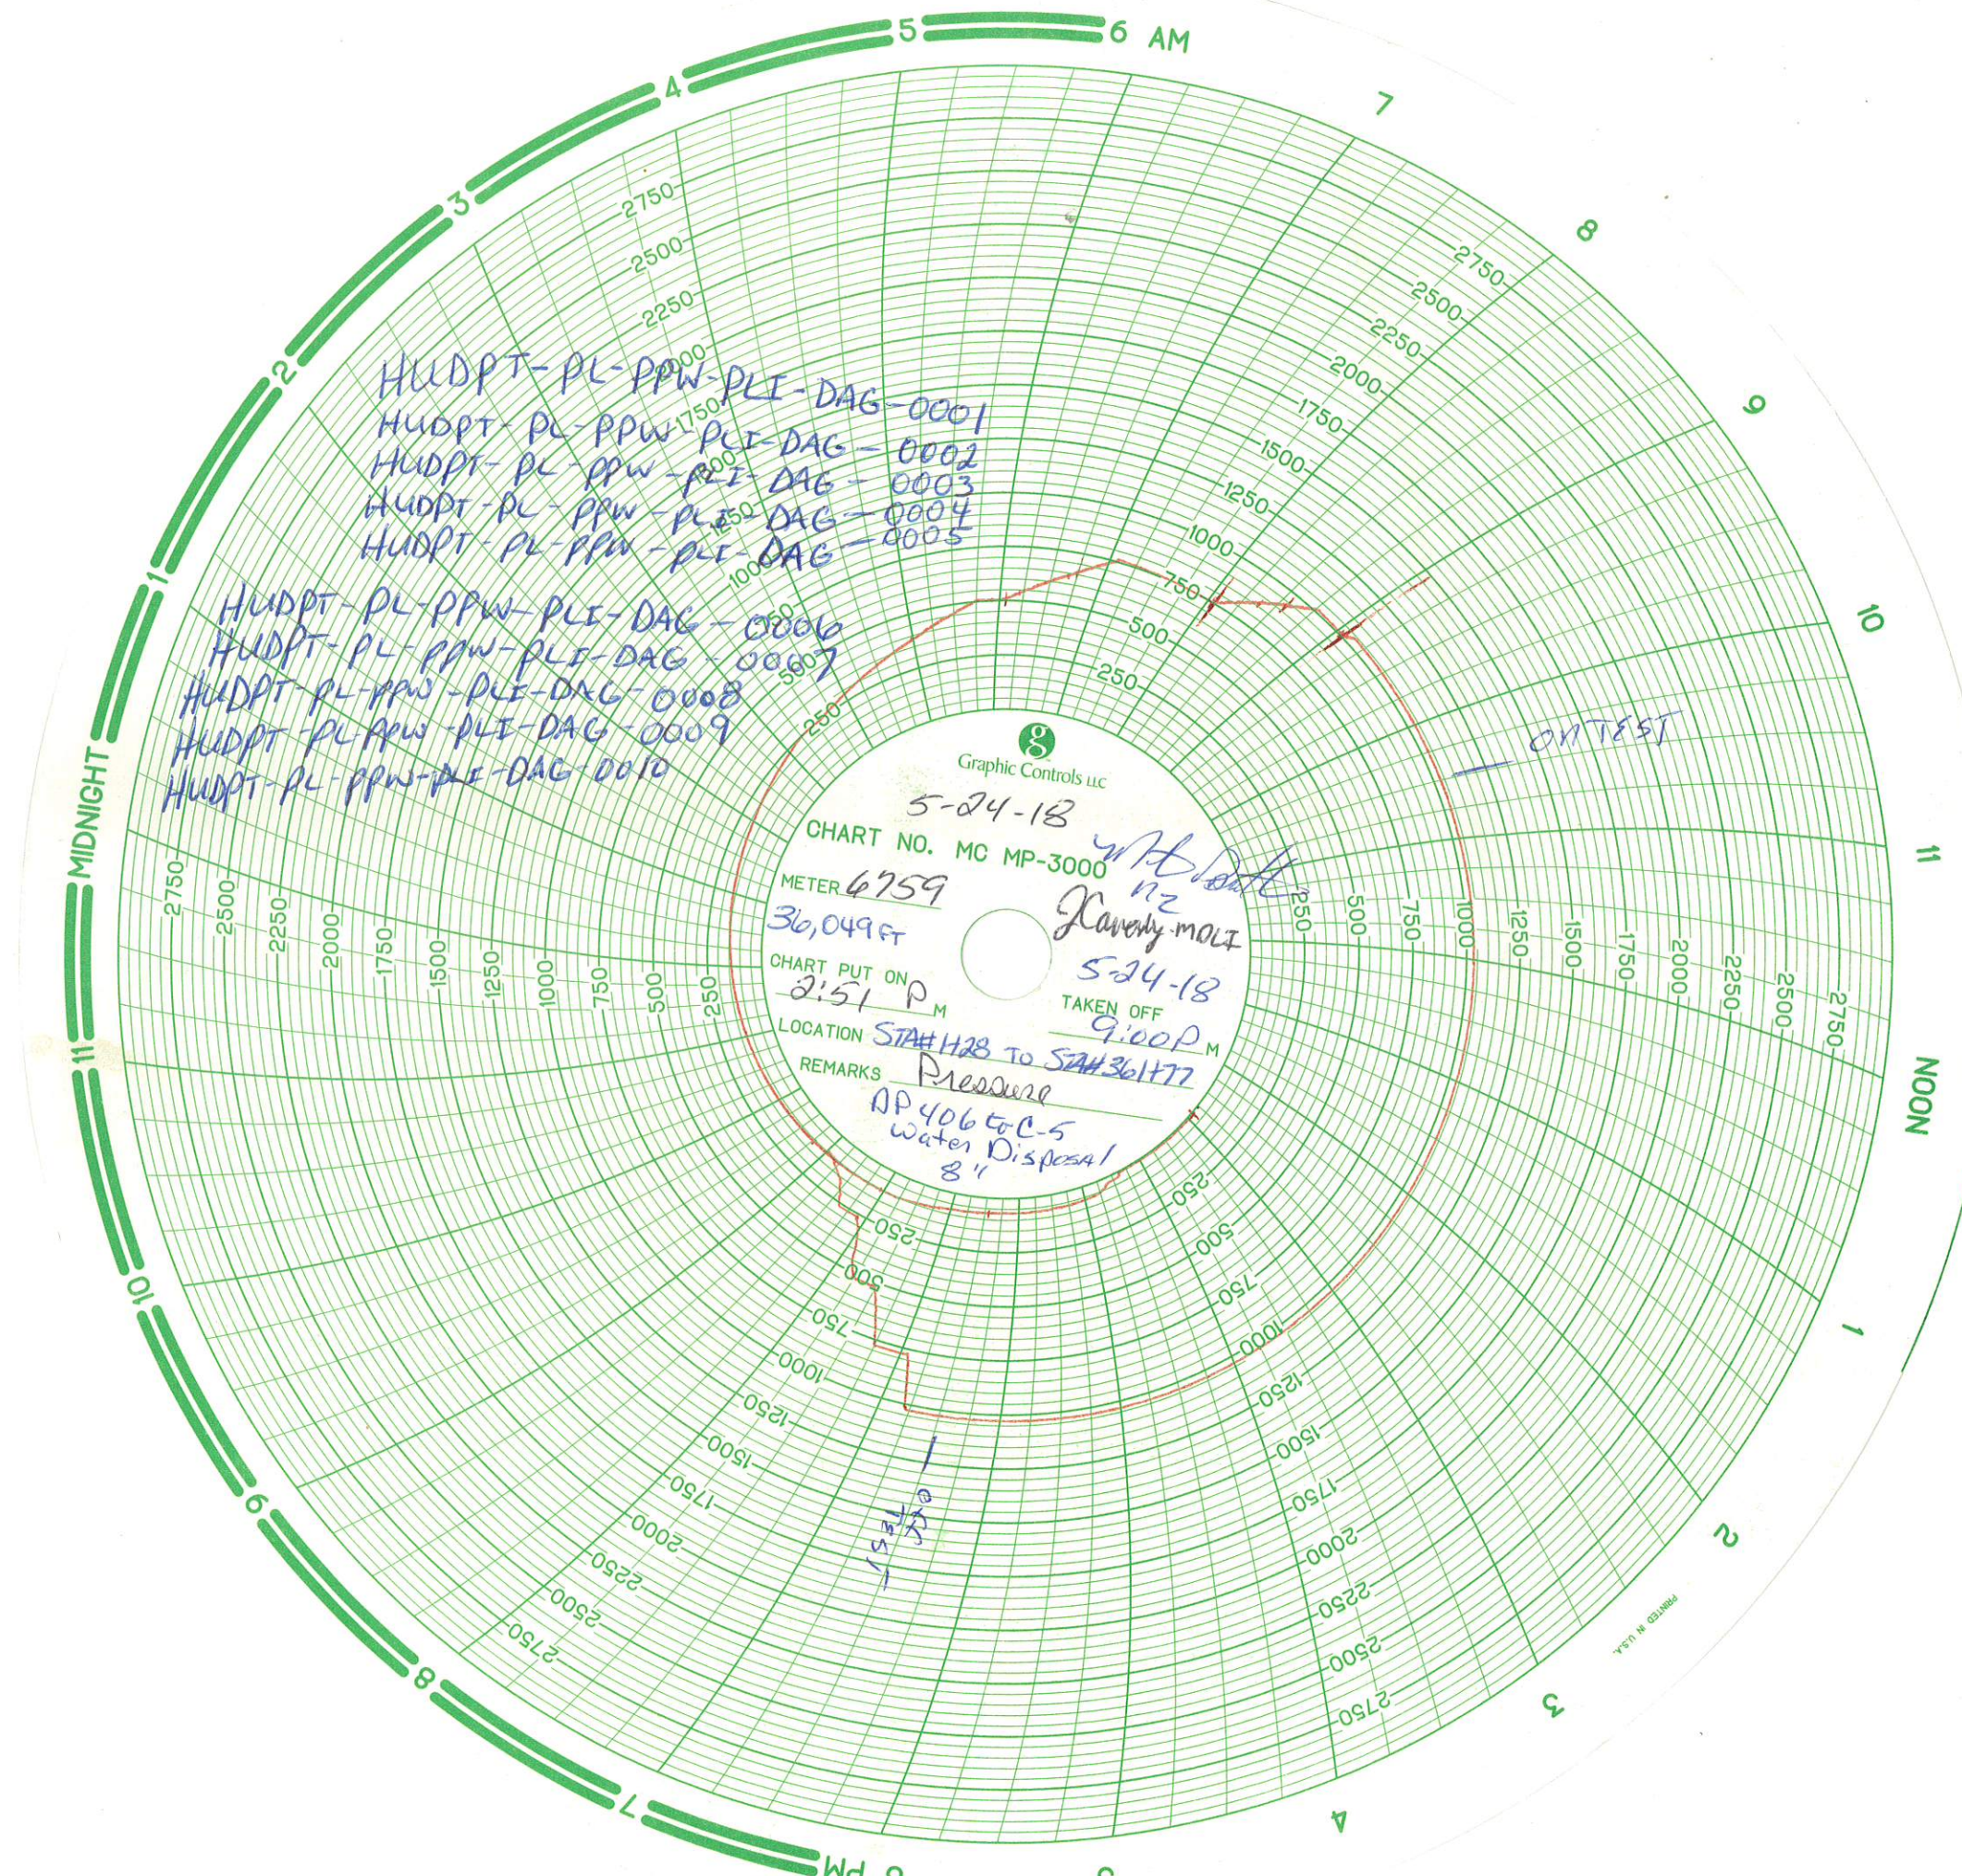


HUDPT-PL-PPW-PLI-DAG-0001
HUDPT-PL-PPW-PLI-DAG-0002
HUDPT-PL-PPW-PLI-DAG-0003
HUDPT-PL-PPW-PLI-DAG-0004
HUDPT-PL-PPW-PLI-DAG-0005
HUDPT-PL-PPW-PLI-DAG-0006
HUDPT-PL-PPW-PLI-DAG-0007
HUDPT-PL-PPW-PLI-DAG-0008
HUDPT-PL-PPW-PLI-DAG-0009
HUDPT-PL-PPW-PLI-DAG-0010

5-24-18
CHART NO. MC MP-3000
METER 6759
36,049 FT
CHART PUT ON 2:51 P.M.
LOCATION STA# H28 TO STA# 361+77
REMARKS Pressure
AP 406 to C-5
Water Disposal
8"

W.H. Dault
n2
Karely moli
5-24-18
TAKEN OFF 9:00 P.M.

ON TEST

ON TEST

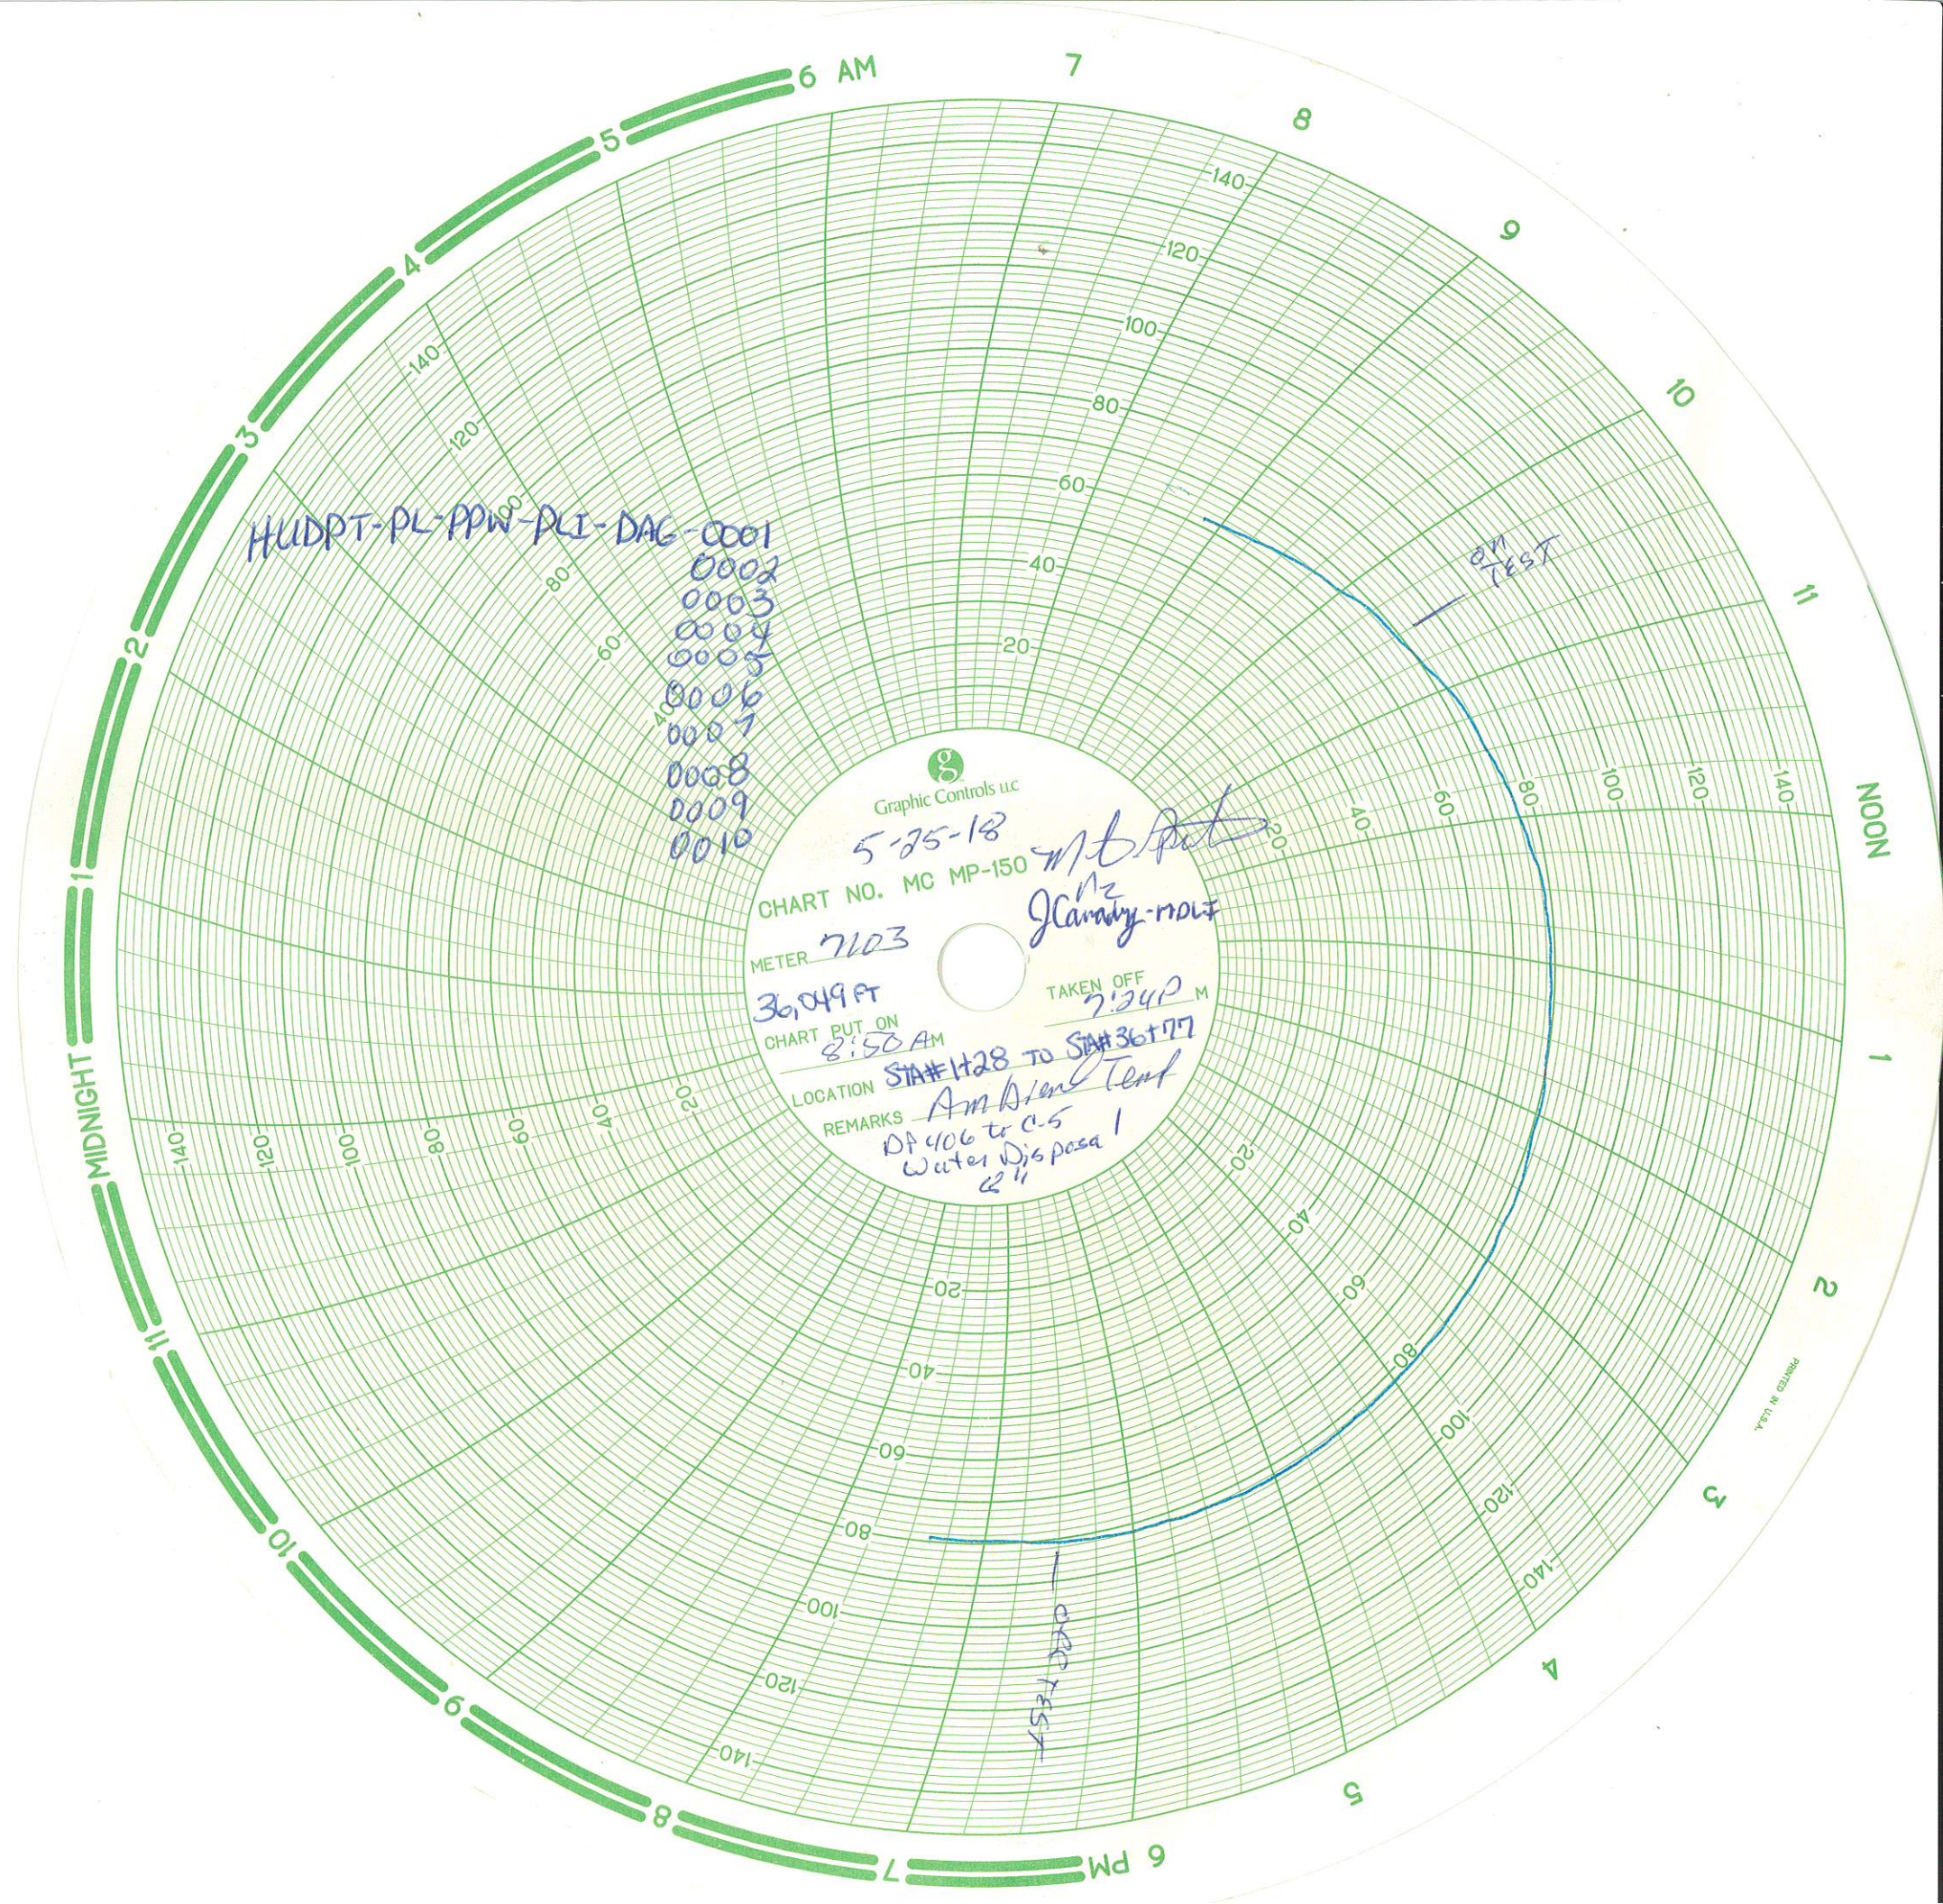

HUDPT-PL-PPW-PLI-DAG-0001

- 0002
- 0003
- 0004
- 0005
- 0006
- 0007
- 0008
- 0009
- 0010

Graphic Controls LLC

5-25-18

CHART NO. MC MP-150

METER 7103

36,049 FT

CHART PUT ON 8:50 AM


LOCATION STA#1428 TO STA#36177

REMARKS Am Bient Test
DP 406 to 0.5
Water Disposa 1
24

TAKEN OFF 7:24 PM

AM TEST

PM TEST

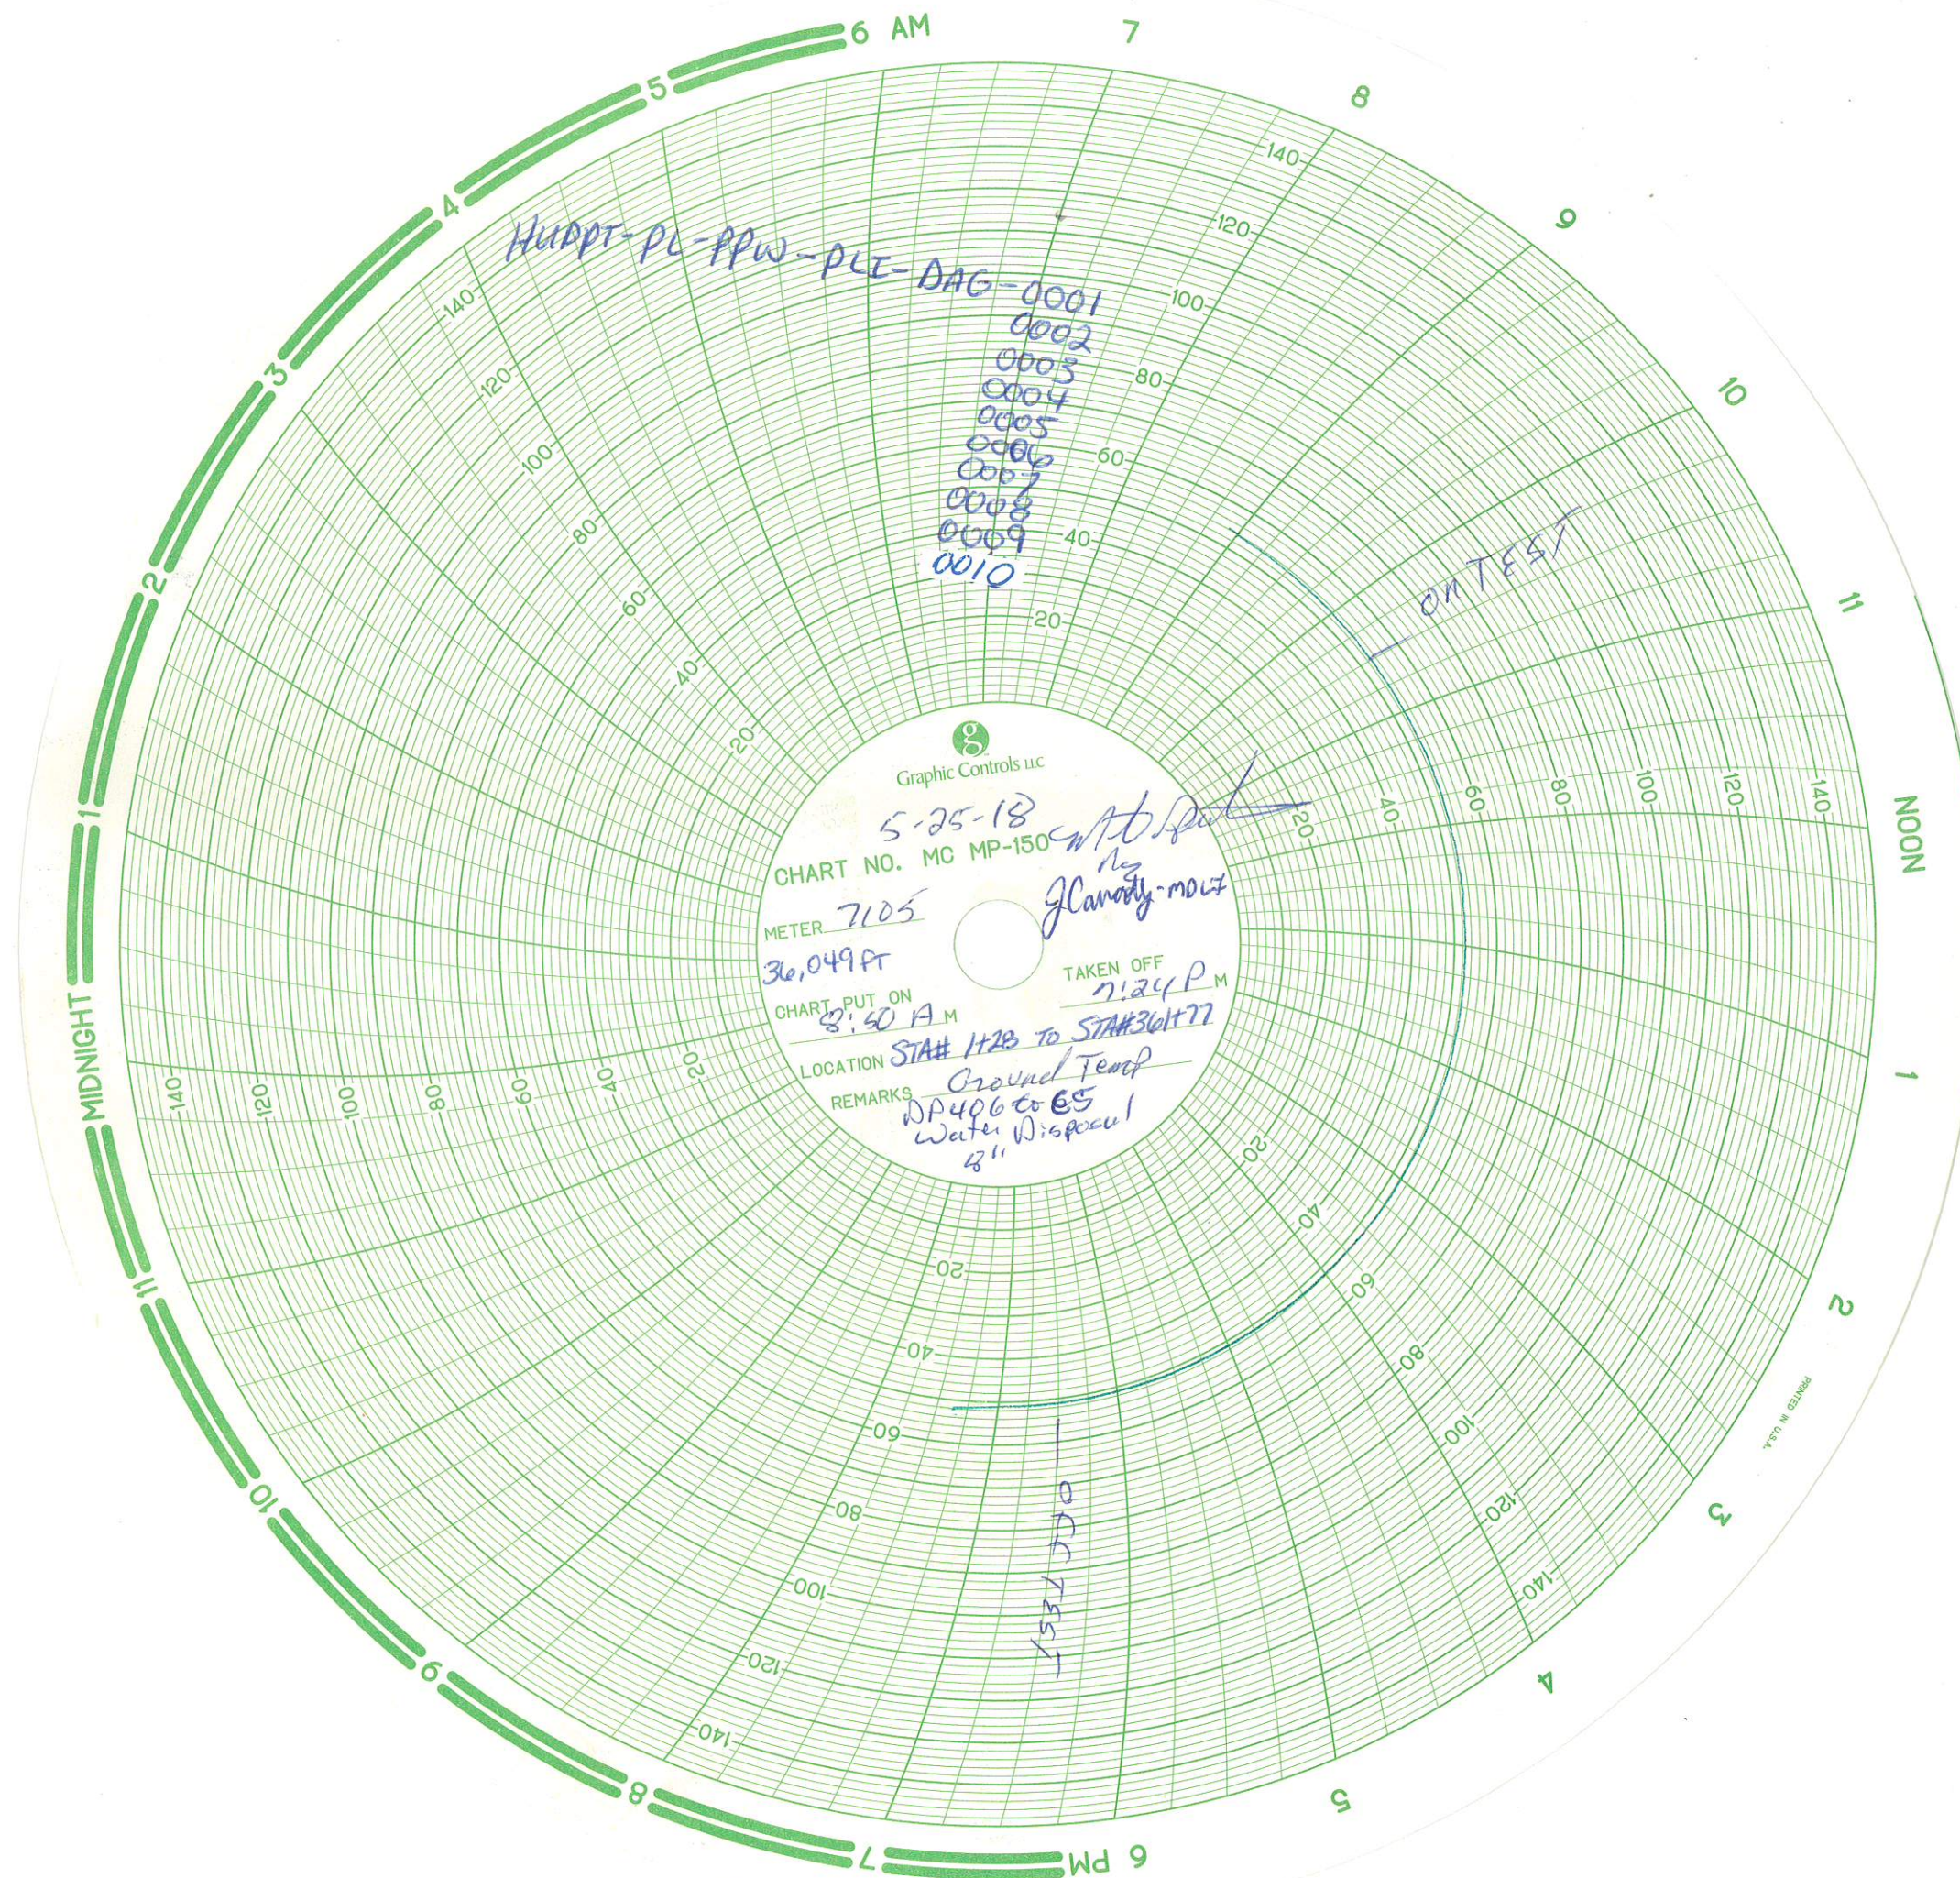

HURPT-PL-PPW-PLI-DAG-0001
0002
0003
0004
0005
0006
0007
0008
0009
0010

ON TEST


OFF TEST

Graphic Controls Inc
5-25-18
CHART NO. MC MP-150
METER 7105
36,049 ft
REMARKS Ground Temp
DP406 to 65
Water Disposal
8"

TAKEN OFF 7:24 P.M.

By J. Carody-mout

W. H. D. Put

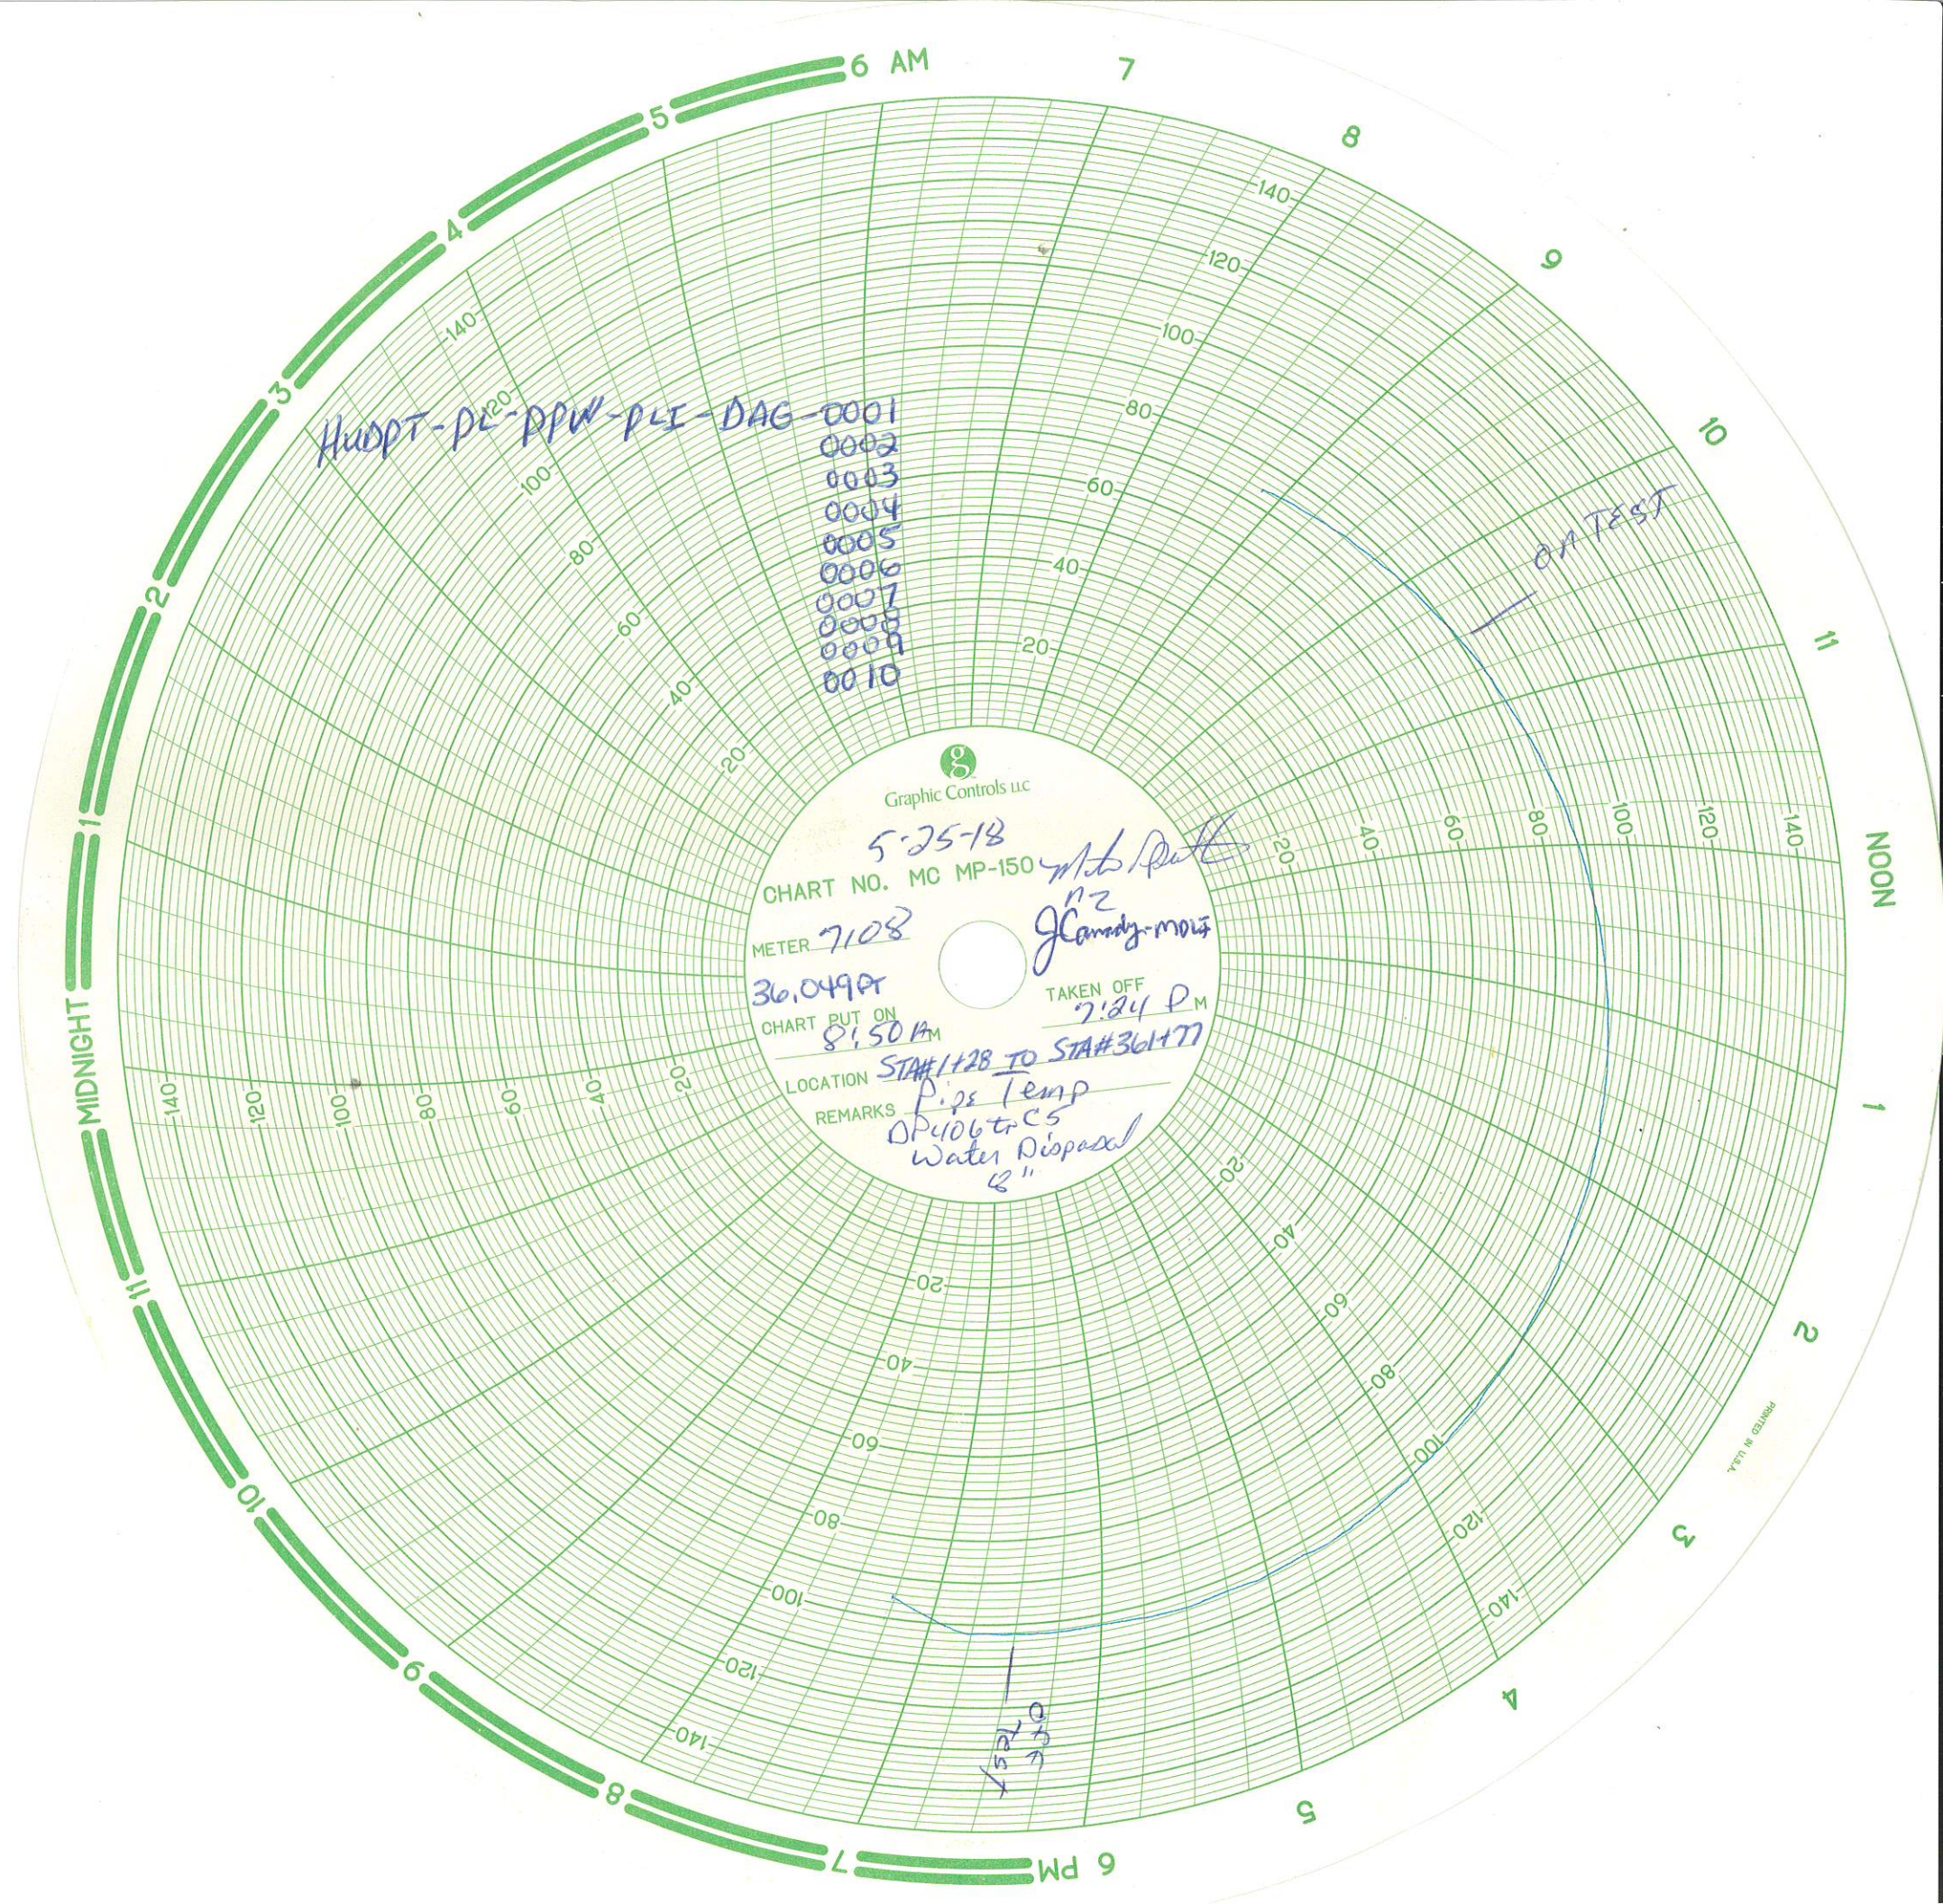

PSS-COMPANIES



9700 E. 104TH AVE, UNIT F- HENDERSON, CO 80640 - Phone (303)857-7986 - Fax (303)389-4945

CALIBRATION CERTIFICATE

CERTIFICATE NUMBER: CO

Details +/- 1.0% ACCURACY

DATE CALIBRATED: 02/05/2018

DUE DATE: 02/05/2019

INDICATED TEMPERATURE RANGE: # 0 – 150°F

INDICATED PRESSURE RANGE: #0 – 3000 PSI

SERIAL NO: 6759

MANUFACTURER: CHARTS LTD/ 12" RECORDER

TYPE OF INSTRUMENT CALIBRATED: TEMPERATURE / PRESSURE RECORDER

INSTRUMENT FINDINGS/STATUS: UNIT IS IN TOLERANCE/ INSTRUMENT MEETS OR EXCEEDS SPECIFICATIONS.

BASED ON INTERNATIONAL STANDARDS OF GRAVITY: (980.665 cm./sq.).

TYPE OF STANDARD USED TO CALIBRATE: REFINERY DEADWEIGHT TEST UNIT SPT. (35225-3) SERIAL No. 5268: KESSLER TEST THERMOMETERS: SERIAL NO. CALIBRATION

ALL STANDARD DIRECTLY TRACEABLE TO NATIONAL INSTITUTE OF STANDARDS & TECHNOLOGIES TEST NO: (N.I.S.T.) 2.6/172490 & 6.6/139577.

CALCULATED USING MASS VALUES, AREA, AO, AND STATED GRAVITY.
ROOM TEMPERATURE/HUMIDITY (AT TIME OF TEST): 66°F / 25%.

CALIBRATED BY: NICK BEDFORD



SIGNATURE

P-SS-SS-COMPANIES



9700 E. 104th Ave. Unit H Henderson, CO 80640

CALIBRATION CERTIFICATE

CERTIFICATE NUMBER: CO

Details +/-: 1.0% ACCURACY

DATE CALIBRATED: 02-05-2018

DUE DATE: 02-05-2019

INDICATED TEMPERATURE RANGE: # 0 – 150°F

SERIAL NO: 7103

MANUFACTURER: CHARTS LTD COMPANY 12" RECORDER

TYPE OF INSTRUMENT CALIBRATED: TEMPERATURE RECORDER.

INSTRUMENT FINDINGS/STATUS: UNIT IS IN TOLERANCE/ INSTRUMENT MEETS OR EXCEEDS SPECIFICATIONS.

BASED ON INTERNATIONAL STANDARDS OF GRAVITY: (980.665 cm./sq.).

TEMPERATURE COEFFICIENT (Ac + AP): 25.9 x e-06 1/°C (14.4 X E-06 1/°F).

TYPE OF STANDARD USED TO CALIBRATE: TEMPERATURE BATHE USING TAYLOR TEST THERMOMETERS; SERIAL NO: 63F6165, 64F2744, 65F3056.

ALL STANDARD DIRECTLY TRACEABLE TO NATIONAL INSTITUTE OF STANDARDS & TECHNOLOGIES TEST NO: (N.I.S.T.) 2.6/172490 & 6.6/139577.

CALCULATED USING MASS VALUES, AREA, A_o, AND STATED GRAVITY.

ROOM TEMPERATURE/HUMIDITY (AT TIME OF TEST): 64°F / 25%.

CALIBRATED BY: NICK BEDFORD

A handwritten signature in black ink, appearing to read 'Nick Bedford', written over a horizontal line.

SIGNATURE

P-SS-SS-COMPANIES



9700 E. 104TH AVE, UNIT F- HENDERSON, CO 80640 - Phone (303)857-7986 - Fax (303)389-4945

CALIBRATION CERTIFICATE

CERTIFICATE NUMBER: CO

Details +/-: 1.0% ACCURACY

DATE CALIBRATED: 02/05/2018
DUE DATE: 02/05/2019

INDICATED TEMPERATURE RANGE: # 0 – 150°F
INDICATED PRESSURE RANGE: #0 – 3000 PSI
SERIAL NO: 7105
MANUFACTURER: CHARTS LTD/ 12" RECORDER

TYPE OF INSTRUMENT CALIBRATED: TEMPERATURE / PRESSURE RECORDER

INSTRUMENT FINDINGS/STATUS: UNIT IS IN TOLERANCE/ INSTRUMENT MEETS OR EXCEEDS SPECIFICATIONS.

BASED ON INTERNATIONAL STANDARDS OF GRAVITY: (980.665 cm/sq.).

TYPE OF STANDARD USED TO CALIBRATE: REFINERY DEADWEIGHT TEST UNIT SPT. (35225-3) SERIAL No. 5268: KESSLER TEST THERMOMETERS; SERIAL NO. CALIBRATION

ALL STANDARD DIRECTLY TRACEABLE TO NATIONAL INSTITUTE OF STANDARDS & TECHNOLOGIES TEST NO: (N.I.S.T.) 2.6/172490 & 6.6/139577.

CALCULATED USING MASS VALUES, AREA, AO, AND STATED GRAVITY.
ROOM TEMPERATURE/HUMIDITY (AT TIME OF TEST): 66°F / 25%.

CALIBRATED BY: NICK BEDFORD



SIGNATURE

CHARTS Ltd.

GAS MEASUREMENT



CALIBRATION CERTIFICATE

Date: 8/30/2017
DueDate: 8/30/2018

Customer: Nitrogen Services

Model: Clp 12"

Serial: 7108

This is to certify that this instrument has been inspected and tested against Additel Digital Gauge ADT GP20K, Serial#21817080004 Calibrated (6/16/17). Reference Standard Serial#11-218 Certified Traceable to NIST. Calibrated in accordance with ISO9000 Quality Standards

This instrument is certified to be accurate within +/- 1% of nominal value

Input Type/ Range: 3000#		Color: red	
Pen Number: 1			
<u>Ascending</u>		<u>Descending</u>	
Applied:	Reading	Applied:	Reading:
0	0	3013	3000
595	600	2399	2400
1503	1500	1496	1500
2405	2400	597	600
3013	3000	0	0


Input Type/ Range: 0-150F		Color: Green	
Pen Number: 2			
<u>Ascending</u>		<u>Descending</u>	
Applied:	Reading:	Applied:	Reading:
0	0	150	150
32	32	32	32
150	150	0	0

Input Type/Range:		Color:	
Pen Number:			
		<u>Descending</u>	
Applied:	Reading:	Applied:	Reading:

P.O. BOX 2983 2031 TRADE DR.
MIDLAND, TX 79706
(432) 697-7801 (432) 520-3564Fax

Technician:



Suzanna Hope

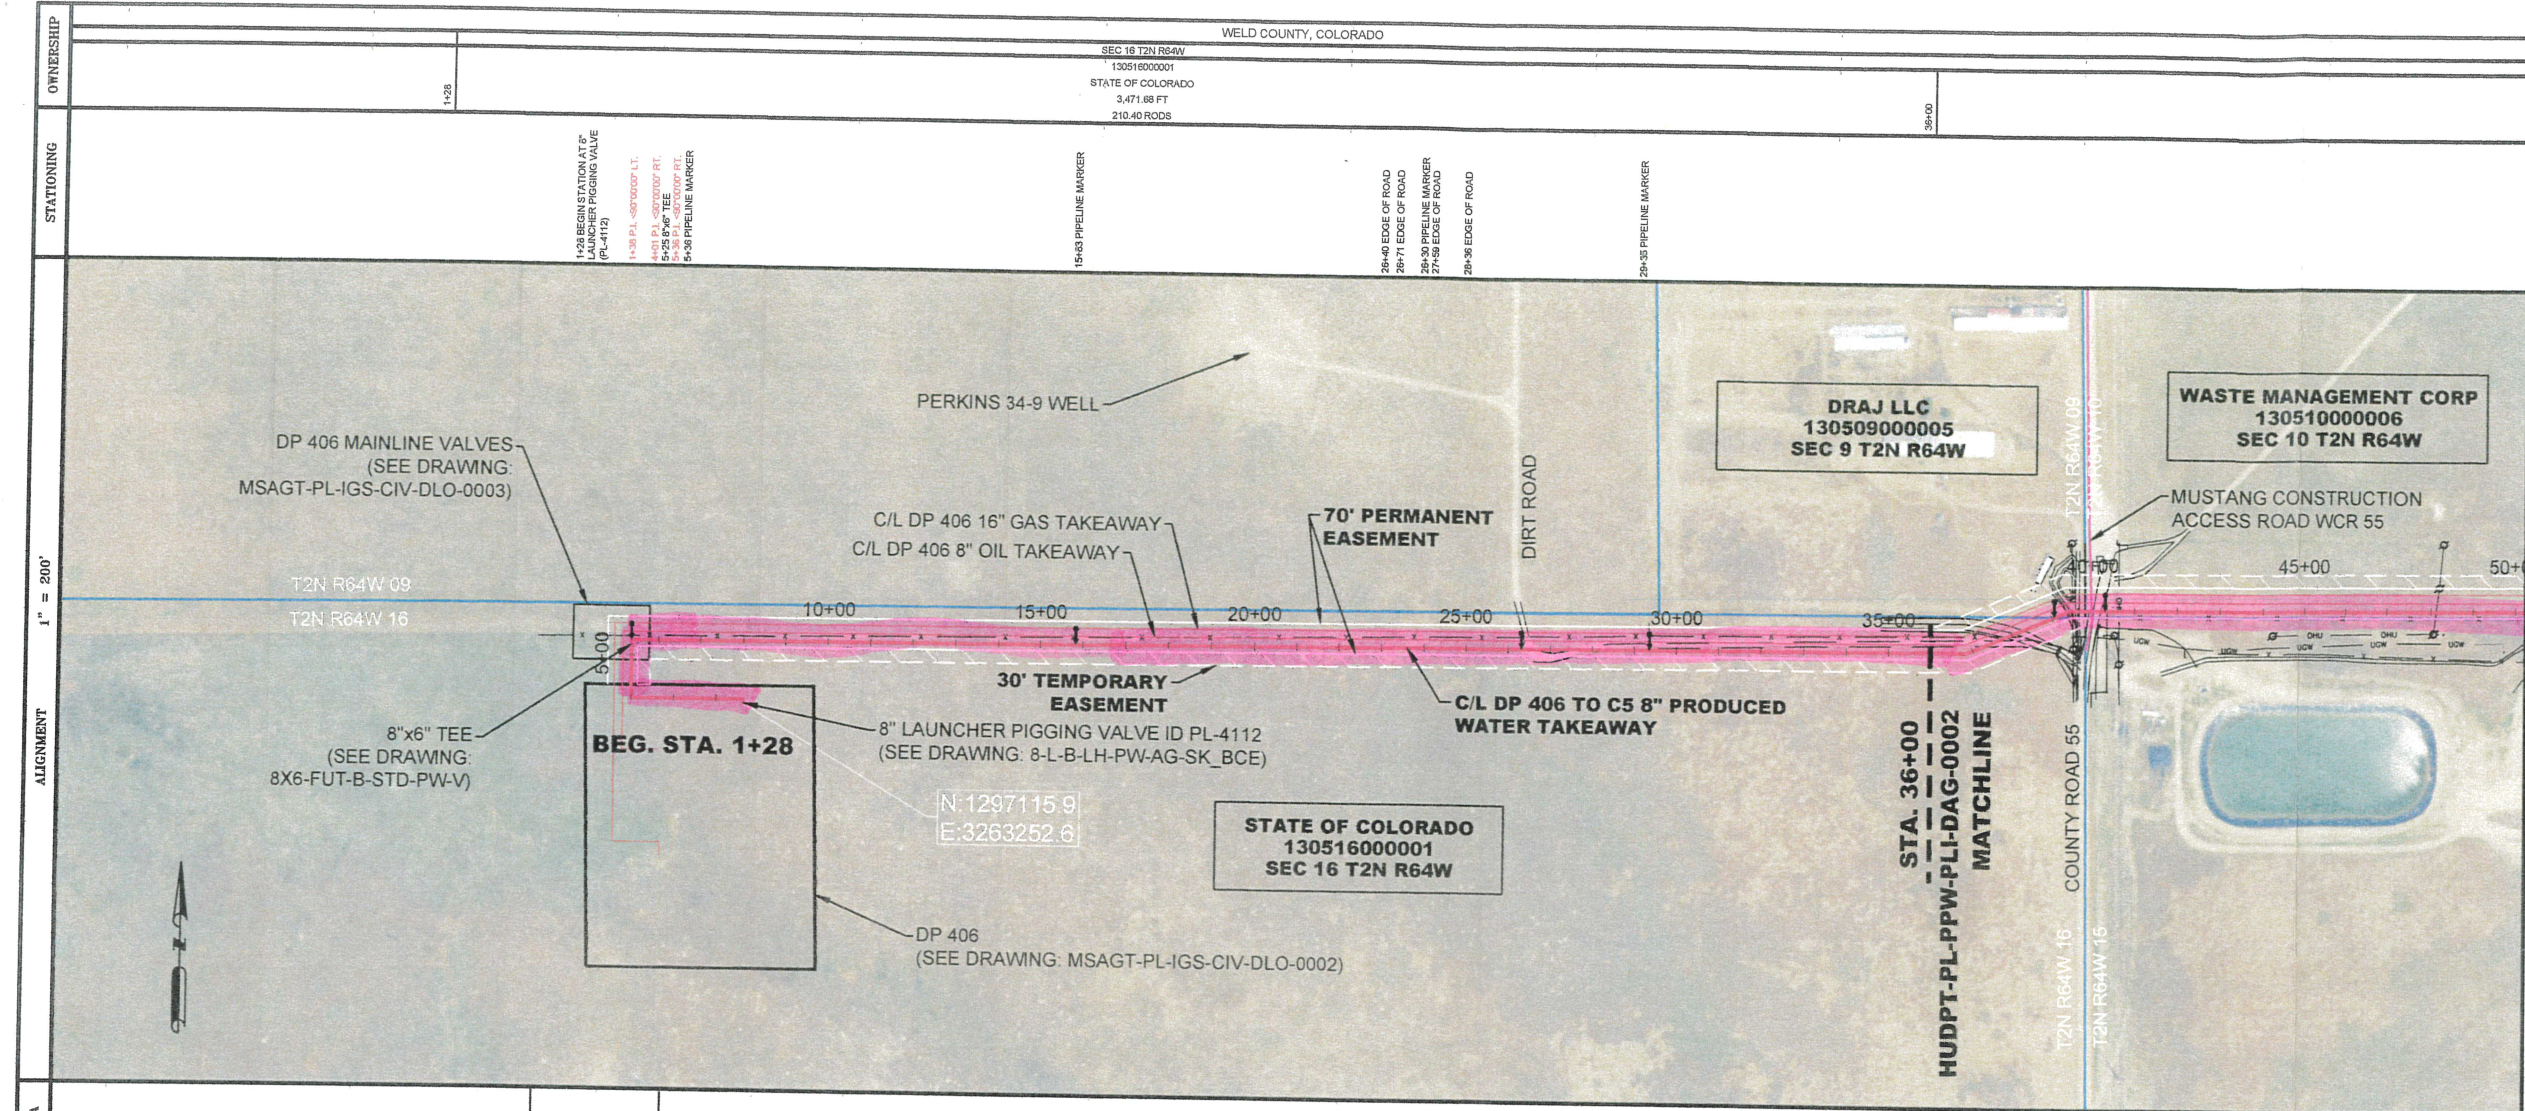

BILL OF MATERIALS						
PIPE QUANTITIES - THIS DRAWING						
NO.	SERVICE	OD	WT	GRIPS	LE	COAT
1	WATER	9.117"	-	750	3,472'	-

MATERIAL QUANTITIES - THIS DRAWING		QUANTITY
LAUNCHER / RECEIVER ASSEMBLY		1
8"x6" TEE		1
PIPELINE MARKERS		4

NO.	STATION	DESCRIPTION	LATITUDE	LONGITUDE	DIST.
BEG.	1+28	BEGIN STATION	40°08'42.55"	-104°33'29.90"	-
1	1+38	P.L. < 90°00'00" LT.	40°08'42.60"	-104°33'29.90"	10'
2	4+01	P.L. < 90°00'00" RT.	40°08'42.61"	-104°33'33.28"	283'
3	5+35	P.L. < 90°00'00" RT.	40°08'43.94"	-104°33'33.28"	134'

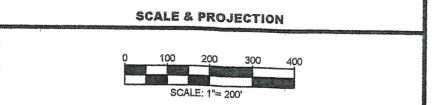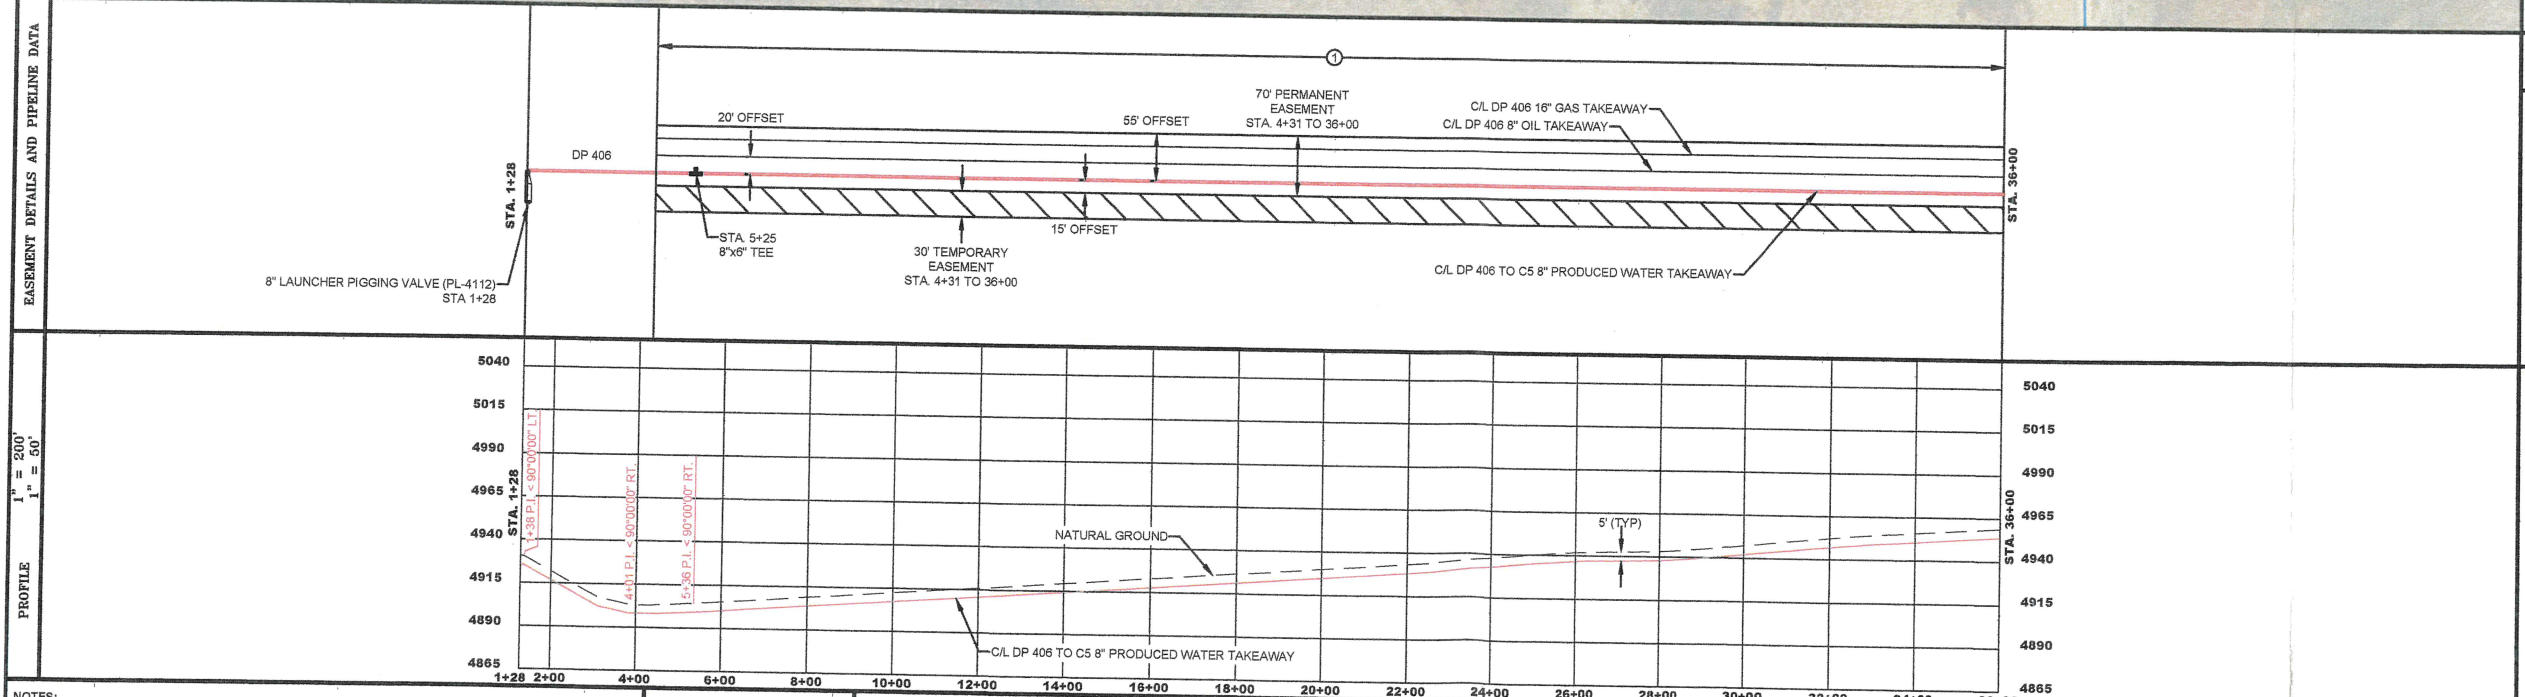

LOCATION: SECTION 16 TOWNSHIP 2N RANGE 64W

PROJECTION: COLORADO STATE PLANES, NAD83, NORTH ZONE, US FOOT

SURVEY LEGEND	
PARCEL PROPERTY LINE	—
ACCESS ROAD	—
UNDERGROUND WATER LINE	—
UNDERGROUND OIL LINE	—
UNDERGROUND GAS LINE	—
UNDERGROUND FIBER OPTIC	—
EDGE OF ROAD	—
OVERHEAD UTILITY	—
FENCE LINE	—
POWER POLE	—
VALVE	—
HYDRANT	—
TEST STATION	—
LAUNCHER / RECEIVER	—
TEE	—
BEND	—
PIPELINE MARKER	—

PROFILE LEGEND	
EXISTING GROUND	—
OPEN CUT	—
BORE	—
APPROX. UTILITY LOCATION	—
CONTRACTOR TO VERIFY IN FIELD	—

NOTES:

LOCATIONS OF UTILITIES AND FOREIGN PIPELINES WERE PROVIDED BY PRIMO LOCATING. THESE LOCATIONS IF SHOWN, MAY NOT BE ACCURATE OR COMPLETE. UTILITIES MAY EXIST AND ARE TO BE FIELD VERIFIED BY OTHERS.

DISCLAIMER:

1) THIS PLOT DOES NOT REPRESENT A MONUMENTED LAND SURVEY AND SHOULD NOT BE RELIED UPON TO DETERMINE BOUNDARY LINES, PROPERTY OWNERSHIP OR OTHER PROPERTY INTERESTS. PARCEL LINES, IF DEPICTED HAVE NOT BEEN FIELD VERIFIED AND MAY BE BASED UPON PUBLICLY AVAILABLE DATA THAT ALSO HAS NOT BEEN INDEPENDENTLY VERIFIED.

DATA SOURCES:

-AERIAL IMAGERY: NAIP 2015

-PARCELS: WELD COUNTY PARCEL MAP 2017

-OIL WELLS: COLORADO OIL & GAS CONSERVATION COMMISSION

-WETLANDS: NOBLE DESKTOP ENVIRONMENTAL REVIEW

PUBLICLY AVAILABLE DATA SOURCES HAVE NOT BEEN INDEPENDENTLY VERIFIED BY ASCENT GEOMATICS SOLUTIONS.

ASCENT
GEOMATICS SOLUTIONS
7535 Hightop Circle
Denver, CO 80221
(303) 928-7128
www.ascentgeomatics.com

REVISIONS									
REV	DESCRIPTION	BY	DATE	CHK BY	CHK DATE	APR BY	APR DATE	PROJ. MGR.	
2	REVISED ISSUED FOR CONSTRUCTION	RG	11/10/17	APW	11/10/17	GFP	11/12/17		
1	REVISED ISSUED FOR CONSTRUCTION	KR	10/17/17	CLP	10/18/17	SNC	10/22/17		
0	ISSUED FOR CONSTRUCTION	RG	09/11/17	CLP	09/29/17	GFP	10/02/17		

APPROVALS	
DRAWN	SIGNATURE
CHECKED	DATE
APPROVED	

CLIENT APPROVALS	
SIGNATURE	DATE
OPERATIONS	
ENGINEERING	
PROJ. MGR.	

Noble
MIDSTREAM PARTNERS


**DP 406 TO C5 8" PRODUCED WATER TAKEAWAY
ALIGNMENT SHEET
WELD COUNTY, COLORADO
1+28 TO 36+00**


SCALE: 1" = 200'


DWG. No.: HUDPT-PL-PPW-PLI-DAG-0001

SHEET No.: 3 OF 12


File Location: P:\MMS_B180031PROD\Alignments\Sheet\DWG\DP 406 8IN PRODUCED WATER IFC ALIGNMENTS 3-4 of 21.dwg

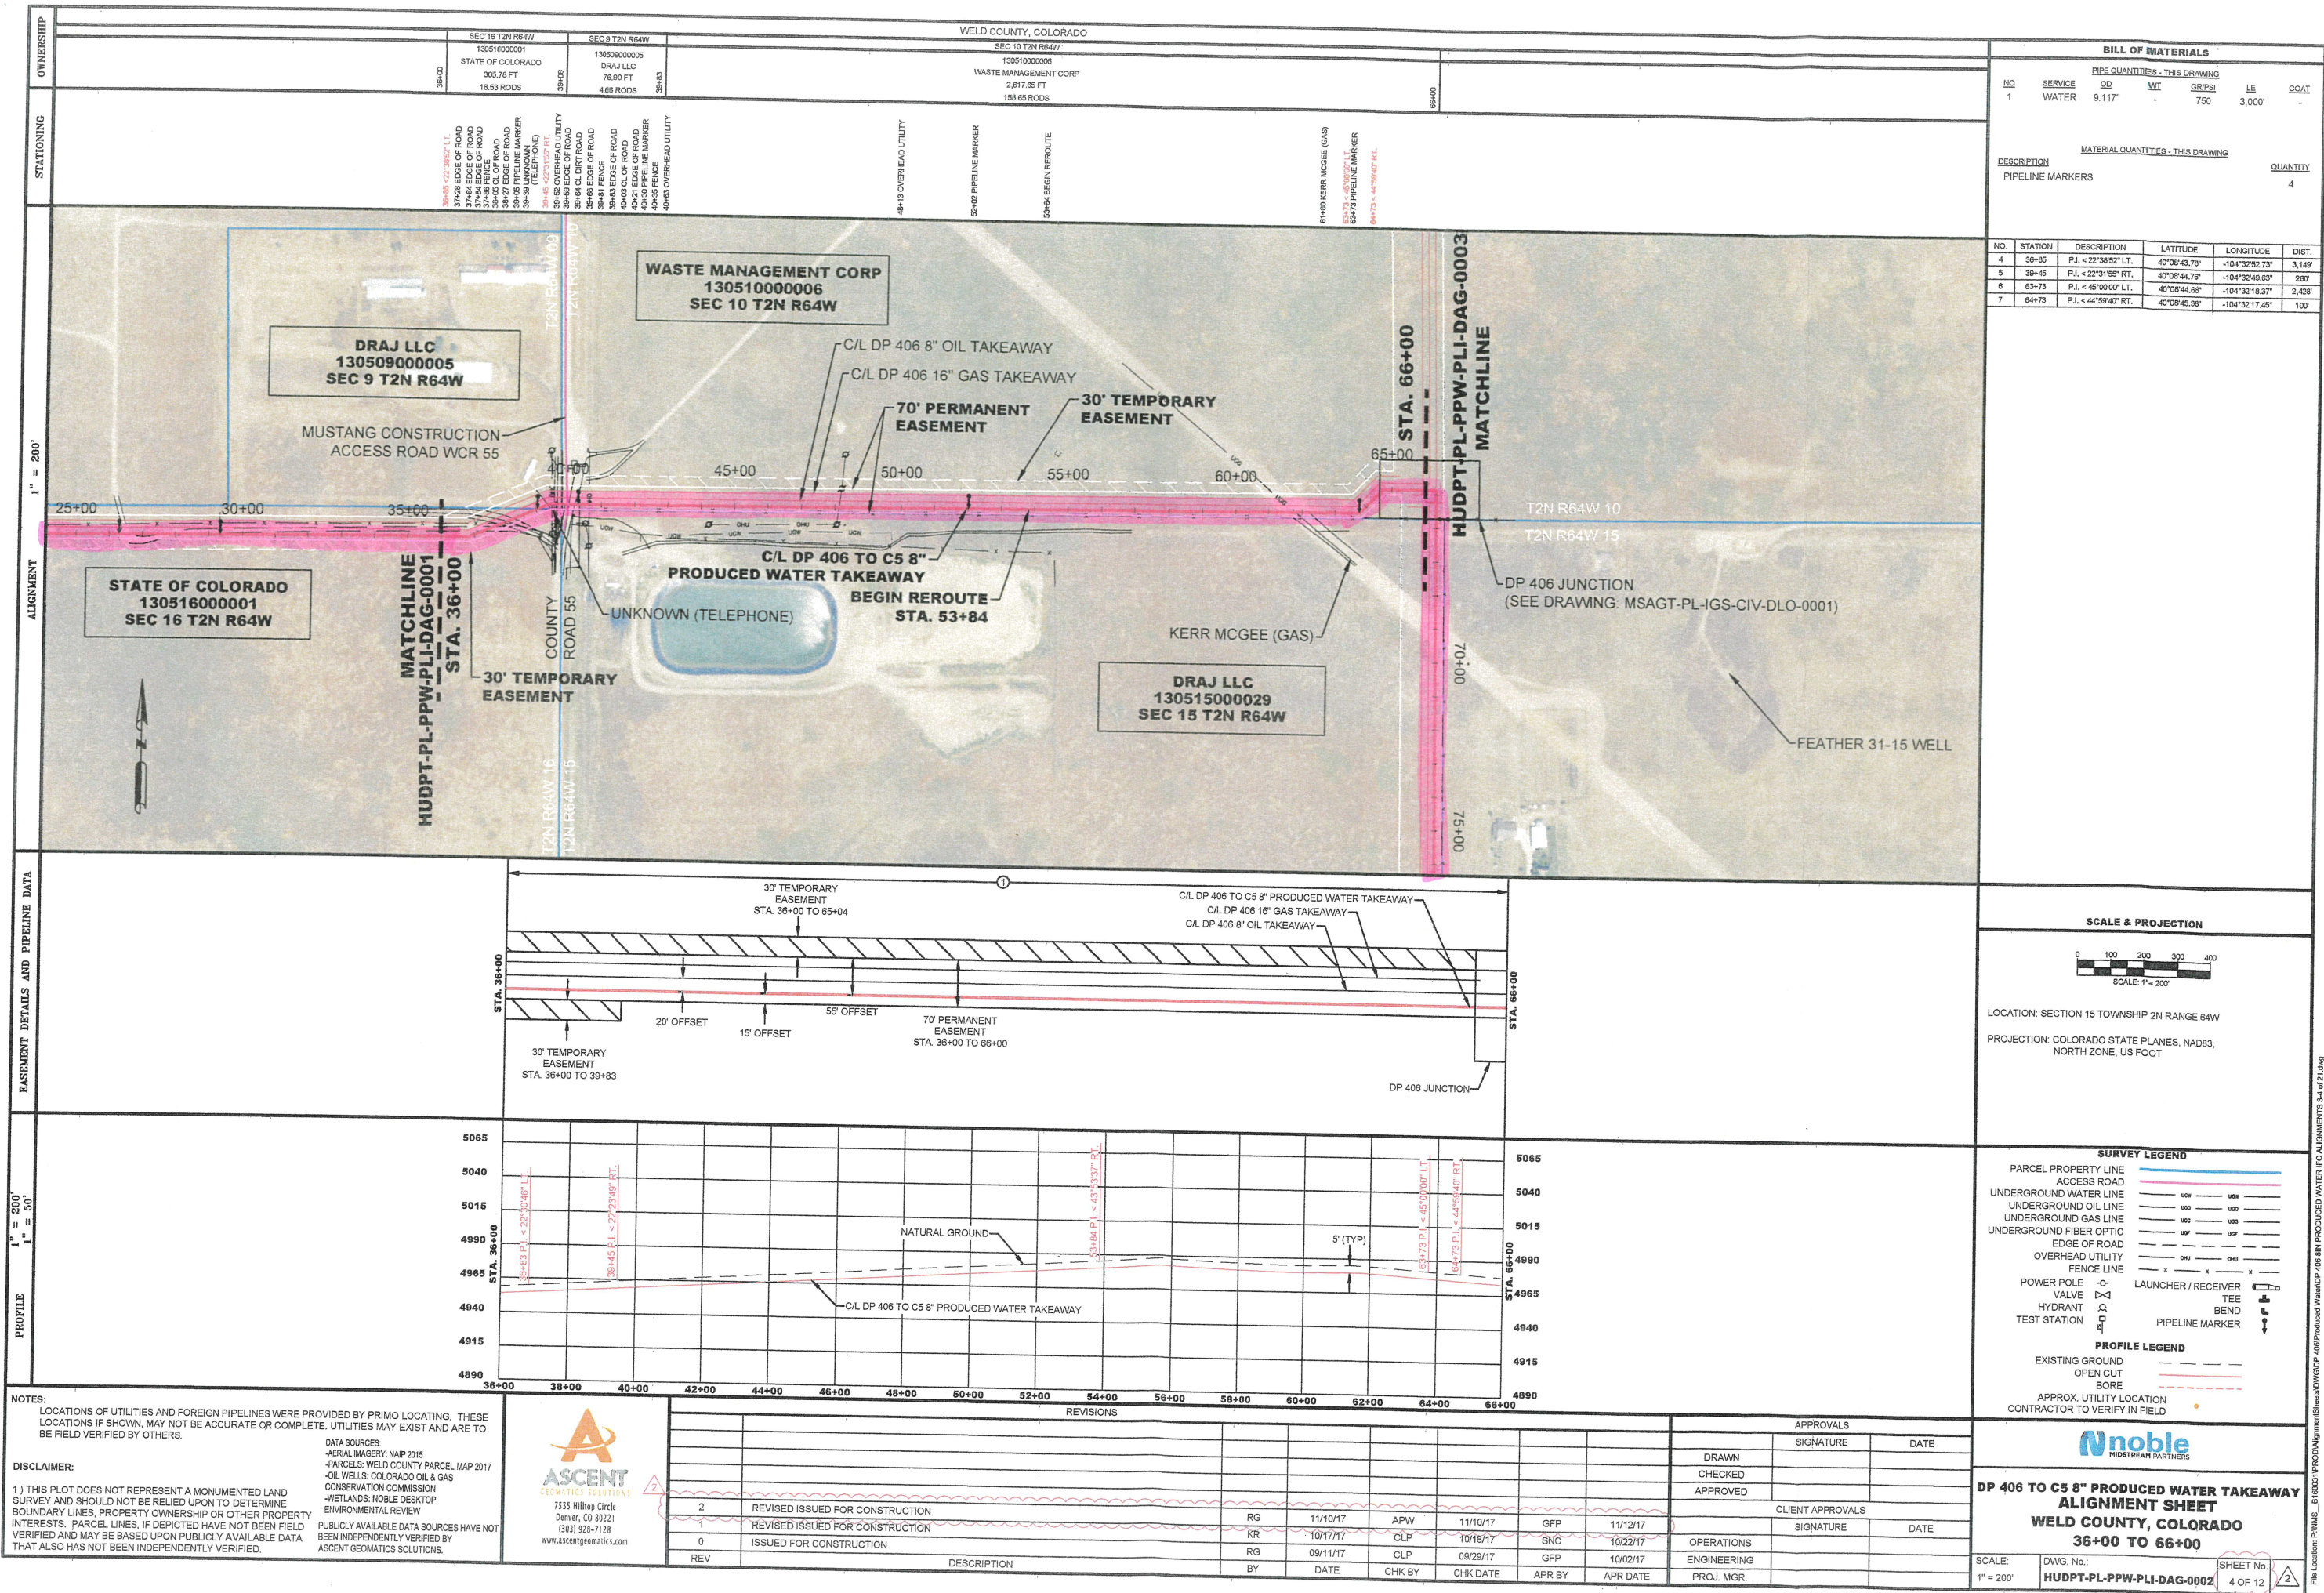

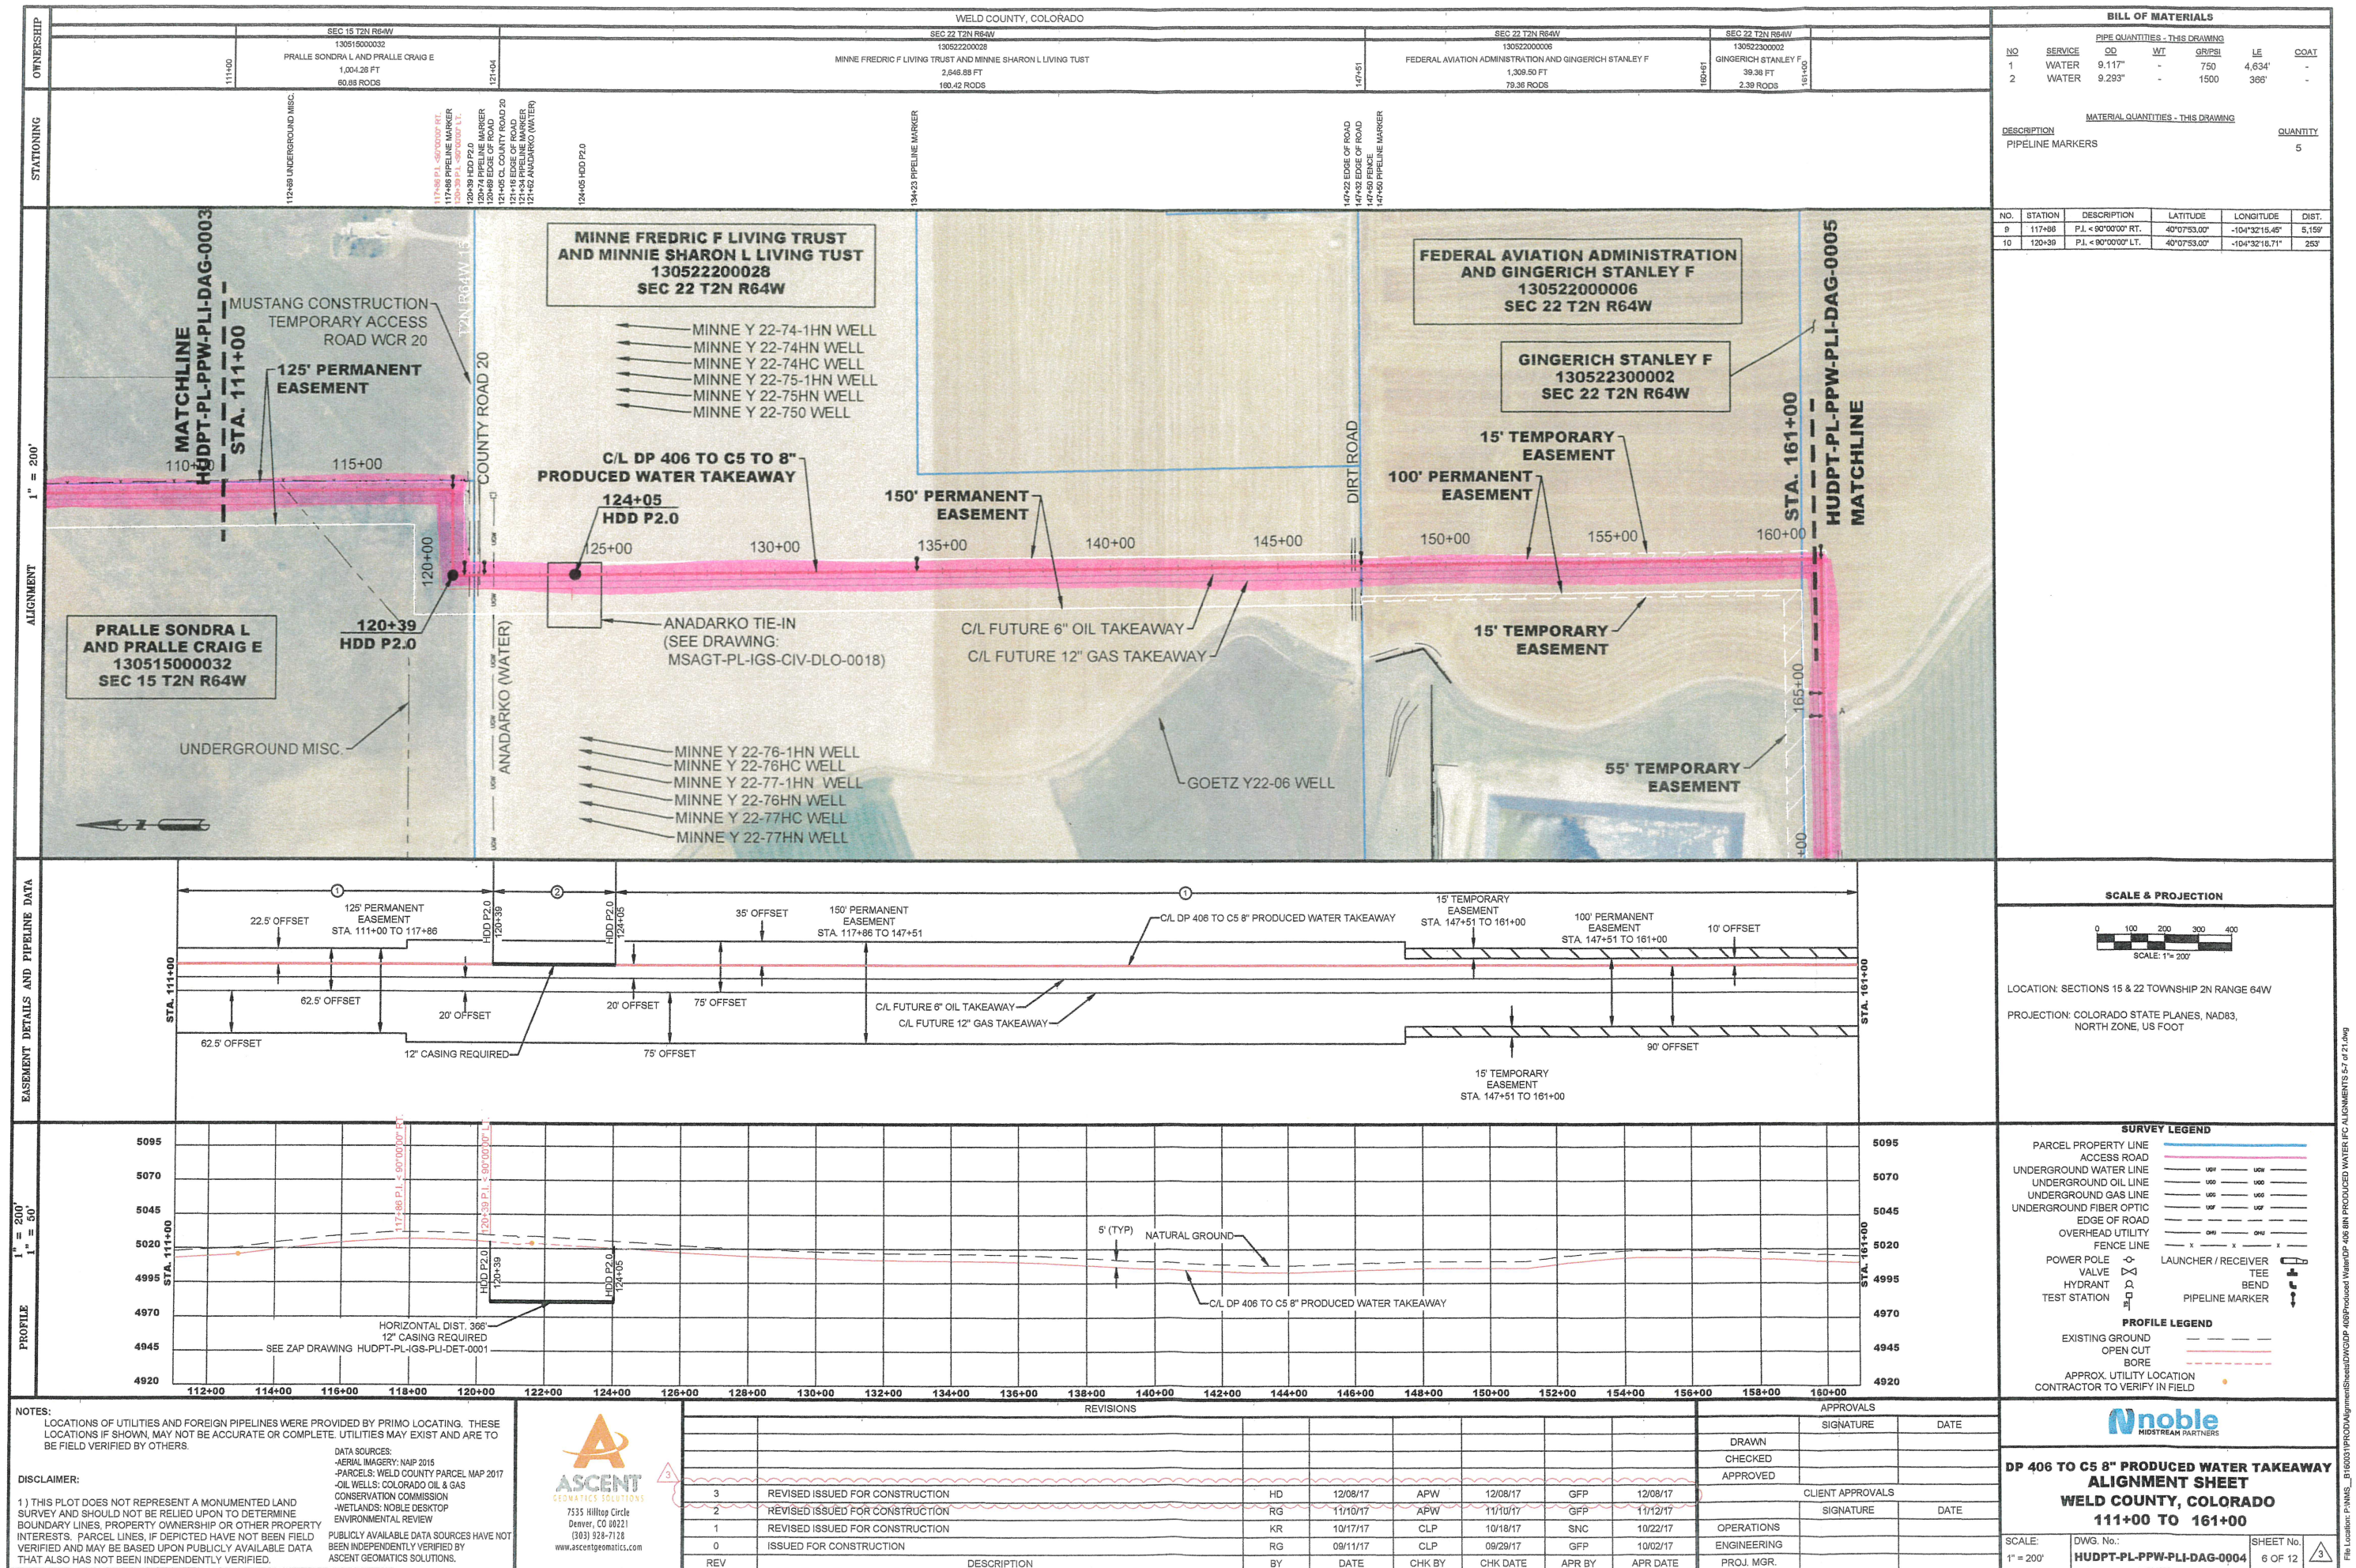

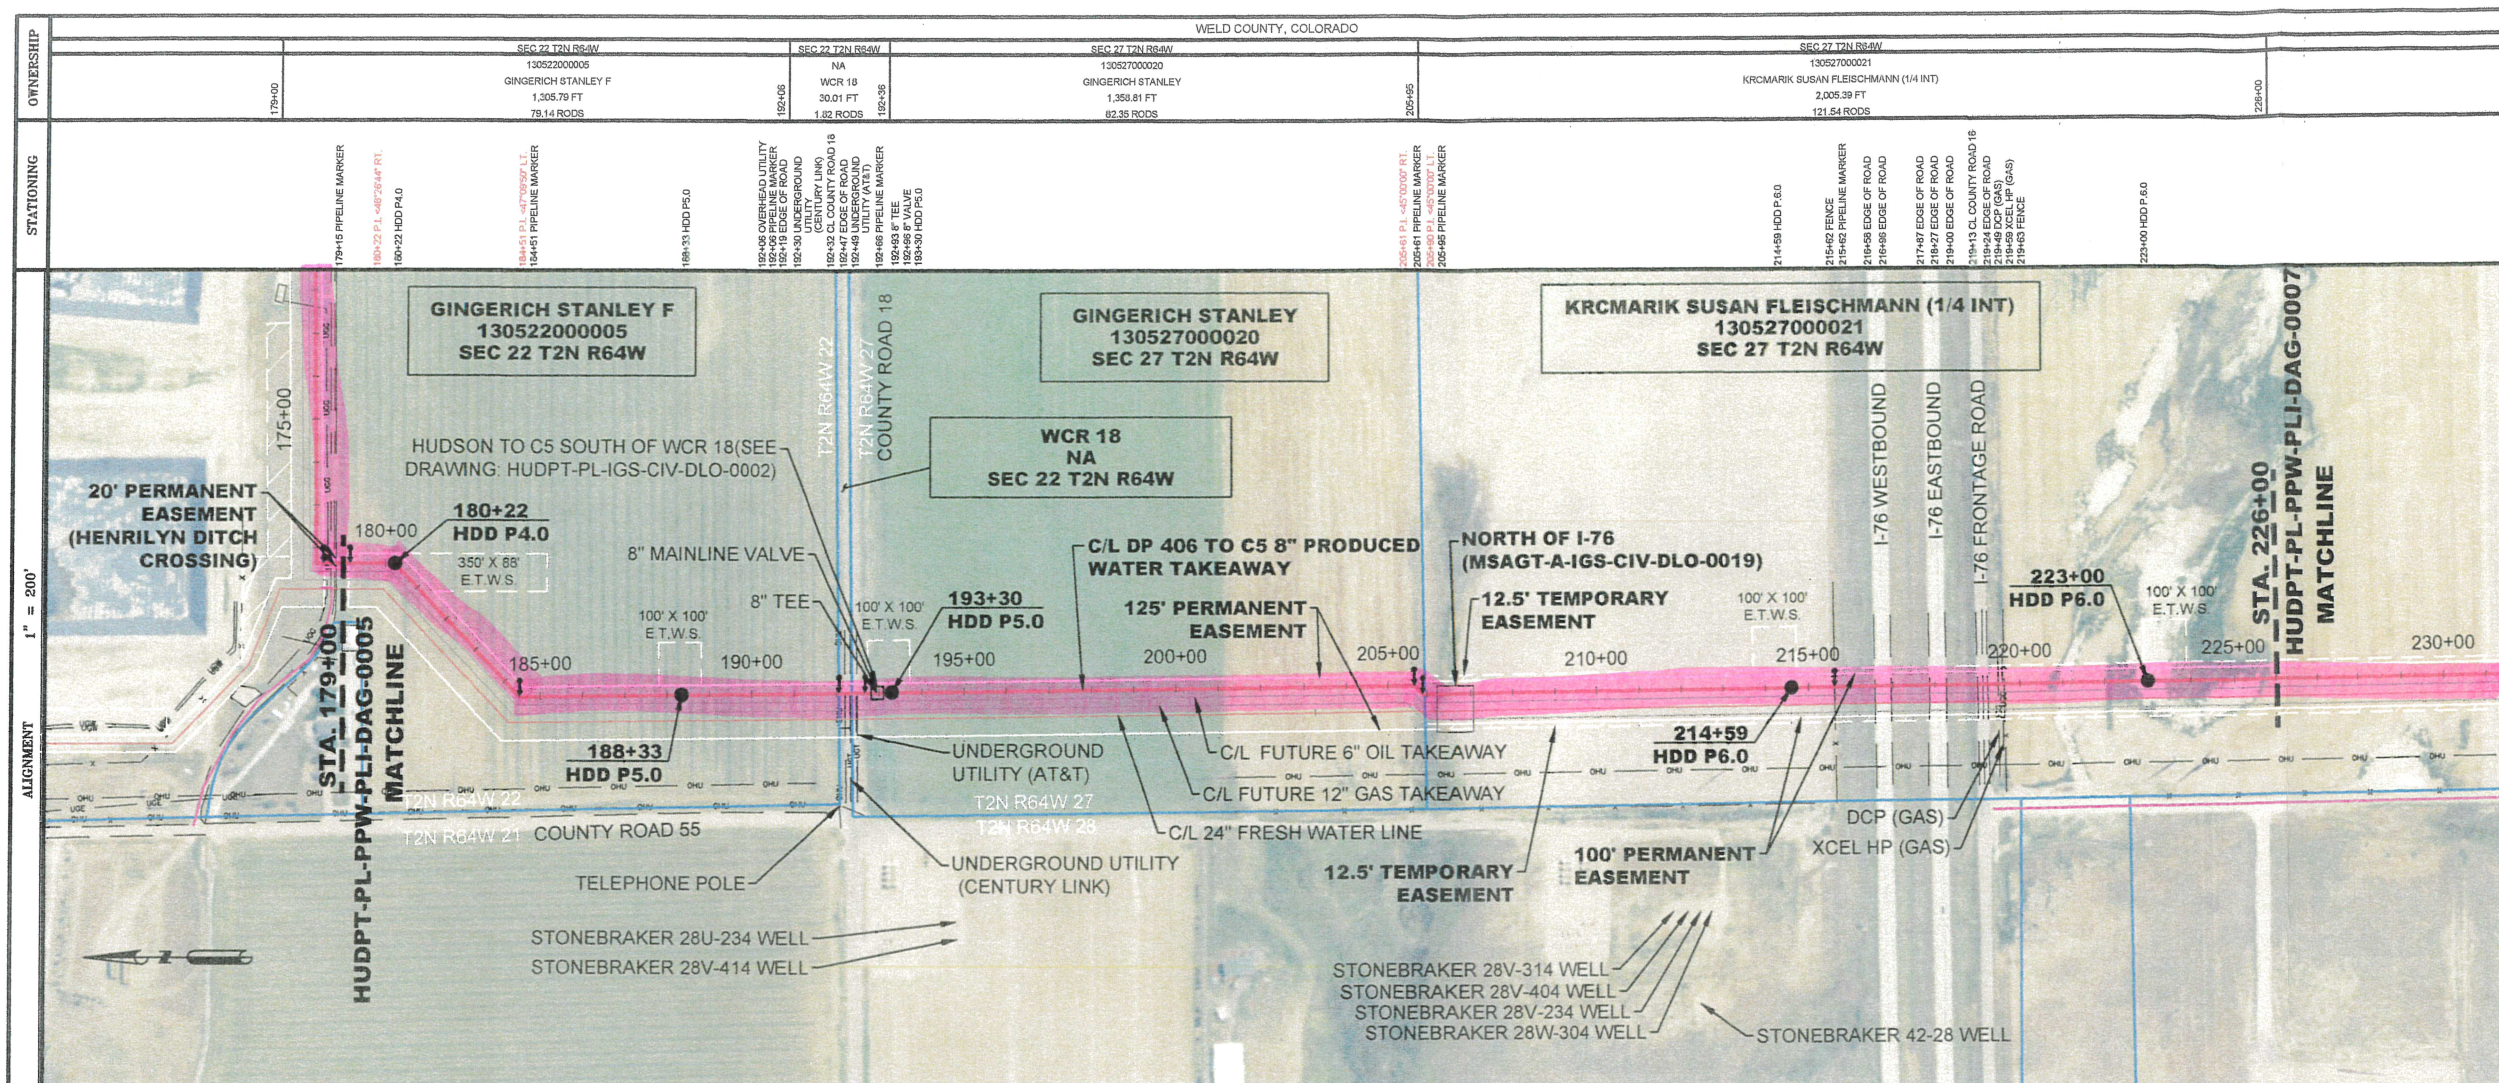

BILL OF MATERIALS						
PIPE QUANTITIES - THIS DRAWING						
NO	SERVICE	OD	WT	GR	LE	COAT
1	WATER	9.117"	-	750	3,240'	-
2	WATER	9.293"	-	1500	1,460'	-
MATERIAL QUANTITIES - THIS DRAWING						
DESCRIPTION						QUANTITY
8" VALVE						1
8"X8" TEE						1
PIPELINE MARKERS						7

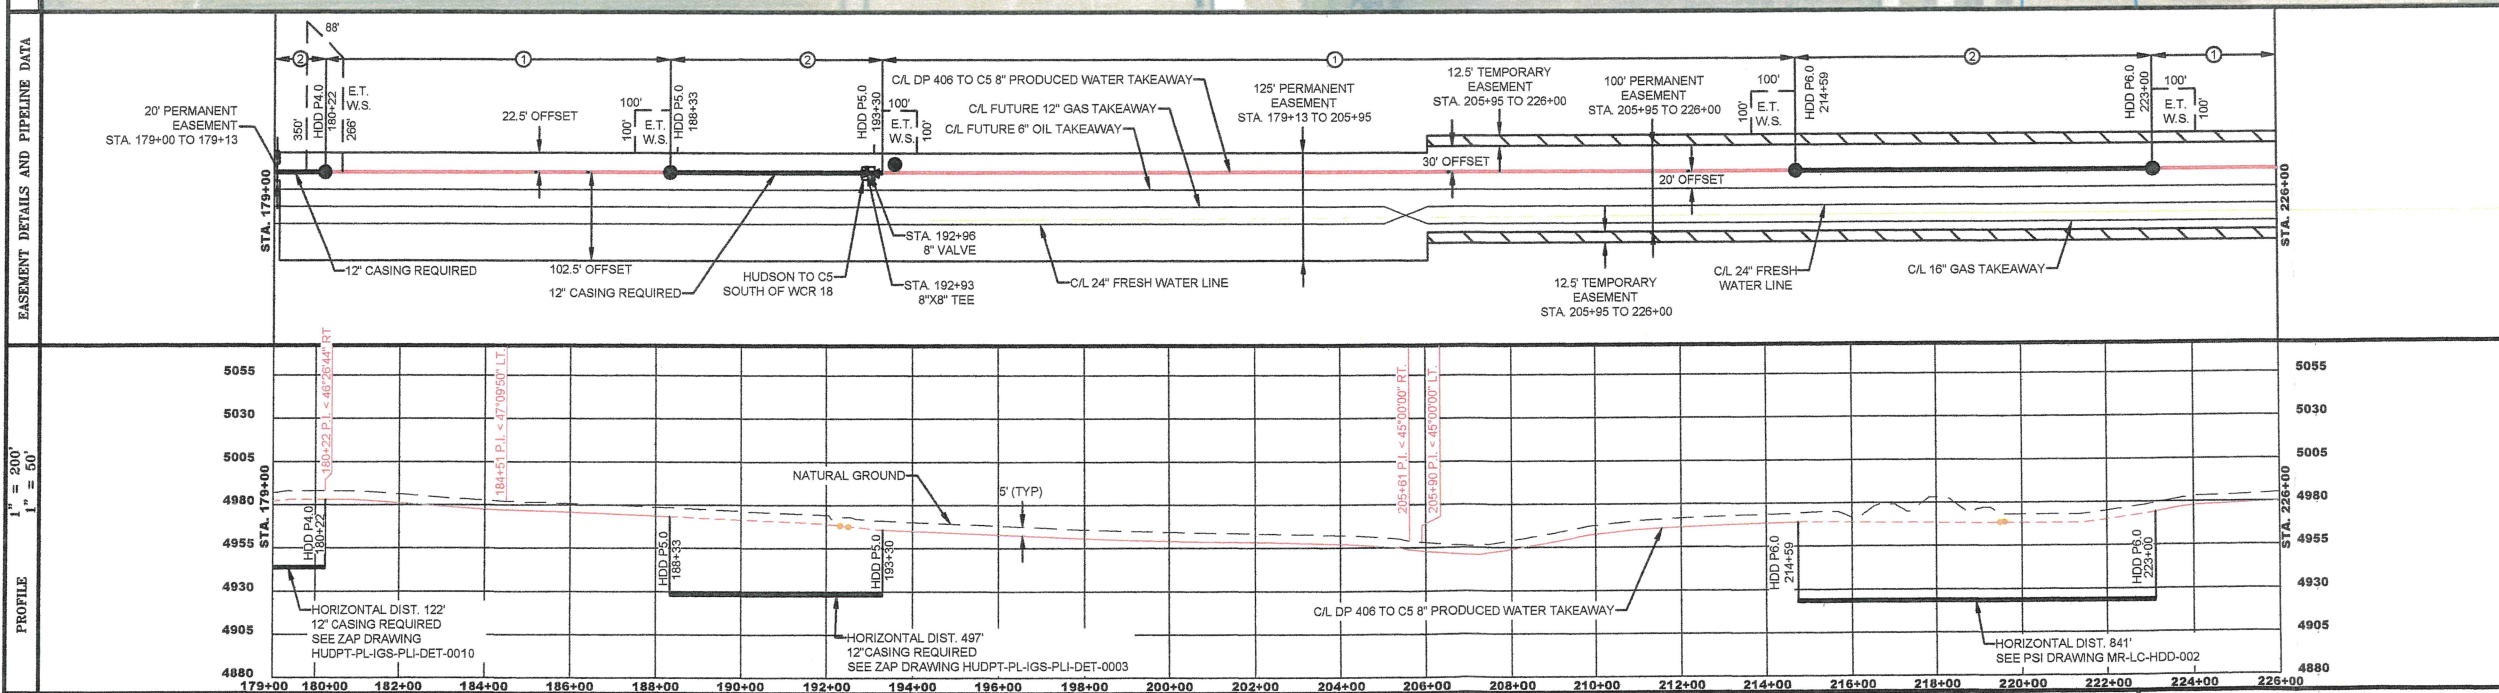

NOTES:

LOCATIONS OF UTILITIES AND FOREIGN PIPELINES WERE PROVIDED BY PRIMO LOCATING. THESE LOCATIONS IF SHOWN, MAY NOT BE ACCURATE OR COMPLETE. UTILITIES MAY EXIST AND ARE TO BE FIELD VERIFIED BY OTHERS.


DISCLAIMER:


1) THIS PLOT DOES NOT REPRESENT A MONUMENTED LAND SURVEY AND SHOULD NOT BE RELIED UPON TO DETERMINE BOUNDARY LINES, PROPERTY OWNERSHIP OR OTHER PROPERTY INTERESTS. PARCEL LINES, IF DEPICTED HAVE NOT BEEN FIELD VERIFIED AND MAY BE BASED UPON PUBLICLY AVAILABLE DATA THAT ALSO HAS NOT BEEN INDEPENDENTLY VERIFIED.

DATA SOURCES:


- AERIAL IMAGERY: NAIP 2015
- PARCELS: WELD COUNTY PARCEL MAP 2017
- OIL WELLS: COLORADO OIL & GAS CONSERVATION COMMISSION
- WETLANDS: NOBLE DESKTOP ENVIRONMENTAL REVIEW


PUBLICLY AVAILABLE DATA SOURCES HAVE NOT BEEN INDEPENDENTLY VERIFIED BY ASCENT GEOMATICS SOLUTIONS.

<div></div> <div>7535 Hilltop Circle Denver, CO 80221 (303) 928-7128 www.ascentgeomatics.com</div>	REVISIONS								APPROVALS		
										SIGNATURE	DATE
									DRAWN		
									CHECKED		
									APPROVED		
									CLIENT APPROVALS		
									SIGNATURE	DATE	
	2	REVISED ISSUED FOR CONSTRUCTION	RG	11/10/17	APW	11/10/17	GFP	11/12/17			
	1	REVISED ISSUED FOR CONSTRUCTION	KR	10/17/17	CLP	10/18/17	SNC	10/22/17	OPERATIONS		
	0	ISSUED FOR CONSTRUCTION	RG	09/11/17	CLP	09/29/17	GFP	10/02/17	ENGINEERING		
REV	DESCRIPTION	BY	DATE	CHK BY	CHK DATE	APR BY	APR DATE	PROJ. MGR.			

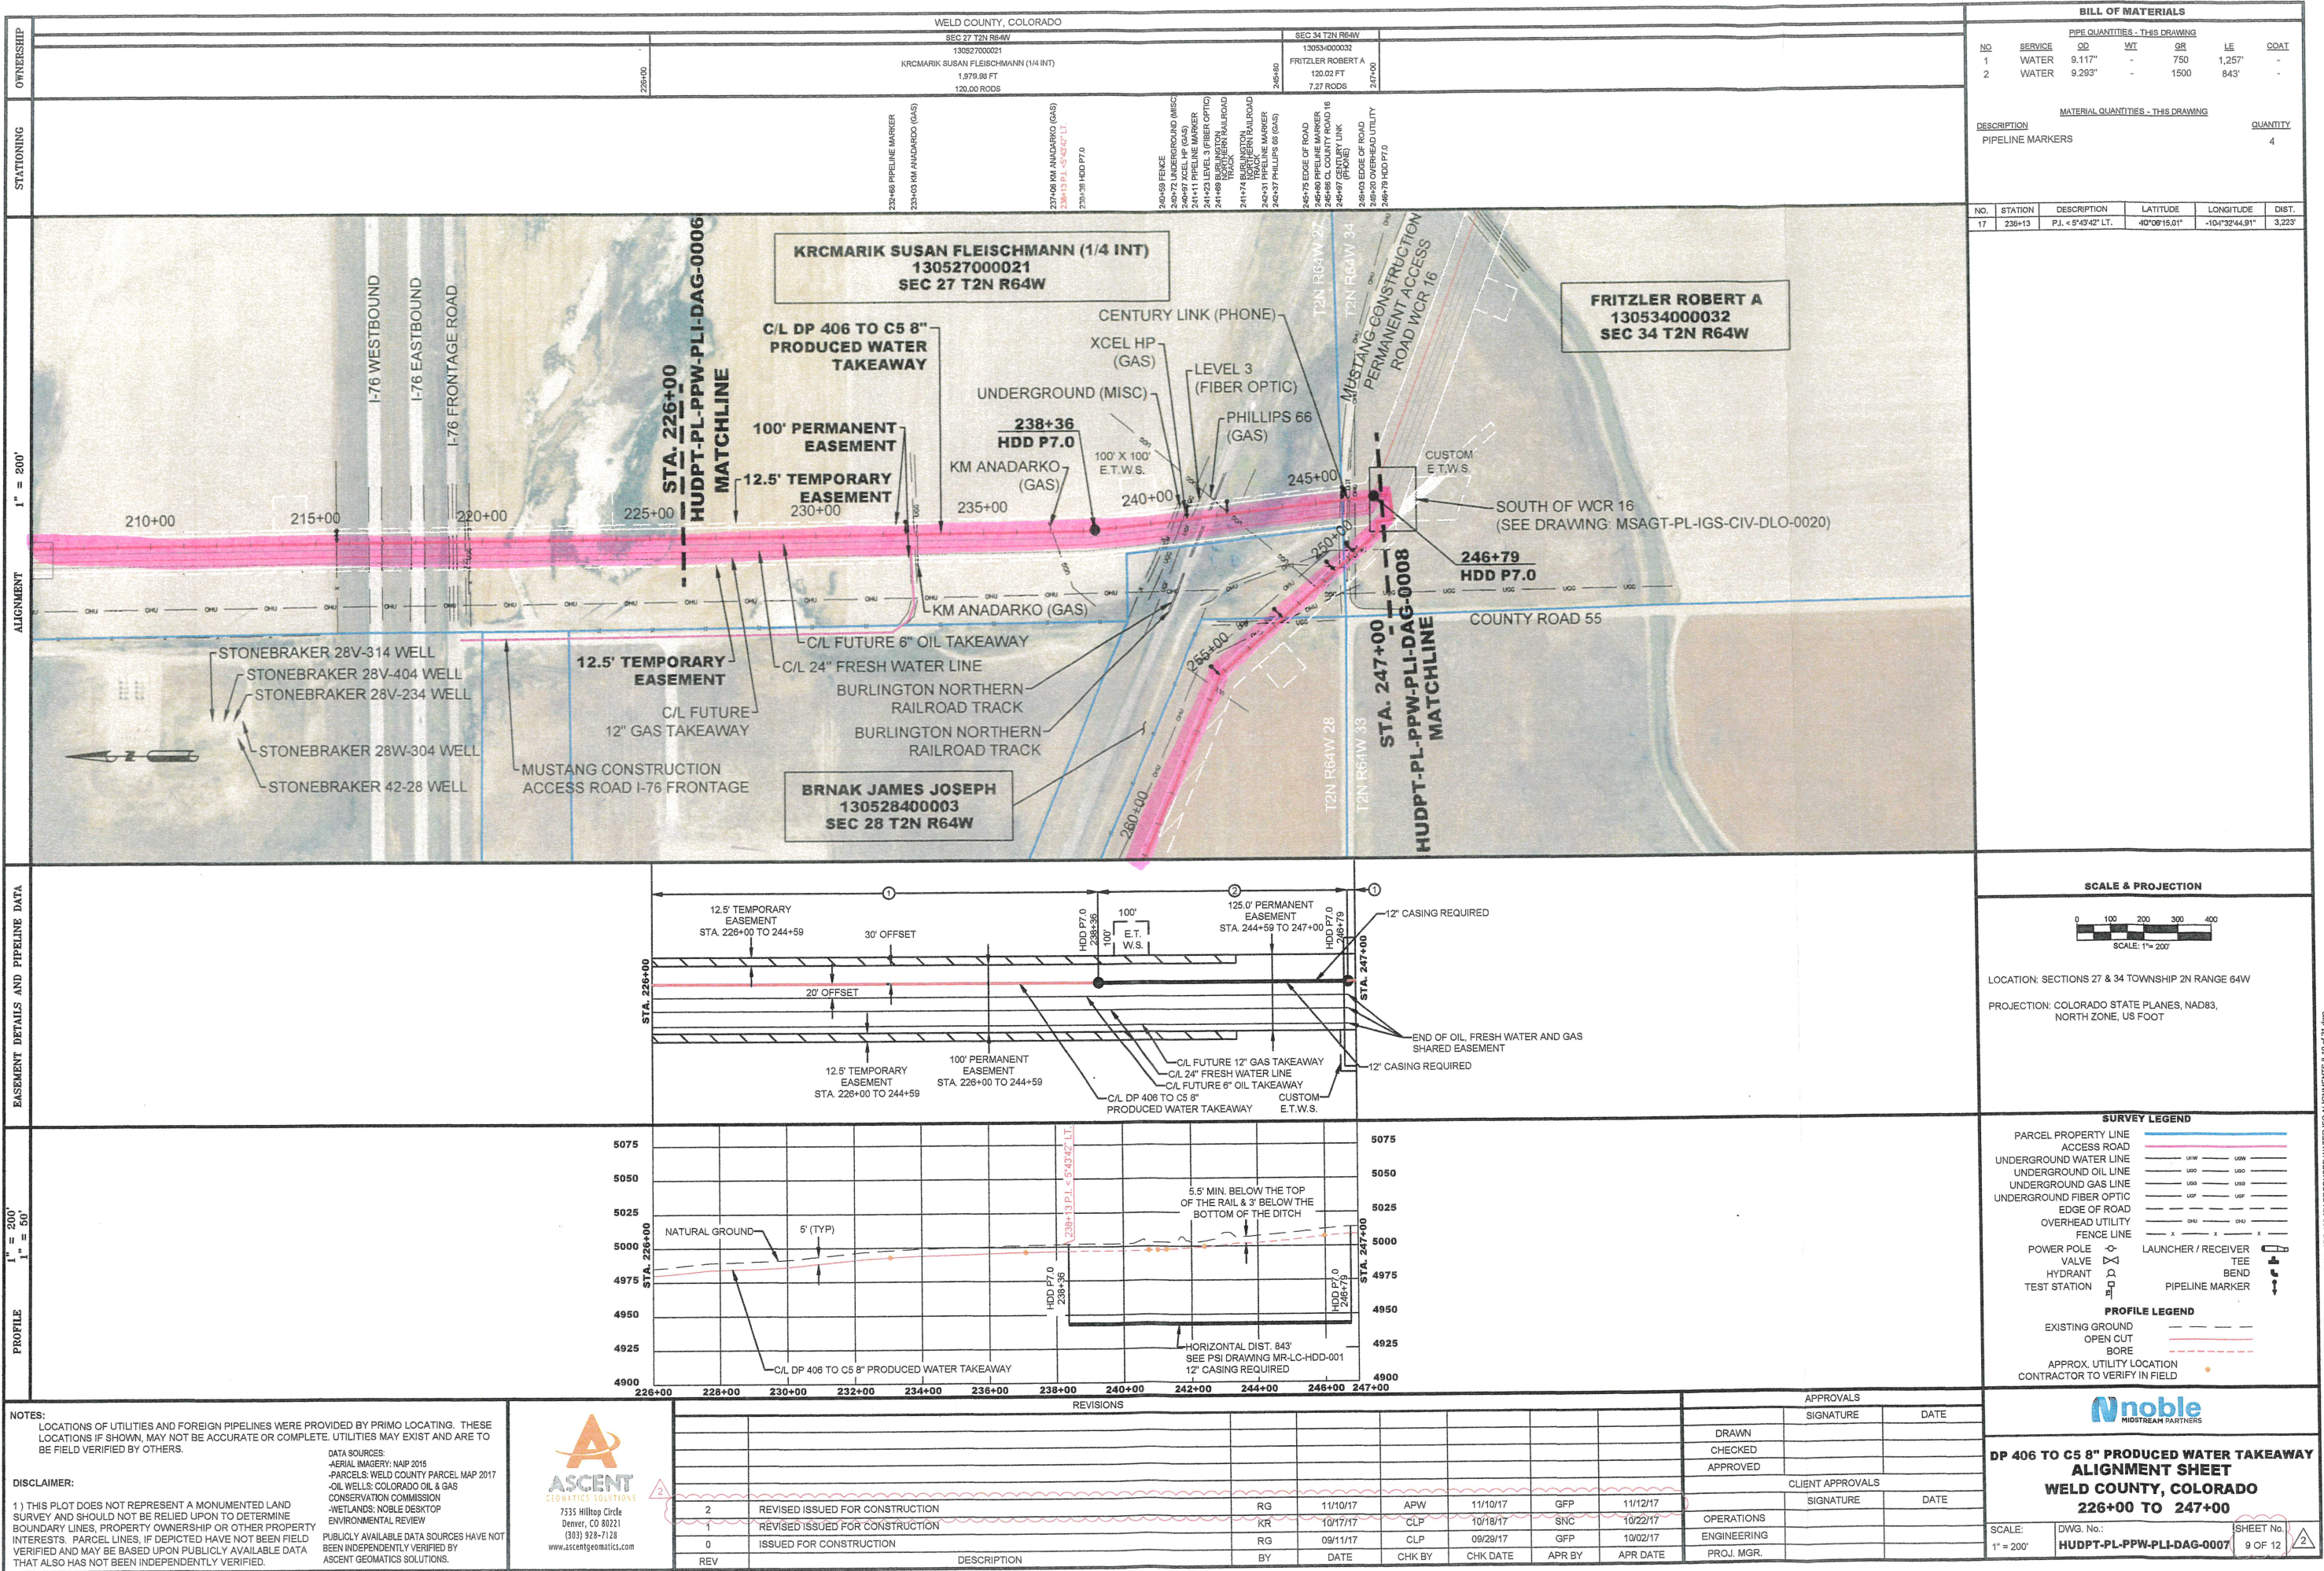

[illegible]

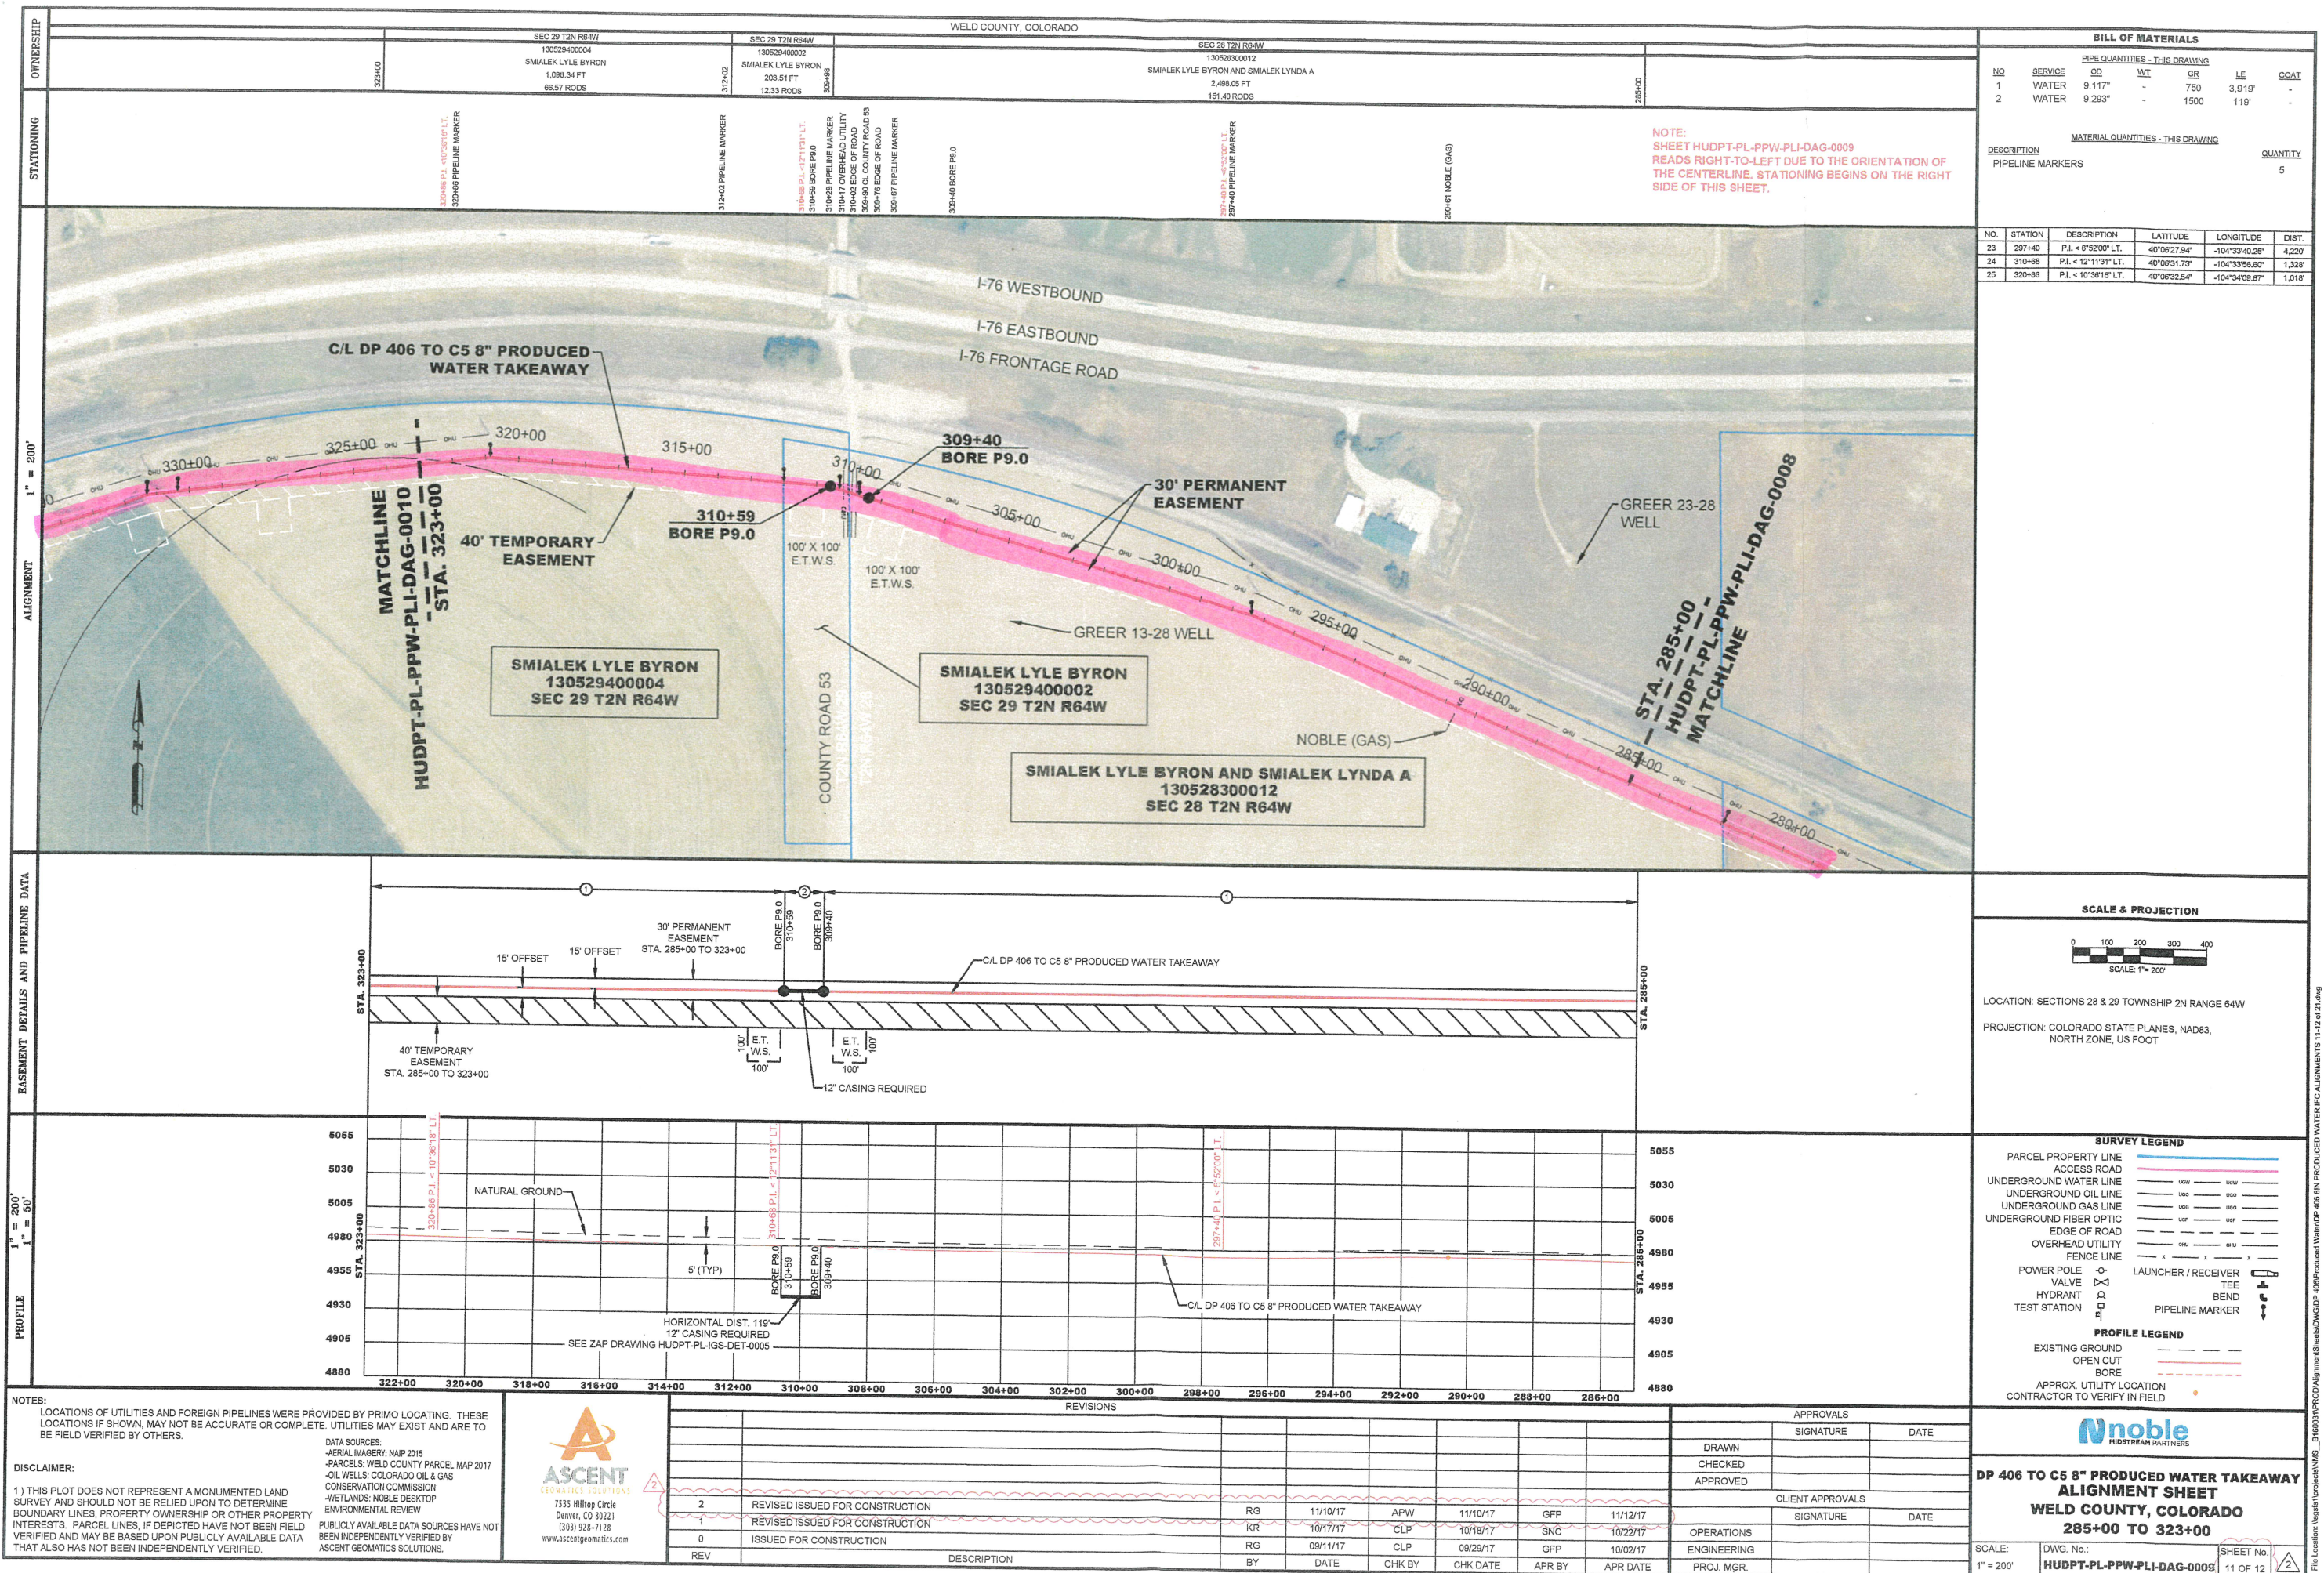


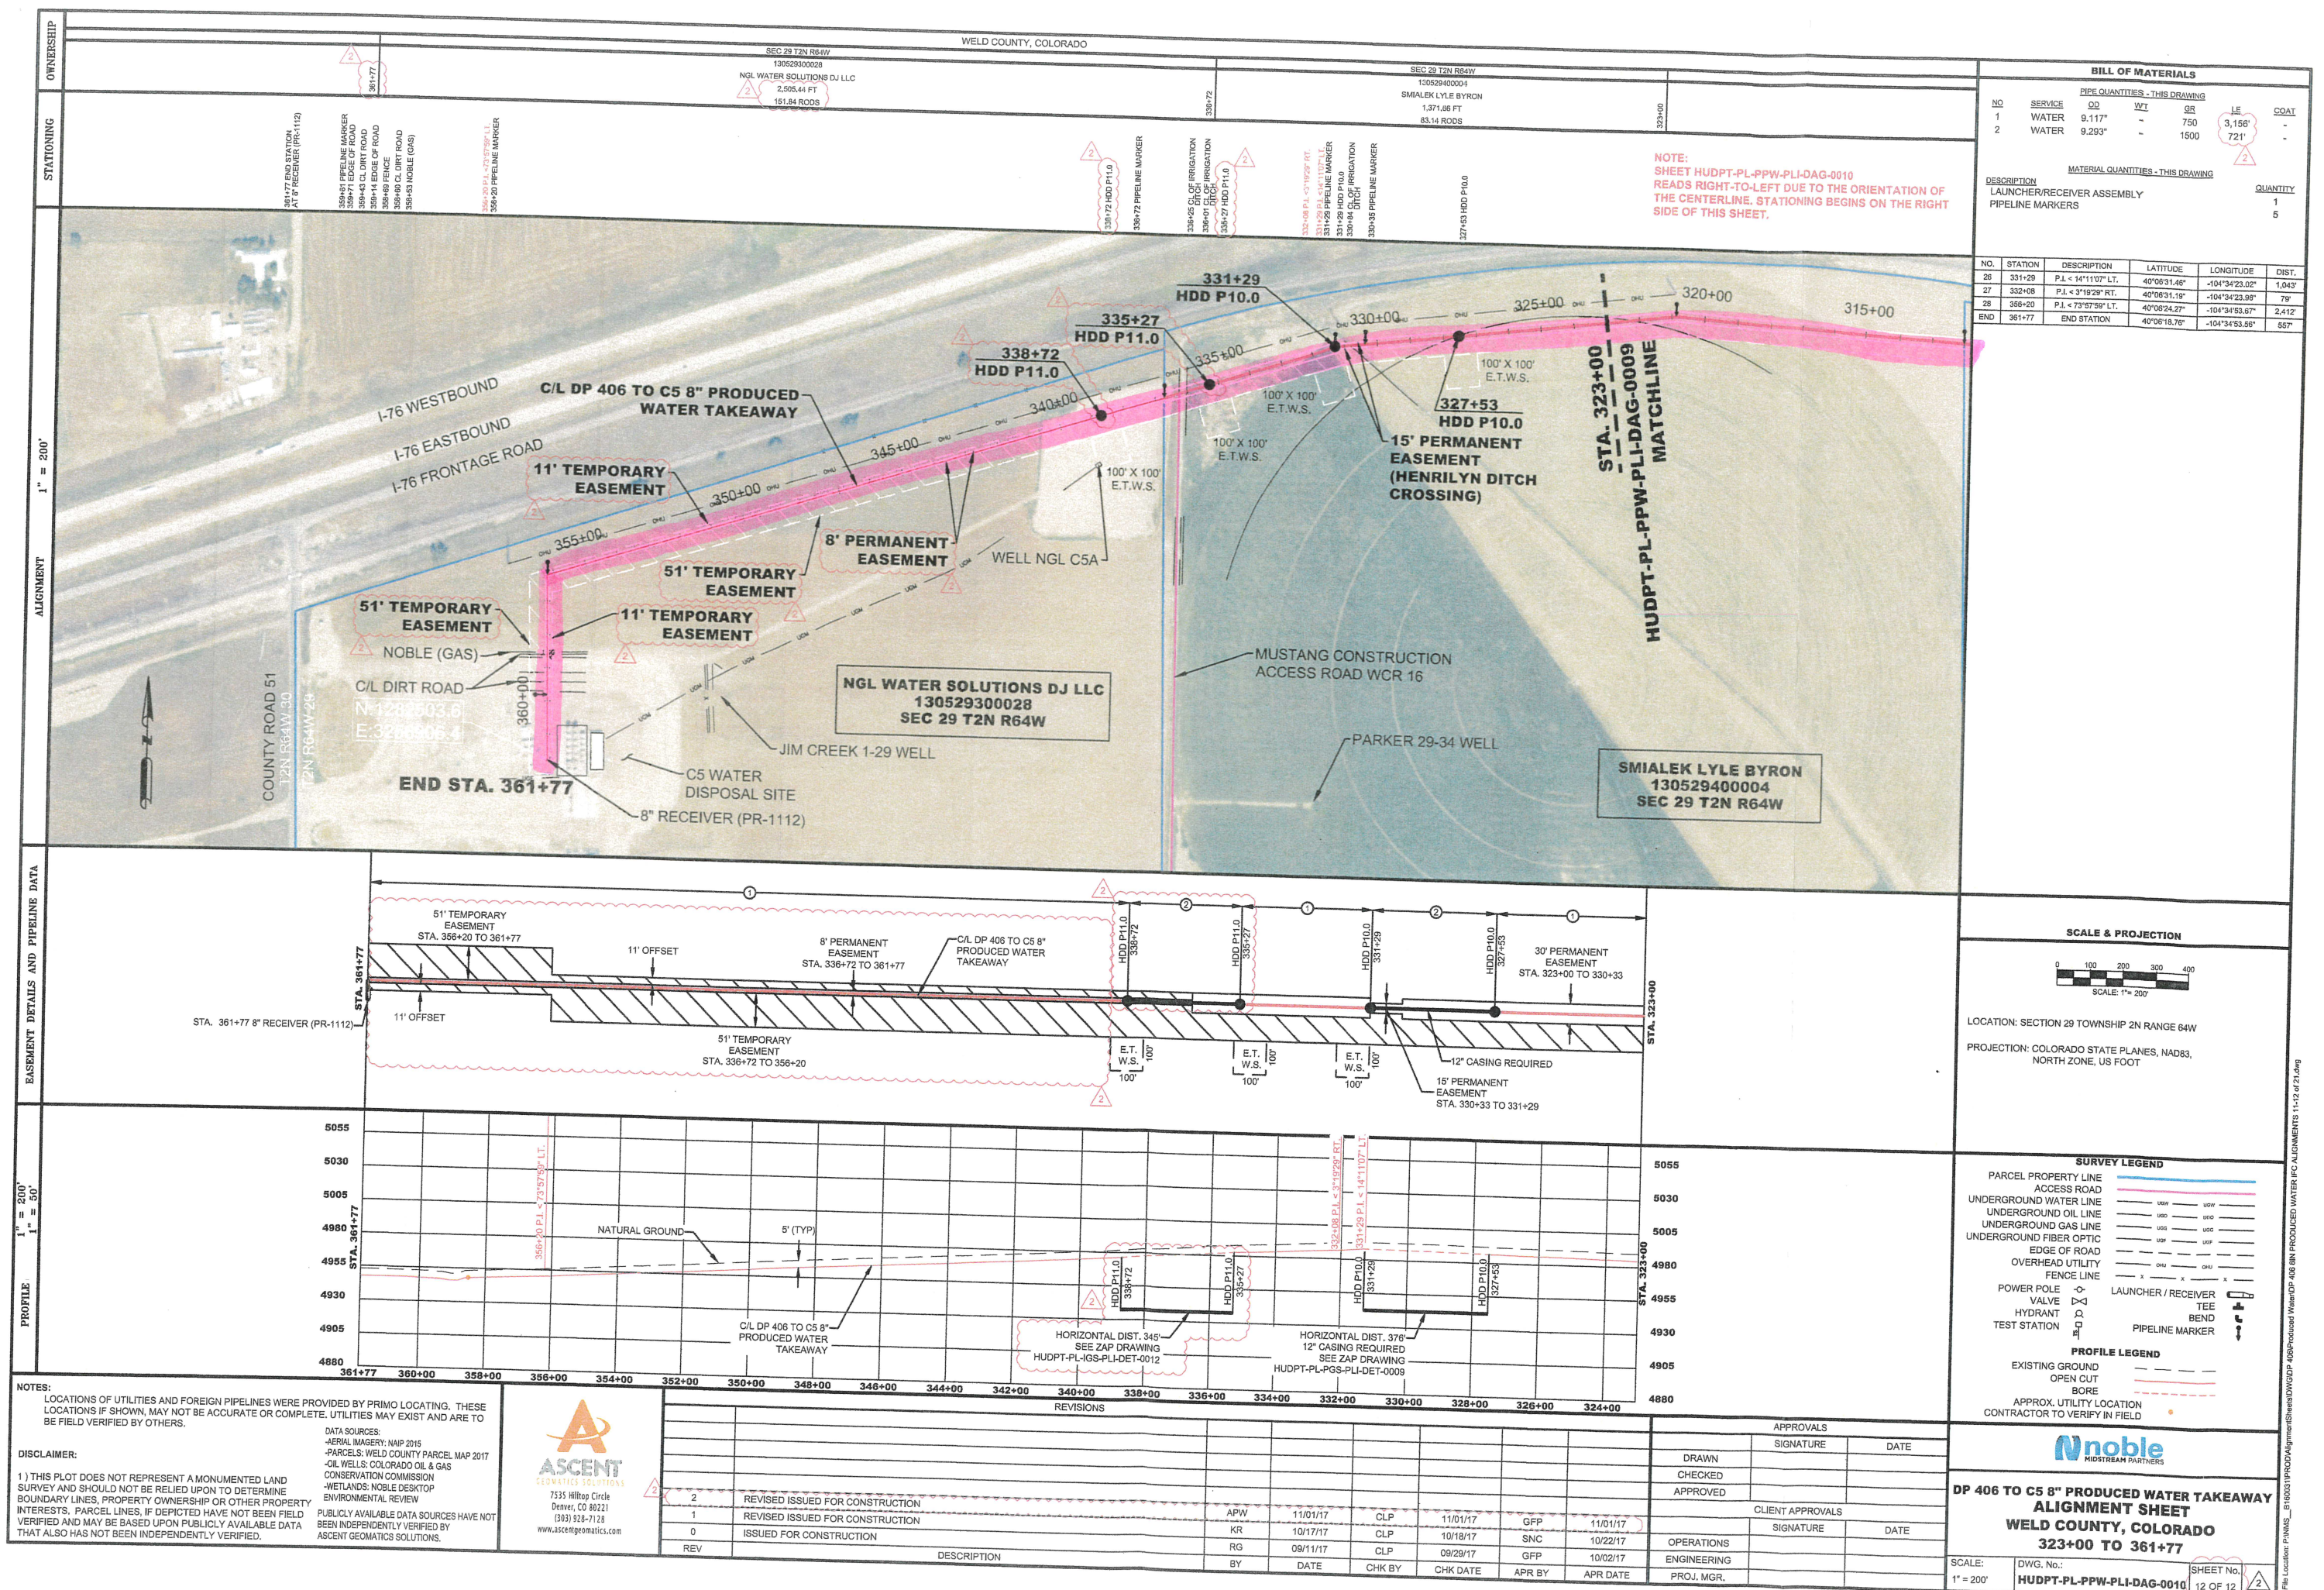



Mustang Ranch—Gathering Project

DP 406 to C5 Water Disposal – 8" Produced Water Pipeline (CL 300) Hydrostatic Pressure Test Procedure

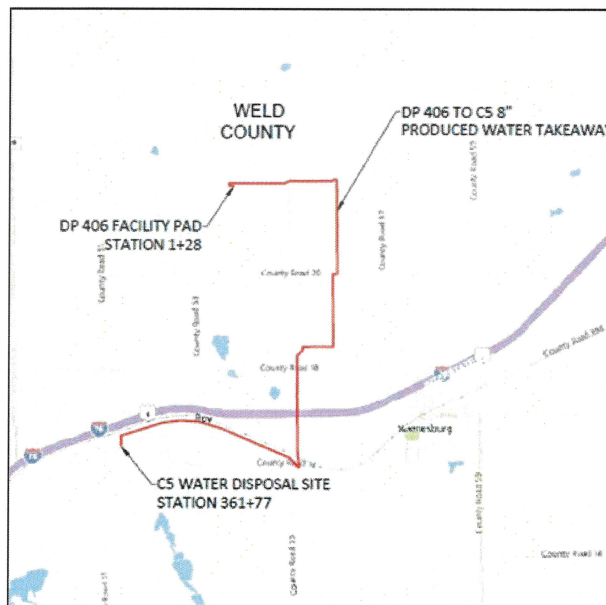

1	5/9/2018	DAN	Updated to Incorporate piping Upstream of Launcher		
0	2/23/2018	SSD	Issued for Implementation	DAN	
REV	DATE	BY	DESCRIPTION	CHKD	APPVD
			Noble Midstream Partners, LLC		
			Hydrostatic Pressure Test Procedure		
			Doc. No. N/A		



	Hydrostatic Pressure Test Procedure DP 406 to C5 Water Disposal – 8" PW Pipeline				DJBU
	NMP Doc. No.:	N/A	Rev.:	0	

TABLE OF CONTENTS

1	EXECUTIVE SUMMARY	3
2	PRE-TEST CONSIDERATIONS	3
2.1	TEST PRESSURE.....	3
2.2	TEST DURATION.....	4
2.3	SAFETY PRECAUTIONS.....	4
2.4	TEST EQUIPMENT AND MATERIALS.....	4
2.5	QUALIFICATION OF CONTRACTOR AND OPERATOR PERSONNEL	6
2.6	PERMIT TO WORK.....	6
3	TEST PROCEDURE	6
3.1	SOURCE WATER	6
3.2	EQUIPMENT INSTALLATION	7
3.3	LINE FILL	7
3.4	INITIAL PRESSURIZATION	8
3.5	PIPE CONDITIONING.....	9
3.6	THE TEST PERIOD	10
3.7	SEARCHING FOR LEAKS	11
3.8	PRESSURE TEST FAILURES	11
3.9	DEPRESSURIZATION, DISPLACEMENT, AND DISPOSAL OF TEST WATER	11
3.10	DRYING OPERATIONS	12
4	RECORDS	12
5	REFERENCES.....	13

	Hydrostatic Pressure Test Procedure DP 406 to C5 Water Disposal – 8” PW Pipeline				DJBU
	NMP Doc. No.:	N/A	Rev.:	0	

1 EXECUTIVE SUMMARY

This procedure and the accompanying site-specific Hydrostatic Test Plan define the minimum requirements for the hydrostatic pressure testing of the **DP 406 PW Skid to C5 Water Disposal – 8” PW** pipeline. **This test will incorporate approximately 45’ of 8” FlexSteel and Stainless Steel Riser Upstream of Launcher/ Downstream of PW Skid.** The piping and components to be tested using this procedure meet or exceed the pressure requirements of the ASME Class 300 flange rating for Type 2.2 materials between -20 °F and 100 °F.

The hydrostatic pressure test has been analyzed for acceptable practices per applicable codes.

2 PRE-TEST CONSIDERATIONS

The pressure test shall comply with American Petroleum Institute’s “Pressure Testing of Steel Pipelines for the Transportation of Gas, Petroleum Gas, Hazardous Liquids, Highly Volatile Liquids or Carbon Dioxide.” (*API RP 1110*) Chapter 6 of API’s handbook provides general guidelines for pressure test implementation of steel pipe. In addition, testing will be in accordance with *ASME B31.4*, *ASME B16.5*, *49 CFR Part 195*, and the *FlexSteel Technical Manual*.

2.1 TEST PRESSURE

The **8” DP 406 PW Skid to C5 Water Disposal** pipeline shall be tested at a minimum test pressure of 125% the internal pressure rating and a maximum test pressure of 150% the internal design pressure rounded to the next higher 25 psig increment. The upper and lower bounds of the test pressures are derived from *ASME B16.5* and *ASME B31.4 / 49 CFR Part 195* respectively.


The **DP 406 PW Skid to C5 Water Disposal** internal design pressure is **720 PSIG**, limited by the stainless steel flange rating.

The **DP 406 PW Skid to C5 Water Disposal** final hydrostatic test pressure shall be **1,000 PSIG** or **983 PSIG**, at the point of filling, depending on where the operator chooses to fill the pipeline. See the table in **Section 3.4** for the two possible locations.

The minimum pipeline test pressure shall be **940 PSIG** and the maximum test pressure shall be **1,100 PSIG**.

Table 1: Upper and Lower Bound Test Pressures

ASME Flange Class	Pipeline Wall Thickness (in)	Design Pressure – DP (psig)	Pipe Pressure Rating – PR (psig)	Minimum Test Pressure 125% PR (psig)	Maximum Test Pressure 150% DP (psig)
300	0.7435	720	750	940	1,100

	Hydrostatic Pressure Test Procedure				DJBU
	DP 406 to C5 Water Disposal – 8” PW Pipeline				
	NMP Doc. No.:	N/A	Rev.:	0	

2.2 TEST DURATION

The hydrostatic test pressure shall be maintained for **8 hours** after final test pressure has stabilized, and the pipe has been conditioned properly in the field. With pipe conditioning, accounted for, the test commonly takes **16 – 20 hours**. This is dependent, however on how well the pipe responds to the conditioning procedure (**times up to 24 hours may be required**).

The test pressure shall be considered stabilized after **5 minutes** without fluctuation.

2.3 SAFETY PRECAUTIONS

This safety information is in addition to the safety information in other sections of this document.

Always take precautions to eliminate hazards to persons near lines being tested. For the entire duration of the procedure, including filling, initial pressurization, time at test pressure, and depressurization, only persons conducting the test or inspecting the system should be allowed near the section under test. These persons should be fully informed of the hazards of field pressure testing. All other persons should be kept a safe distance away. The test section must be supervised at all times. Failure may result in sudden, violent, uncontrolled, and dangerous movement of system piping, or components, or parts of components.

2.4 TEST EQUIPMENT AND MATERIALS

Pressure test equipment shall be selected to meet the hydrostatic test conditions and shall be in working order. The measurement equipment shall be designed for the pressures expected during the pressure test.

2.4.1 FILL PUMP

The pump used to fill the line shall be a high-volume pump which provides adequate pressure to overcome static head and maintains sufficient velocity to move pigs, spheres, and any debris in the pipeline.

The fill pump or associated discharge piping shall be equipped with a flow measurement device capable of maintaining a specified fill rate.


2.4.2 SUPPLY WATER FILTER

The pump discharge piping shall be equipped with an in-line filter capable of capturing debris greater than **1 mm**.

2.4.3 PRESSURIZATION PUMP

The pressurization pump shall be a variable speed, positive displacement pump that pressurizes the line to the specified test pressure. The pump shall have a known volume per stroke and shall be equipped with a stroke counter.

A constant-speed pump with a variable flowrate control may be used in lieu of the above pump if the liquid test medium injected into the pipeline is measured during pressurization.

	Hydrostatic Pressure Test Procedure DP 406 to C5 Water Disposal – 8" PW Pipeline				DJBU
	NMP Doc. No.:	N/A	Rev.:	0	

2.4.4 CALIBRATION DEVICES

2.4.4.1 Pressure Calibration Device

A deadweight tester or an equivalent pressure sensing device that is capable of measuring in increments of less than or equal to one (1) psig shall be used. The device shall have a certificate of calibration that is not more than one year old at the start of testing.

2.4.4.2 Temperature Calibration Device

A certified thermometer shall be provided. The device shall have a certificate of calibration that is not more than one year old at the start of testing.

2.4.5 RECORDING DEVICES

2.4.5.1 Pressure Recording

This procedure refers to the recording device used during the test duration as a chart recorder. A digital recorder may be used in lieu of the more traditional chart recorder.


Pressure recording equipment shall be provided and qualified as follows:

- A continuous-recording pressure measurement device that provides a permanent record of pressure versus time. This device should be calibrated immediately before each use with the deadweight tester.
- Electronic pressure/temperature monitoring and recording systems that assist in the analysis of test data. Such systems can be used in lieu of the components listed above provided that the individual pressure sensors included in the systems have a level of sensitivity and can be field calibrated in a manner similar to those instruments listed above.

2.4.5.2 Temperature Recording

Temperature recording equipment shall be provided and qualified as follows:

- A test medium temperature sensing and display instrument that is properly calibrated to a range suitable for anticipated test temperatures. Temperature instrument accuracy should be within 1 °F of actual temperature. Temperature instrument sensitivity should be within 0.1 °F.
- A continuous-recording temperature measurement device that provides a permanent record of test medium temperature versus time. This device should be calibrated immediately before each use with a certified thermometer.
- An ambient temperature sensing and display instrument that is properly calibrated to a range suitable for anticipated ambient temperatures. Temperature instrument accuracy should be within 1 °F of actual temperature. Temperature instrument sensitivity should be within 0.1 °F.
- A continuous-recording temperature measurement device that provides a permanent record of ambient temperature versus time. This device should be calibrated immediately before each use with a certified thermometer.

	Hydrostatic Pressure Test Procedure DP 406 to C5 Water Disposal – 8" PW Pipeline				DJBU
	NMP Doc. No.:	N/A	Rev.:	0	

2.4.6 SAFETY RELIEF VALVE

The hydrostatic test fill pump and pressurization pump or associated discharge piping shall be equipped with a pressure relief valve. The pressure relief valve shall be set to relieve at **1,100 PSIG**, maximum test pressure.

2.5 QUALIFICATION OF CONTRACTOR AND OPERATOR PERSONNEL

Qualifications of contractor and operator personnel for conducting pressure tests will be based on certification requirements by *49 CFR Part 195*, Code, or Noble standards and procedures.

Noble personnel and contractors involved with designing, planning, conducting, or approval of a pressure test should be qualified by both training and experience. Noble is responsible for establishing these qualifications. The following factors to determine qualifications are recommended per *API RP 1110*:

- Performance of applicable calculations and interpretation of test data and results.
- Knowledge of code requirements and regulations.
- Qualification requirements of governing authority to conduct or witness testing.
- Governmental or operator requirements to certify test results.
- Familiarity with equipment and pressure test set-up.
- Familiarity with test procedures.

2.6 PERMIT TO WORK

Prior to commencing work, work permits shall be obtained. At a minimum, the below documents shall be submitted:


- Operator Qualification records for each person performing tasks.
- Test equipment certifications.
- Water source.
- Biocide injection plan. (If Applicable)
- Biocide Safety Data Sheets (SDS). (If Applicable)
- Leak monitoring plan.
- Depressurization plan.
- Water disposal plan.
- Drying plan (If Applicable).

3 TEST PROCEDURE

As part of the work permit, a hydrostatic test plan for each section of pipe shall be developed and submitted to the appointed Noble representative prior to commencing work. The test plan shall, at a minimum, address the requirements specified in this procedure.

3.1 SOURCE WATER

The quality and source of the test water shall be determined prior to the permitting process.

	Hydrostatic Pressure Test Procedure DP 406 to C5 Water Disposal – 8” PW Pipeline				DJBU
	NMP Doc. No.:	N/A	Rev.:	0	

Non-potable water shall be treated with biocide prior to entering the pipeline. The SDS sheets and injection rate for the Biocide shall be submitted and approved by a Noble representative prior to work permit issuance. **Note: Biocide treatment may not always be required.**

Water shall be filtered prior to entering the pipeline. The maximum allowable particle size is **1 mm**.

3.2 EQUIPMENT INSTALLATION

If possible, excavated segments shall be backfilled prior to the initial pressurization.

Temporary piping shall be properly anchored and adequately secured from movement. Pipe couplings shall have safety devices or restraints to limit movement due to unexpected piping separation.

A flow meter shall be placed in the line to monitor and maintain the planned design rate of fill.

The sensor on each temperature recording device shall be installed so that it is in contact with the pipeline at a point where it has normal cover. Additionally, it shall be at a distance far enough from the injection point so that the effects of the exposed piping and make-up injection(s) on temperature is minimized. The backfill around the temperature recording device sensor shall be tamped.

Insulation, if appropriate, shall be used on the capillary lines to the temperature recorder and the temperature recorder should be installed in an insulated box. Large centrifugal pumps and storage tanks will affect the temperature of the test medium.

NOTE: According to the *FlexSteel Commissioning Field Notes*, FlexSteel recommends that the vent valves on all end fittings be removed during the hydrostatic test and replaced thereafter.

3.3 LINE FILL


Calculated line fill water volume: **2,039 US Oil Barrels**

All temporary piping and test heads shall be adequately secured before the line fill process is started.

If pigs or spheres are used in the filling process, they shall be equipped with trackers for monitoring location and speed during the line fill process.

NOTE: Only polyurethane pigs are allowed to be used with FlexSteel. (*FlexSteel Commissioning Field Notes*)

The fill pump shall be sized for the pigs to travel at a speed that will maintain a seal with the pipeline. This will reduce the risk of introducing air behind the pigs. A travel speed of 2 – 3 mph shall be maintained. The line fill flow rate for the **8” DP 406 to C5 Water Disposal** pipeline must be **450 – 680 GPM (11 – 16 BPM)** in order to maintain the pig velocity in the 2 – 3 mph range.

	Hydrostatic Pressure Test Procedure DP 406 to C5 Water Disposal – 8" PW Pipeline				DJBU
	NMP Doc. No.:	N/A	Rev.:	0	

High velocities may cause excessive wearing of the pigs and may cause the displaced air to mix with the test medium. As pigs travel down the line and down a slope, unless backpressure is applied during the line fill, the weight of the column of fluid could cause the pig to travel faster than the specified speed and introduce air behind the pig.

Air shall be bled during the filling process to minimize the time for line pressure stabilization. The total amount of residual air shall be less than 0.2% of the volume of the test section.

If it is determined that air is trapped in the pipeline, vents or traps at high elevation points may be installed in order to bleed the air from the pipeline. Any equipment added to the pipeline shall be removed after the pipeline has been dewatered.

The temperature, pressure, and flow rate of the test medium during line fill shall be recorded. All applicable conditions shall be monitored to prevent over-pressurization during line fill.

3.4 INITIAL PRESSURIZATION

A pipe maintained at high pressure is potentially dangerous. Established safety guidelines in accordance with the work permit shall be followed at all times.

The amount of water required to increase the pressure from the initial fill to the final test pressure shall be calculated prior to the pressure test and made available to test personnel.

The initial pressurization of the segment of pipe to be tested begins once the segment is full of fluid and the appropriate measures have been taken to bleed all air.

Personnel conducting the test shall maintain continuous surveillance over the operation to ensure that it is carefully controlled. Test personnel should be located at a safe distance from the test section.

Pipe connections shall be periodically checked for leaks during the pressurization process.


The flowrate shall be monitored and logged for the preparation of a pressure-volume plot.

A pressure-volume plot shall be initiated at the start of the pressurization process and continue until the test pressure is reached. The lower end of the pressure-volume plot can be used to determine the total amount of residual air in the test section. The upper end of the pressure-volume plot can be used to determine if any pipe in the test segment may have reached its elastic limit.

The **8" DP 406 PW Skid to C5 Water Disposal** pipeline is **36,049 feet** of **9.117" OD 0.7435" w.t.** FlexSteel pipe. It will be pressurized to either of the following hydrostatic test pressures at the corresponding location:

Launcher Site	1,050 psig
Receiver Site	1,026 psig

Pressurization up to 25% of the final test pressure shall occur at a rate of **10 PSIG/MIN.**

	Hydrostatic Pressure Test Procedure				DJBU
	DP 406 to C5 Water Disposal – 8” PW Pipeline				
	NMP Doc. No.:	N/A	Rev.:	0	

Once 25% of the final test pressure is reached, the pressure must be allowed to stabilize for a minimum of **15 minutes**. The pressure shall be considered stabilized after **5 minutes** without fluctuation.

This process should be repeated for pressurizing the pipe to 50% of the final test pressure. Once the pressure has stabilized for **15 minutes**, the pipe should be pressurized to 75% of the final test pressure at a rate of **10 PSIG/MIN**. Now, the pressure should be allowed to stabilize for 1 hour.

After the pressure has stabilized to 75% of the final test pressure, pressurization at a rate of **5 PSIG/MIN** shall be used to complete the pressurization process up to the final test pressure. The final test pressure shall be considered stabilized after **5 minutes** without fluctuation.

When the final test pressure is reached and has stabilized, pressurization shall cease, the pipe blocked in, and all valves and connections to the line shall be inspected for leakage.

3.5 PIPE CONDITIONING


FlexSteel must be conditioned prior to commencing a "hold" or test period. This is for the purpose of allowing the polymer liner in the FlexSteel to creep to bed into the tensile elements in the FlexSteel. (*FlexSteel Technical Manual*)

After the test pressure has stabilized in the Initial Pressurization phase, the pipe should be blocked in. Then, the pressure drop in the pipe should be monitored and recorded continuously, or at least every fifteen (15) minutes for 1 hour. After that, the pipe should be re-pressurized to the test pressure, blocked in, and have its pressure monitored and recorded continuously, or at least every fifteen (15) minutes for 1 hour. (*FlexSteel Technical Manual*)

The two recorded pressure drops should be compared. If the rate of pressure drop is smaller for the second run, the pipe is conditioning and not leaking. (*FlexSteel Technical Manual*)

However, if the pressure drop rate does not decrease, there is a possibility that leak exists in the pressure boundary system. These leaks are usually in the test equipment or flanges rather than the pipe. If this occurs, testing should continue for two (2) additional cycles to verify that the pressure drop rate is still not changing. If the pressure drop rate remains constant, or increases, the test fittings and flange connections should be checked for leakage. Following this, if there is still no decline in the rate of pressure drop, the pipe is leaking. A leak in the pipe is rare, and if it occurs, it could result from a faulty end fitting or end fitting installation. Thus, the end fittings should be carefully inspected and/or replaced to determine if the leak occurred at an end fitting. (*FlexSteel Technical Manual*)

If the rate of pressure drop did decrease without any issues, the cycle of pressurizing to the test pressure, blocking the pipe in, and monitoring and recording the test pressure for an hour should continue a few more times to get more data and demonstrate that the rate of pressure drop is decreasing with each cycle. If an issue arises, then the steps mentioned above to determine if a leak is present should be followed.

	Hydrostatic Pressure Test Procedure DP 406 to C5 Water Disposal – 8" PW Pipeline				DJBU
	NMP Doc. No.:	N/A	Rev.:	0	

Otherwise, the anticipated 24-hour test pressure drop shall be calculated. That is, in a hypothetical 24-hour test, the anticipated pressure drop shall be calculated assuming the most recent pressure drop rate is maintained. If the predicted pressure is less than the Lower-Bound Test pressure (see the Site-Specific Hydrostatic Test Plan), then more conditioning cycles are needed. After each cycle, the predicted pressure drop shall be calculated for a 24-hour test to see if the pressure will always stay above the Lower-Bound Test Pressure. Once this has been confirmed, the pipe has been properly conditioned. The pipe should be re-pressurized to the test pressure, blocked in, and The Test Period shall start. (*FlexSteel Technical Manual*)

NOTE: The conditioning process can take several hours (8 – 12). It may be the case that the pipe needs to be pressurized up to the final test pressure a few times to finalize the conditioning before being blocked in and starting the test period. Also, it is recommended that all personnel be at least 50 feet away from the pipe during the pressure test. (*FlexSteel Commissioning Field Notes*)

Conditioning may occur during the evening and/or in cold weather situations and precautions must be taken to eliminate the possibility of freezing in the appurtenances, such precautions may include the use of thermal blankets and heaters.

3.6 THE TEST PERIOD

The Test Period shall begin after the temperature of the test medium, pipe temperature, and ground temperature have stabilized. When this stabilization process is complete, the pressurization pump should be isolated from the test section.


After inspecting for leakage, test personnel shall verify that the specified test pressure is being maintained.

Pressure and temperature shall be continuously monitored during the test. Data shall be recorded every half hour throughout the duration of the test.

The maximum allowable range of pressure fluctuation during the pressure test is defined by the “**Upper Bound Test Pressure**” and “**Lower Bound Test Pressure**” as shown in the **site-specific Hydrostatic Test Plan**, which is supplemental to this Hydrostatic Test Procedure. Any pressure excursions outside of these limits shall be reported to the Noble representative for further analysis.

Weather changes, such as the development of rain or clouds, which could affect the pressure and temperature of the pipe and test medium shall be documented on the test log.

The volume of any added or subtracted test medium shall be documented on the test log as well as its temperature and pressure at that time and be accounted for in the assessment of the results of the pressure test. For any pressure test of piping that cannot be 100% visually checked for leaks, it is mandatory that the volume of any test medium added or removed be accounted for to determine if the pressure test has been completed without evidence of leakage.

	Hydrostatic Pressure Test Procedure DP 406 to C5 Water Disposal – 8" PW Pipeline			DJBU
	NMP Doc. No.:	N/A	Rev.: 0	

3.7 SEARCHING FOR LEAKS

Prior to commencing work, the method(s) for locating leaks or failures shall be approved by the Noble representative. The operator may choose to fly, drive and/or walk the pipeline right-of-way to visually check for evidence of leaks during the pressure test. The operator should develop contingency plans for locating large and small leaks in areas of difficult terrain or in the event of inclement weather.

Acceptable methods for finding leaks during a pressure test are listed as follows:

- Sectioning or segmenting the pipeline and monitoring the pressure of each section. Closing mainline block valves will isolate the pipeline into smaller segments. Freeze plugs may also be used to isolate sections of the pipeline for evaluation.
- Acoustical monitoring equipment may be employed to narrow the search area.
- Odorants or tracers introduced into the test medium during the filling process will allow the operator to detect leaks with sensing equipment.

3.8 PRESSURE TEST FAILURES

All leaks and test failures shall be reported to the Noble representative immediately.

Any pipeline leaks or failures shall be documented in the test report.

If a rupture or a substantial leak occurs, the test shall be stopped and the pipeline depressurized. The cause of failure shall be understood, test procedures shall be reevaluated, and approval from the Noble representative shall be obtained before proceeding with repairs and starting a new hydrostatic test.

Pipe, valves, fittings, and test components that fail during a pressure test shall be investigated to determine the cause of failure and to minimize the possibility of a recurrence.

Pipe or other failed components shall be preserved for further examination and failure analysis.


If a small leak occurs, the pressure should be reduced to 80% of the final test pressure while locating the leak. After repairs are completed and authorization from the Noble representative has been obtained, the test can be restarted per the initial pressurization steps above.

Pressure excursions outside of the **Maximum and Minimum Test Pressures** as defined in **Section 2.1** of this procedure are considered test failures.

3.9 DEPRESSURIZATION, DISPLACEMENT, AND DISPOSAL OF TEST WATER

Prior to commencing work, a depressurization, displacement, and disposal plan shall be submitted to and approved by the Noble representative.

Depressurization activities shall not commence without authorization from the Noble representative. Once authorization is received, depressurization should commence at a rate of **10 PSIG/MIN** in increments of 25% of the final test pressure. The pressure should be allowed to stabilize for **15 minutes** between increments.

	Hydrostatic Pressure Test Procedure DP 406 to C5 Water Disposal – 8" PW Pipeline				DJBU
	NMP Doc. No.:	N/A	Rev.:	0	

Displacement and disposal activities shall not commence prior to Noble engineering acceptance of the hydrostatic test results.

A disposal plan for the test medium must be developed and the Noble representative shall review and approve the disposal plan.

Pigs or spheres used in the dewatering process shall be equipped with trackers for monitoring location and speed during the dewatering process.

The travel speed for the dewatering pigs shall be maintained at **2 – 3 MPH**.

3.10 DRYING OPERATIONS

If the pipeline will not be placed into service within seven (7) days of dewatering, drying operations are required.


Prior to commencing work, a drying plan shall be submitted to and approved by the Noble representative.

Upon completion of drying, a **5 PSIG** nitrogen blanket shall be maintained on the pipeline until commissioning.

4 RECORDS

After the hydrostatic test has been completed, the following records shall be submitted as part of the Final Test Report, **which must be reviewed and accepted by an authorized Noble representative**. These records must be retained as long as the pipeline is in use.

- Pressure / Volume Plot
- Pressure Recording Chart / Plot
- Calibration Records
 - Deadweight Tester
 - Chart Recorder
 - Temperature Recorders
 - Certified Thermometer
- 49 CFR Part 195 Operator Qualifications
 - Operator
 - Person responsible for making the test
 - Test company used, if any
- Hydrostatic Test Log, including:
 - Date and time of the test
 - Minimum test pressure
 - Test medium
 - Description of the pipeline tested and the test apparatus
- Leak Reports
- Failure Reports
- Site-specific hydrostatic test plan including:
 - Elevation profile of the pipeline
 - Locations of test sites over the entire length of the pipeline
- Temperature Chart / Plot

	Hydrostatic Pressure Test Procedure DP 406 to C5 Water Disposal – 8" PW Pipeline				DJBU
	NMP Doc. No.:	N/A	Rev.:	0	

5 REFERENCES

- 1) API RP1110 "Recommended Practice for the Pressure Testing of Steel Pipelines for the Transportation of Gas, Petroleum Gas, Hazardous Liquids, Highly Volatile Liquids, or Carbon Dioxide"
- 2) ASME B31.4 "Pipeline Transportation Systems for Liquids and Slurries"
- 3) ASME B16.5 "Pipe Flanges and Flanged Fittings"
- 4) 49 CFR Part 195 "Transportation of Hazardous Liquids by Pipeline"
- 5) "FlexSteel Technical Manual"
- 6) "FlexSteel Commissioning Field Notes"
- 7) Site Specific Hydrostatic Test Plan

DP 406 to C5 Water Disposal - 8 in Produced Water Pipeline Hydrostatic Pressure Test Plan

