


CABALA RANCH 24-42 AS-BUILT FLOWLINE EXHIBIT

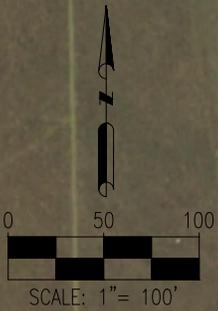

LEGEND: = WELL HEAD = RISER = FLOWLINE	CABALA RANCH 24-42	CABALA RANCH 24-42 RISER AT WELLHEAD CABALA RANCH 24-42 RISER AT SEPARATOR



7535 Hilltop Circle
Denver, CO 80221
(303) 928-7128
www.ascentgeomatics.com

FIELD DATE: 08-28-18	SURFACE LOCATION: SEC. 24, T7N, R67W, 6TH P.M. WELD COUNTY, COLORADO
DRAWING DATE: 09-04-18	
BY: SJH	CHECKED: JW

PREPARED FOR:



BAYSWATER
EXPLORATION AND PRODUCTION, LLC