

RECEIVED
NOV 9 - 1961



OIL AND GAS CONSERVATION COMMISSION
OF THE STATE OF COLORADO

NOTICE OF INTENTION TO DRILL

OIL & GAS
CONSERVATION COMMISSION


INSTRUCTIONS:

A notice of intention to drill a well shall be filed in duplicate on all Federal and Patented lands, and in triplicate on all State lands. Do not begin operations until approved copy has been received. It is mandatory that the proposed location comply with all rules and regulations of the Commission. Locate well on section grid in proper location, and indicate extent of lease. Unless operations are commenced within 180 days after the date of approval hereof, this approval to drill will become null and void.

Name of Operator Texota Oil Company Phone No. Acoma 2-0685
Address 318 Mile High Center City Denver 2, State Colo.

How is liability secured: Well Bond (Attached) ; Blanket Bond ; Waiver
(Check one)

Lease Name N. P. Lewis
Well No. #1
Field Name New Raymer Wildcat
County Weld

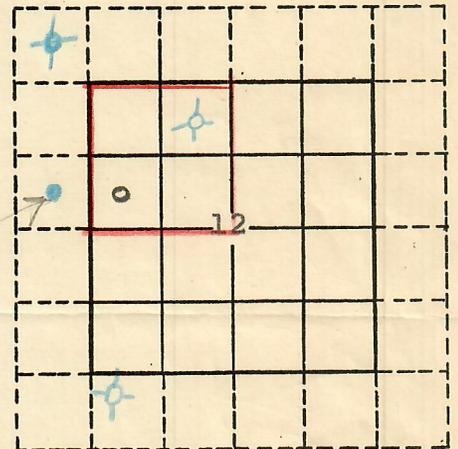

Location C SW NW Section 12 Township 7N Range 58W Meridian 64PM
(quarter quarter)
1980 feet from North Section line and 500 feet from West Section Line
~~North~~ ~~West~~ ~~E or W~~

The well is located on: Patented land State land Federal land

The well is located within a spaced area: Yes No

Distance from proposed location to nearest property or lease line 500 feet.
Distance from proposed location to nearest drilling unit line - feet.

Objectives: "J" Sand Depth 6300' ; "D" Sand Depth 6200'
Formation Estimate Formation Estimate

Proposed length of surface casing 200 feet.

REMARKS:

Agent	<i>DP</i>
Bond	<i>waived</i>
Spot	<i>Plotted 11-9-61</i>
600 ft.	<i>use letter</i>
1200 ft.	<i>2' vertical</i>
Wells	
Oil	
Gas	
Status	

I/We hereby swear (or affirm) that the statements herein made are a full and correct report.

APPROVED:
Date NOV - 9 1961
A. J. Gersin
Director

Company Texota Oil Co. Date 11/8/61
Address 318 Mile High Center Phone No. Ac. 2--0685
By D. C. Berger Title Prod. Mgr.
Signature

★