



02528974

660 ~~REC~~

WELL SITE INSPECTION

PERMIT NO 85-869OPERATOR Reverified Resources LtdDATE July 1985WELL NAME Lewis, NP #1COUNTY W

RIG _____

LEGAL SW/4WS 12T 7N R 54WSURFACE CASING ✓ SIZE 8 5/8 DEPTH 168 DATE _____

CEMENT VOLUME _____ RETURNS _____ WOC _____

PROBABLE FOX HILLS DEPTH _____

MUD PITS _____

DISPOSAL _____

PRODUCTION STRING ✓ SIZE 5 1/2 DEPTH 6387

STAGED _____ CBL CHECKED _____

SQUEEZE _____ FRAC JOB _____

BATTERY _____ SIGN _____

SITE INSPECTION AFTER DRILLING

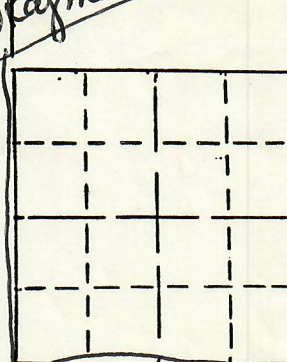
Don't know what was supposed to
happen, but TB + sep gone

Well still there with rods + tubing
Also water pit, Electric service

DIRECTIONS 2/4/86

Someone else was going to try
I said early 85. Don't think
ACTION that got done as

ENGINEER

DR BecknellNew PaymerDL