


**PIT STATUS EVALUATION FORM**

Facility ID: 115042

Pit Name: UPRR AMOCO 31-16

Duplicate Record(s) Pit #

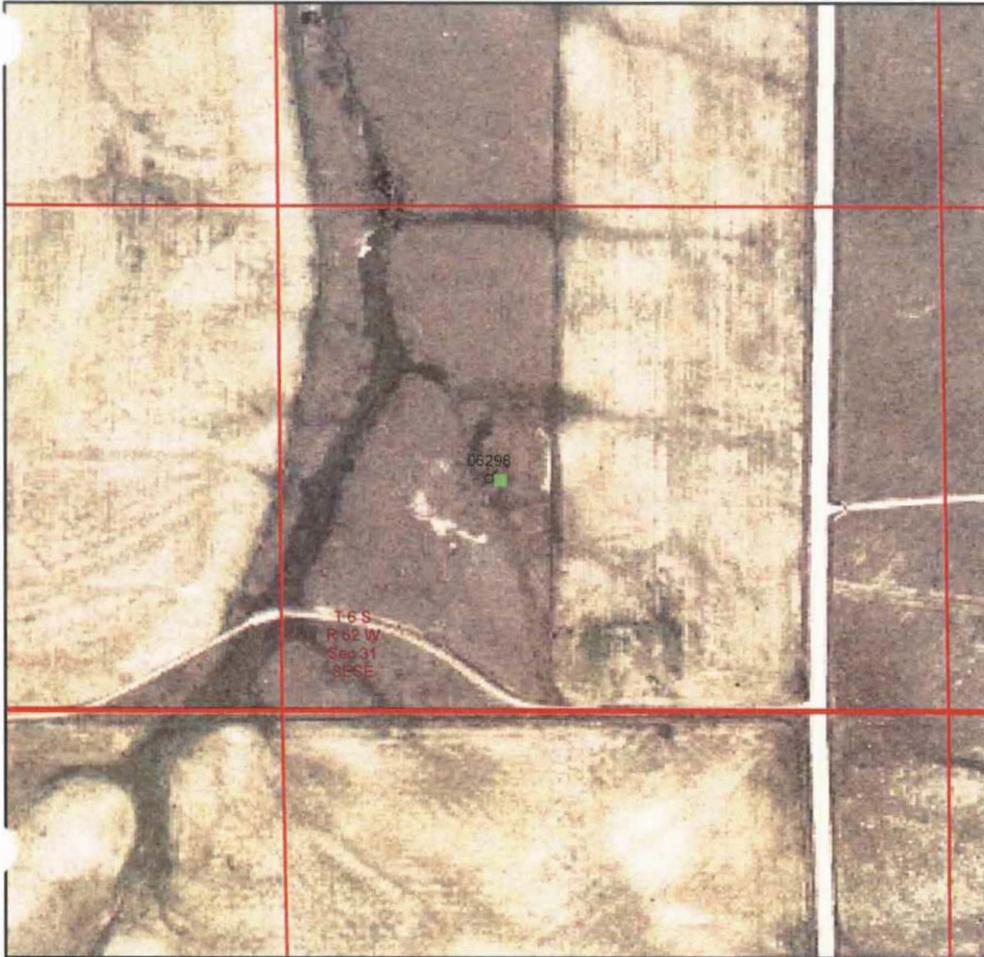

**Legend**

- Database Pit Location
- Producing Well
- + Shut In Well
- ⊗ Temp Aban Well
- ⊗ Abandoned Well
- ⊗ Dry & Aban Well
- ◆ Injection Well
- Other Well Status

1:6,000

0 250 500 750 Feet

Image Source:  
 USDA National Agricultural Imagery Program (NAIP), 2006

S.S. PAPADOPULOS & ASSOCIATES, INC.

**COGCC Database Information**

Status: NR Owner: SOHIO PETR CO AKA STANDARD OIL  
 T: 6S R: 62W Sec: 31 QQ: SESE 6th Meridian  
 Latitude: 39.478718 Longitude: -104.369982 NAD83

County: Elbert, CO  
 County Code: 039

**Pit Status Evaluation**

- Active**       Form 15: Pit Permit (1983) \_\_\_\_\_ Assoc. Well Seq No(s) \_\_\_\_\_  
 Other documentation \_\_\_\_\_  
 Aerial photo verification \_\_\_\_\_
- Closed**       Form 27: Remediation Workplan \_\_\_\_\_  
 Form 4: Sundry Notice \_\_\_\_\_  
 Rule 903a.(2)B \_\_\_\_\_  
 Evidence pit(s) existed, no closure docs & well not PR, AC or SI  
     Well API Seq #(s) 06298 PA (10-1990)  
 Other documentation WSIF # 394234 (10-1990)
- Abandoned**       Possible un-reclaimed pit(s) or adverse conditions, no closure docs       Site Visit  
 **Unknown**       No Site Visit  
 Add'l Review

Notes: WSIF pit backfilled