


PIT STATUS EVALUATION FORM

Facility ID: 115061

Pit Name: STATE 1-24 "A"

Duplicate Record(s) Pit #

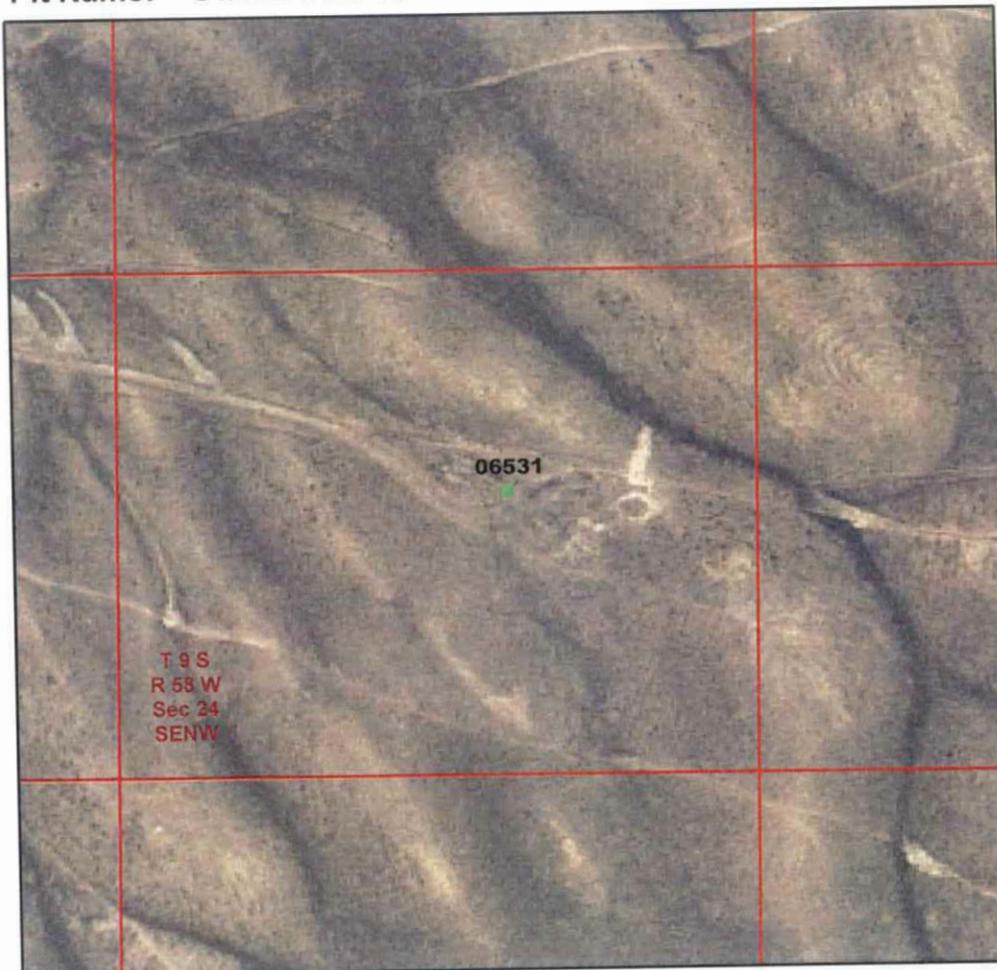

Legend

- Database Pit Location
- Producing Well
- Shut In Well
- Temp Aban Well
- Abandoned Well
- Dry & Aban Well
- Injection Well
- Other Well Status

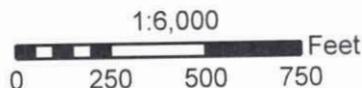


Image Source:
 USDA National Agricultural Imagery
 Program (NAIP), 2006

S.S. PAPADOPULOS & ASSOCIATES, INC.

COGCC Database Information

Status: NR Owner: CHURCHILL ENERGY INC
 T: 9S R: 58W Sec: 24 QQ: SENW 6th Meridian
 Latitude: 39.253644 Longitude: -103.837143 NAD83

County: Elbert, CO
 County Code: 039

Pit Status Evaluation

- Active**
- Form 15: Pit Permit _____ Assoc. Well Seq No(s) _____
 - Other documentation _____
 - Aerial photo verification _____
- Closed**
- Form 27: Remediation Workplan _____
 - Form 4: Sundry Notice _____
 - Rule 903a.(2)B
 - Evidence pit(s) existed, no closure docs & well not PR, AC or SI
 Well API Seq #(s) 06531 PA (12-6-1991)
 - Other documentation WSIF (12-27-1991)
- Abandoned** Possible un-reclaimed pit(s) or adverse conditions, no closure docs
- Unknown**
- Site Visit
 No Site Visit
 Add'l Review

Notes: WSIF (1991) "pits back filled & site recontoured to original"