


Colorado Interstate Gas

LEASE: Flank # 39
FIELD: Flank
COUNTY: Baca
STATE: Colorado
LOCATION: 5 34S 42W
API #: 05-009- 06227-00
SPUD DATE: 08/16/1979
Rev. Date 08/01/2005
ELEVATION: 3792' KB: 0
TD: 4730' GL PBTD: 4700' GL

Perfs 4095' – 4104' GL w/ 2 SPF

PBTD @ 4700' GL

TD 7-7/8" hole @ 4730' GL

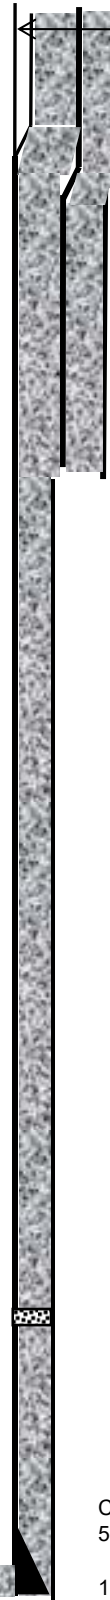

3 jts 5-1/2" w/ seal assembly
stabbed into receptacle @ 85' GL
2 jts, 9 5/8", 36#, K55, 8R, LT&C
casing 0' – 85' GL swaged to 5-
1/2" csg

3 jts, 135', 13-3/8", 54.4#, 8R, K55,
ST&C csg from 0 – 123' GL swaged to 8-
5/8" csg

TD 17-1/4" Hole @ 150' GL

Cemented surface w/ 600 sxs, HLC &
150 sxs Class H. Cmt Circ.

33 jts, 8-5/8", 24#, K55, 8R, ST&C csg
from 123' – 1447' GL

TD 12-1/4" Hole @ 1452' GL

Cemented w/ 825 sxs HLC and 200 sxs
50/50 poz. Cmt Circ.

114 jts, 5-1/2", 15.5#, K55, 8R, LT&C
casing set at 4724' GL