Guttersen 12-9
Current WBD

2027 FNL605 FWL SWNW 9 4N 63W 6th PM
Lat 40.32826 Long -104.45036
Weld County, Colorado
API #05-123-26186

Spud date 9/10/2007

4696' KB
4687' GL

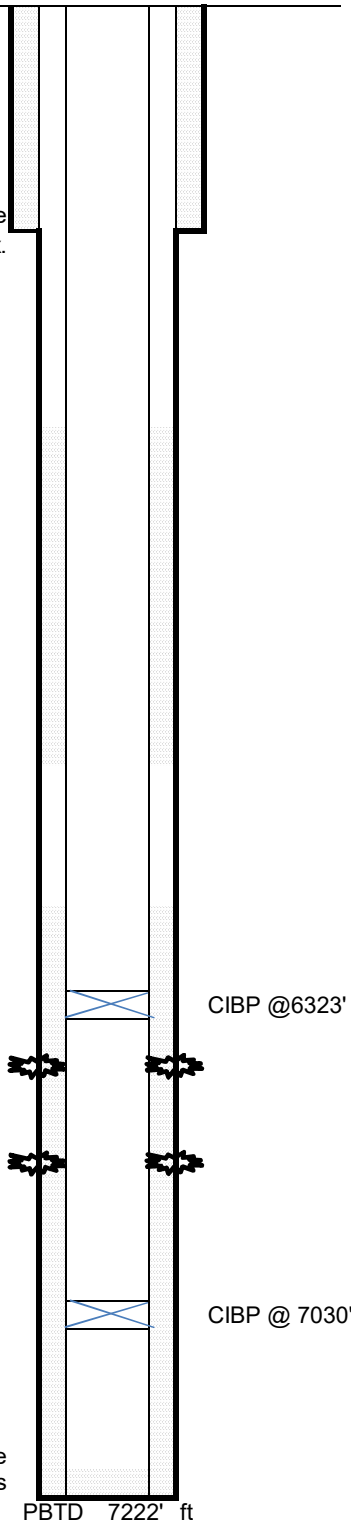

8.625", 24#/ft Wt, Grade, 840, 12.25" hole
Cemented to surface w/ 590 sx.

Water 102'
(Within 1 mile radius)

TOC 3080'

Parkman 3497'

Bottom of Cement 4210"
Cemented with 100 sxs

TOC 5970'

CIBP @6323' w/2 sx cement

Niobrara 6398'
Perfs 6402' - 6650'

Codell 6636'
Perfs 6638' - 6650'

CIBP @ 7030' w/ sx cement

J Sand 7085'
Perfs 7086' - 7094'

4 1/2", 11.6#/ft, Grade, 7220', 7 7/8" hole
Cemented with 240 sxs

PBTD 7222' ft
TD 7236' ft 9/15/2007

Updated 1/23/2019 rcs