


**PIT STATUS EVALUATION FORM**

Facility ID: 115076  
 Pit Name: UPR "C"

Duplicate Record(s) Pit #

115131

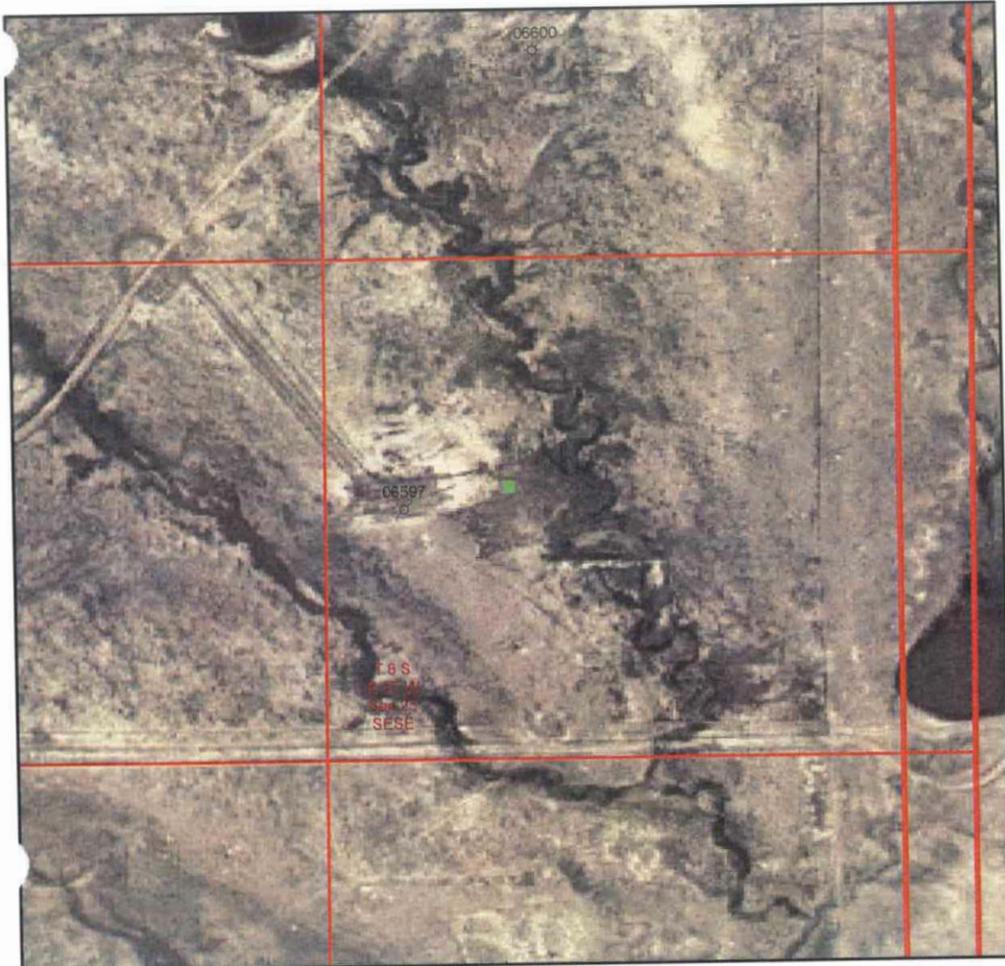

**Legend**

- Database Pit Location
- Producing Well
- + Shut In Well
- ⊕ Temp Aban Well
- ⊘ Abandoned Well
- ⊙ Dry & Aban Well
- ◆ Injection Well
- Other Well Status



Image Source:  
 USDA National Agricultural Imagery Program (NAIP), 2006

S.S. PAPADOPOULOS & ASSOCIATES, INC.

**COGCC Database Information**

Status: NR Owner: PETROLEUM INC  
 T: 8S R: 57W Sec: 25 QQ: SESE 6th Meridian  
 Latitude: 39.318443 Longitude: -103.7178 NAD83

County: Elbert, CO  
 County Code: 039

**Pit Status Evaluation**

- Active  Form 15: Pit Permit (1989) new Assoc. Well Seq No(s) \_\_\_\_\_  
 Other documentation \_\_\_\_\_  
 Aerial photo verification \_\_\_\_\_
- Closed  Form 27: Remediation Workplan \_\_\_\_\_  
 Form 4: Sundry Notice \_\_\_\_\_  
 Rule 903a.(2)B \_\_\_\_\_  
 Evidence pit(s) existed, no closure docs & well not PR, AC or SI  
 Well API Seq #(s) 06597 PA (12-15-1992)  
 Other documentation FIR# 471861 (12-9-1993)
- Abandoned  Possible un-reclaimed pit(s) or adverse conditions, no closure docs  Site Visit  
 Unknown  No Site Visit  
 Add'l Review

Notes: FIR disposal pit backfilled.