


PIT STATUS EVALUATION FORM

Facility ID: 115080

Pit Name: WHITEHEAD 12-14

Duplicate Record(s) Pit #

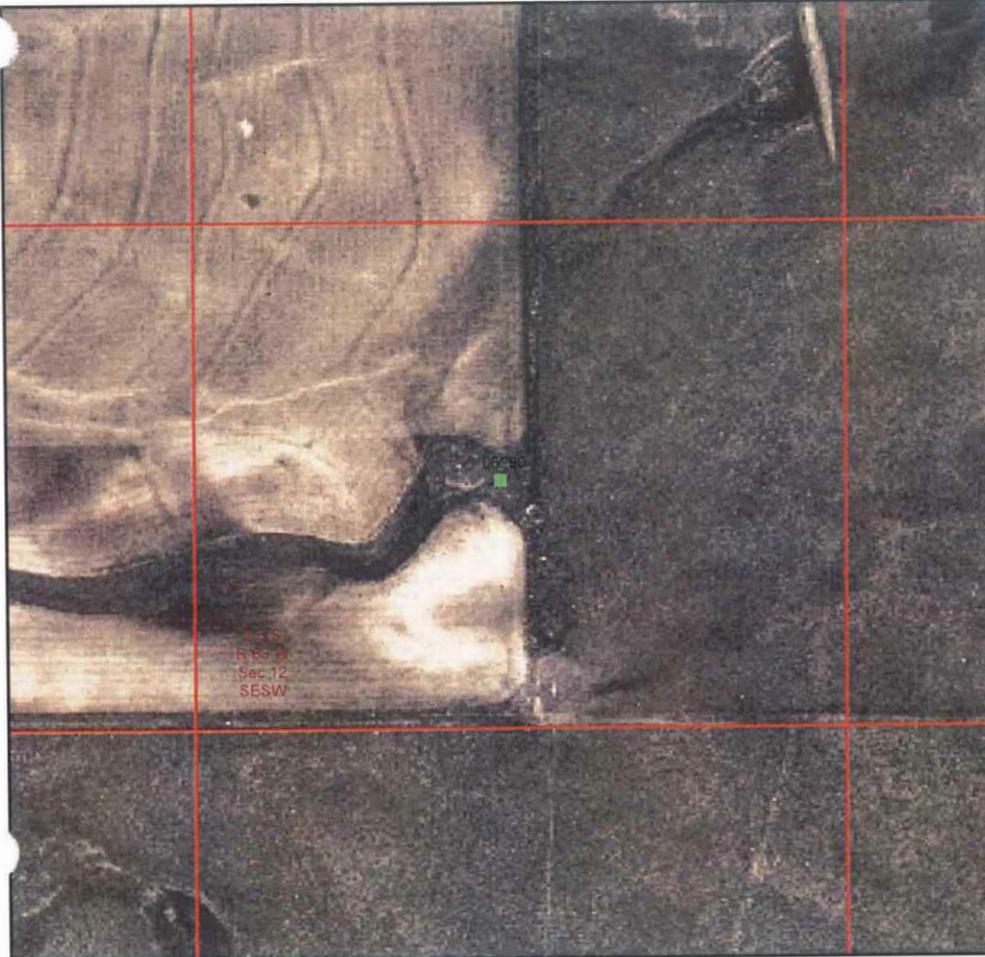

Legend

- Database Pit Location
- Producing Well
- Shut In Well
- Temp Aban Well
- Abandoned Well
- Dry & Aban Well
- Injection Well
- Other Well Status



Image Source:
USDA National Agricultural Imagery
Program (NAIP), 2006

S.S. PAPADOPOULOS & ASSOCIATES, INC.

COGCC Database Information

Status: NR Owner: PETROPLEX EQUIPMENT INC
T: 6S R: 63W Sec: 12 QQ: SESW 6th Meridian
Latitude: 39.536737 Longitude: -104.396793 NAD83

County: Elbert, CO
County Code: 039

Pit Status Evaluation

- Active** Form 15: Pit Permit (1983) existing Assoc. Well Seq No(s) _____
 Other documentation _____
 Aerial photo verification _____
- Closed** Form 27: Remediation Workplan _____
 Form 4: Sundry Notice _____
 Rule 903a.(2)B _____
 Evidence pit(s) existed, no closure docs & well not PR, AC or SI
 Well API Seq #(s) 06290 PA (8-5-1987)
 Other documentation WSIF # 432557 (6-29-1988)
- Abandoned** Possible un-reclaimed pit(s) or adverse conditions, no closure docs Site Visit
 Unknown No Site Visit
 Add'l Review

Notes: WSIF pit backfilled & site clean