


PIT STATUS EVALUATION FORM

Facility ID: 115144

Pit Name: NEIRA 1 31-23

☐ Duplicate Record(s) Pit #

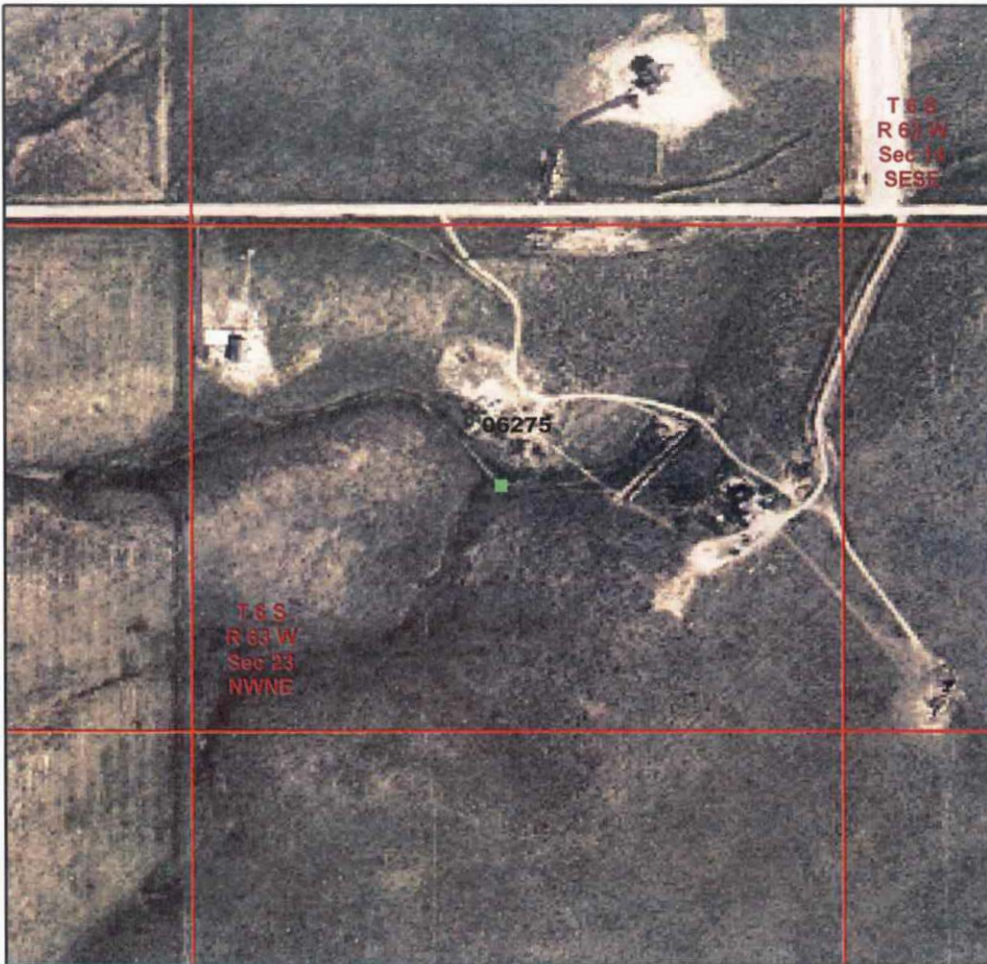

Legend

- ☒ Database Pit Location
- ☐ Producing Well
- ☐ Shut In Well
- ☐ Temp Aban Well
- ☐ Abandoned Well
- ☐ Dry & Aban Well
- ☐ Injection Well
- ☐ Other Well Status



1:6,000
0 250 500 750 Feet

Image Source:
USDA National Agricultural Imagery
Program (NAIP), 2006

 S.S. PAPADOPOULOS & ASSOCIATES, INC.

COGCC Database Information

Status: NR Owner: TRINITY ENERGY CORPORATION
T: 6S R: 63W Sec: 23 QQ: NWNE 6th Meridian
Latitude: 39.518627 Longitude: -104.410903 NAD83

County: Elbert, CO
County Code: 039

Pit Status Evaluation

- ☐ Active ☐ Form 15: Pit Permit NA Assoc. Well Seq No(s) _____
☐ Other documentation _____
☐ Aerial photo verification _____
- ☒ Closed ☐ Form 27: Remediation Workplan _____
☐ Form 4: Sundry Notice _____
☐ Rule 903a.(2)B _____
☒ Evidence pit(s) existed, no closure docs & well not PR, AC or SI
Well API Seq #(s) 06275 PA (8-21-1997)
☒ Other documentation FIR # 500141342 (5-14-99)
- ☐ Abandoned ☐ Possible un-reclaimed pit(s) or adverse conditions, no closure docs ☐ Site Visit
☐ No Site Visit
☐ Add'l Review
- ☐ Unknown

Notes: LIF (1987) skimp pit + pt. FIR (11-6-1997) "well has been plugged & location restored... final reclamation would be done by landowner"
FIR (1999) well site revegetated.