Well/Facility:	Ivers-Minch-Weber #1	Well Status:	FINAL P&A
Operator:	Magpie Operating Inc	Formation:	CDL / Nio
Lease/Op Agmt:		Prod Interval:	
Field:	Loveland	API #:	05-069-06325
County:	Larimer	GR/KB:	
State:	CO	TD:	4,780'
Spud:	2/20/1994	PBTD:	0'
Comp. Date:	3/30/1994	WI:	
1st Prod:	5/30/1994	NRI:	
Xmas tree:			
Surface Loc:	1530 FNL 155 FEL		
Sec-Twn-Rge:	SENE 30 5N68W		
Comments:	Final plugging diagram		

	Completed Work
1	Set CIBP @ 4324' with 2 sx cement
2	Cut and pull casing from 750'
3	Set 100 sx from 1,200' to 1,040' - Tag plug
4	Set 200 sx from 750' to 495' -Tag plug
5	Set 260 sx from 495' to surface
6	10 sx top job at surface
7	cut and cap 4' below ground level

Gologic Markers	
MD	
757	Parkman
1,396	Sussex
1,790	Shannon
4,355	Niobrara
4,653	Timpas
4,674	Codell

Date Drawn: Mar-21-2019

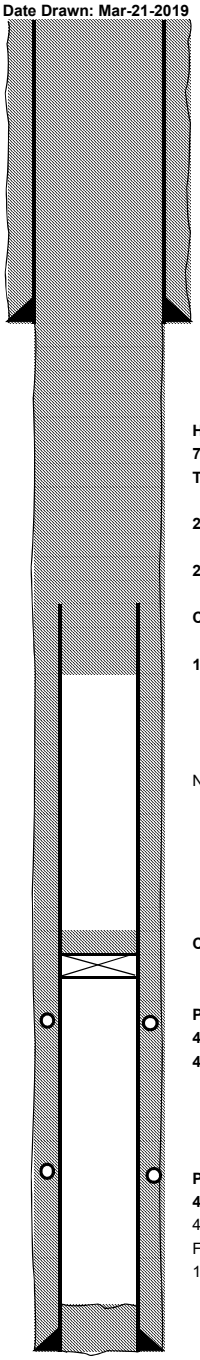

Cut off 4' below surface
Weld on cap

10 sx at Surface

Hole Size
12-1/4"

Surface Csg @ 210'
8-5/8", 24#
Cement to surface 200 sx

Hole Size
7-7/8"
TD 4780'

260 sx 14.0# Cememt from 495' to Surface

200 sx 15.8# Cement from 750' to 495' - Tagged

Cut and recover casing at 750'

100 sx 15.8# Cement from 1,200' to 1,040' - Tag

No tubing in the hole.

CIBP set at 4324' with 2 sx of cement on top

Perfs - Niobrara
4374-4400' 4 spf 105 holes
4569-4606' 2 spf 75 holes

Perfs - Codell
4676-4690'
4 SPF, 56 Shots
Frac 1500 gal 7.5% HCl
1640 bbl KCl gel fluid and 220,000# 20/40 sand

Prod Csg @ 4,784'
5-1/2", 15.5#
550 sx cement TOC = 2,600' (State and CBL)